


HARMONY SCHOOL SURVEY
 S. E. CORNER LOT 20
 TOWNSHIP 10N RANGE 5W
 SALT CREEK TOWNSHIP
 HOLMES COUNTY, OHIO
 COMPLETED DEC., 1969



○ Pin Set
 ⊕ Spike Set
 Scale 1"=100'

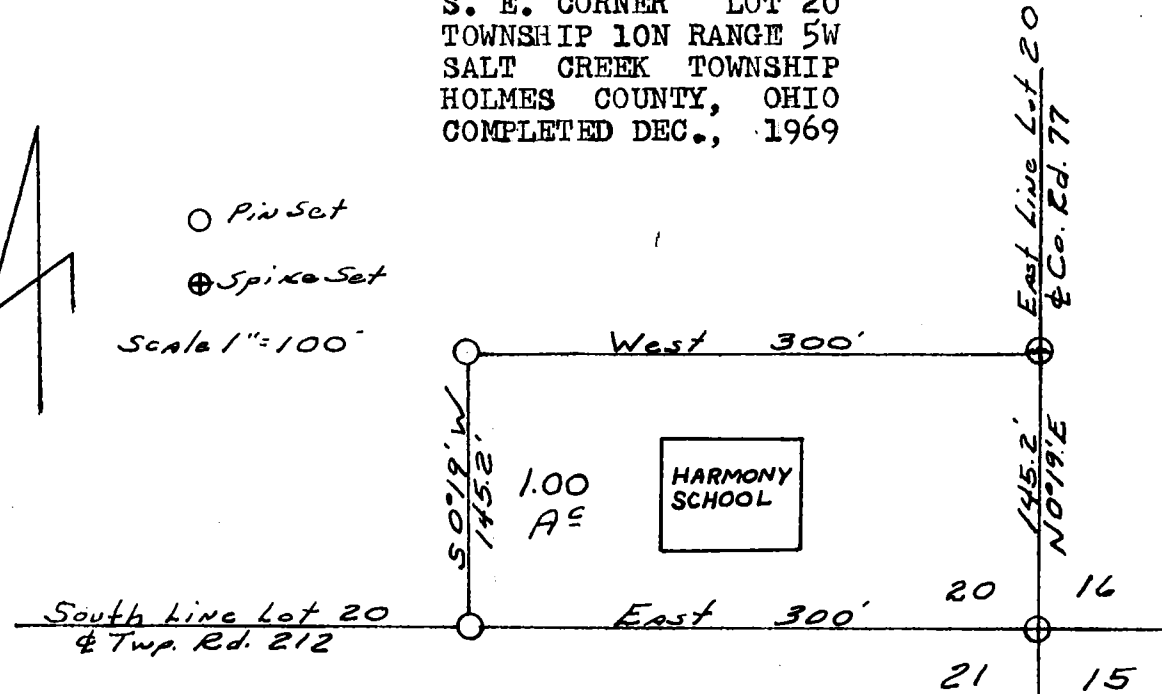

I CERTIFY THIS SURVEY, MADE FOR EZRA Y. MILLER AND THE HARMONY SCHOOL TO BE CORRECT TO THE BEST OF MY KNOWLEDGE AND BELIEF.

SIGNED

William T. Burkey
 WILLIAM T. BURKEY
 REGISTERED SURVEYOR # 5107
 STATE OF OHIO

