




REFERENCES:  
DEED VOL. 276 PAGE 441

BEARINGS BASED ON S.R. 4 P. 345

SALT CREEK TOWNSHIP  
3RD. QTR. LOT 20  
T-10N; R-5W  
HOLMES COUNTY, OHIO  
(SURVEYED FOR: LESTER SCHLABACH)

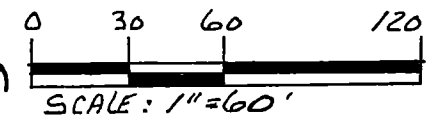

- STONE FOUND
- ▲ R.R. SPIKE FOUND
- IRON PIN FOUND
- 5/8" REBAR WITH I.D. CAP SET I.D. CAP MARKED "BAKER 6938"

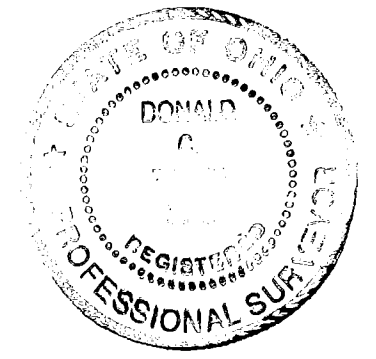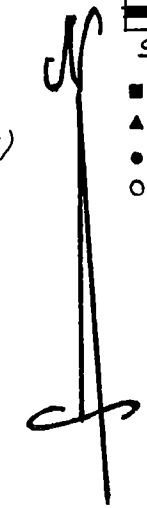

I CERTIFY THIS SURVEY TO BE  
CORRECT TO THE BEST OF MY  
KNOWLEDGE.

Donald C. Baker  
DONALD C. BAKER P.S. 6938  
138 N. CLAY ST.  
MILLERSBURG OHIO 44654  
PH. (330) 674-4788  
FEBRUARY 27, 1998

#10198-M.L. DAVIS  
F.C.C. - J.D. DARR

