


THE COSHOCTON LAND SURVEYING SERVICE
 133 S. FOURTH ST.
 COSHOCTON, OHIO 43812

BEING PART OF: LOT 11
 SEC. 2
 QUAR. 4th
 T10N, R6W U.S.M.L.
 TOWNSHIP SALT CREEK
 COUNTY HOLMES

SURVEY FOR: Daniel Stiener
 DATE: June 12, 1975
 SCALE: 1" = 100'

BEING A PART OF TRACT 1
 AS FOUND IN V. 182, P. 911 -
 LANDS OF LEVI J. RABER

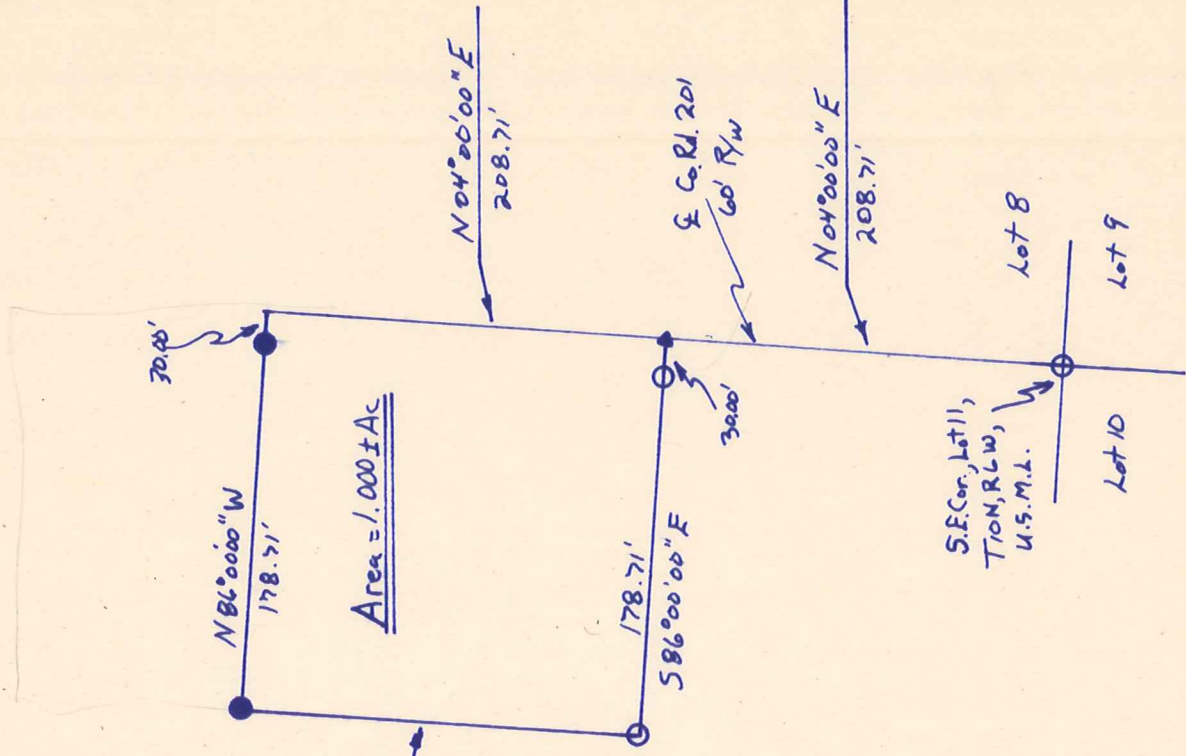

Area = 1.000 ± AC

- - Found Iron Pin
- - Set Iron Pin
- ▲ - P.K Nail Found

I hereby certify the above plat to be correct to the best of my knowledge and belief.

THE COSHOCTON LAND SURVEYING SERVICE

[Signature]
 REGISTERED SURVEYOR 5935