


Granite Rock found
at N.W. crn'r Lot
11, 4th Qtr. T10N
R6W

Lot
15

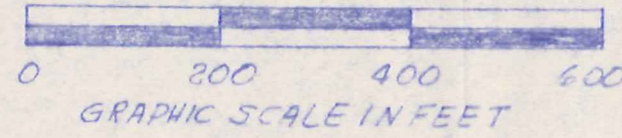


Known as part of Lot 11, 4th
Qtr, T10N, R6W, of Salt
Creek Twp, Hol. Co, Ohio.
Robert L. Kasner P.S. 5193
P.E. 28820
8/22/83

Lot 11

V189P211

N4°01'59"E 1617.00' V189P211
1304.50'

IP(set) near
crn'r post

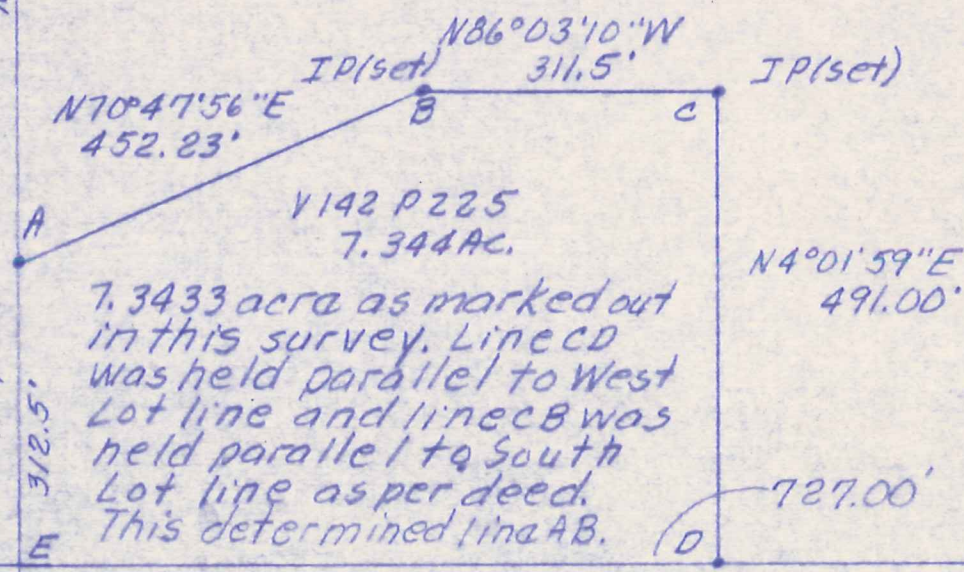

V142 P225
7.344 AC.

7.3433 acra as marked out
in this survey. Line CD
was held parallel to West
Lot line and line CB was
held parallel to South
Lot line as per deed.
This determined line AB.

N4°01'59"E
491.00'

727.00'

1741.91'

Lot
16

Lot crn'r
marked out.

Lot 10

IP(set)

S86°03'10"E 2,677.62' V189P211

Lines were established by intersecting
arc lengths equal to lengths shown
on V189P211 from S.E. & N.W. Lot crn'rs.

IP is 0.19' North of
Lot Line
IP(set) 1974 in
CR 201 at S.E.
crn'r Lot 11
IP(set) 1974



MAP OFFICE COPY