




SALT CREEK TOWNSHIP
 4TH. QTR. LOT 13
 T-10 N; R-6 W
 HOLMES COUNTY, OHIO



- IRON PIN FOUND
- 5/8" REBAR WITH I.D. CAP SET
- I.D. CAP MARKED "BAKER 6938"

REFERENCES:

DEED VOL. 192 PAGE 673
 DEED VOL. 214 PAGE 531
 PLAT VOL. 7 PAGE 553
 BEARINGS FROM SAME

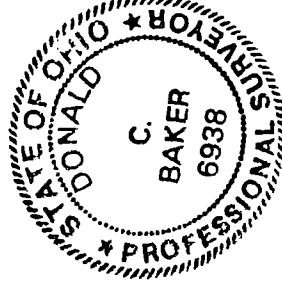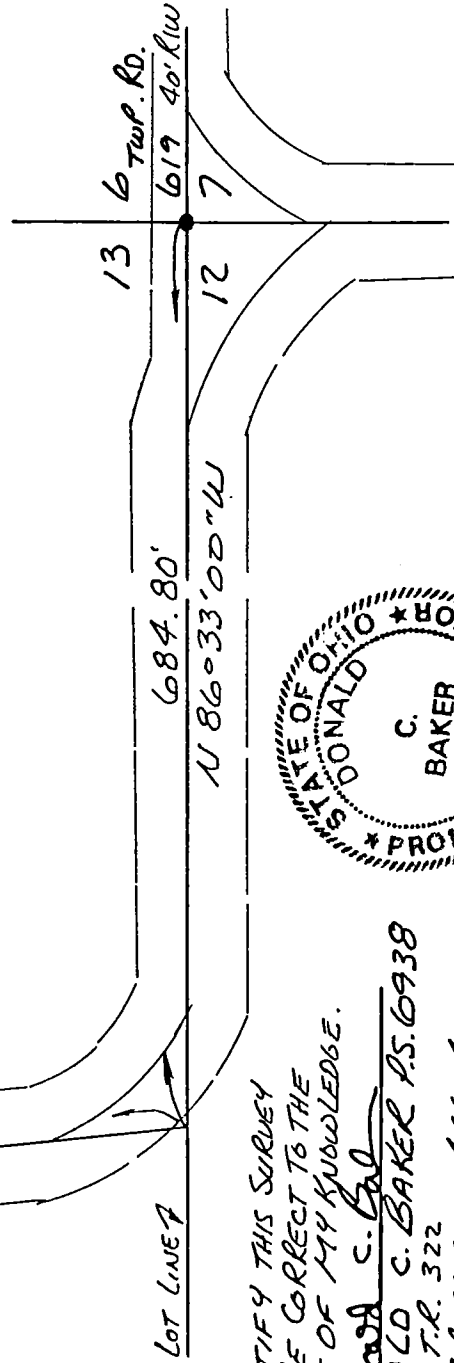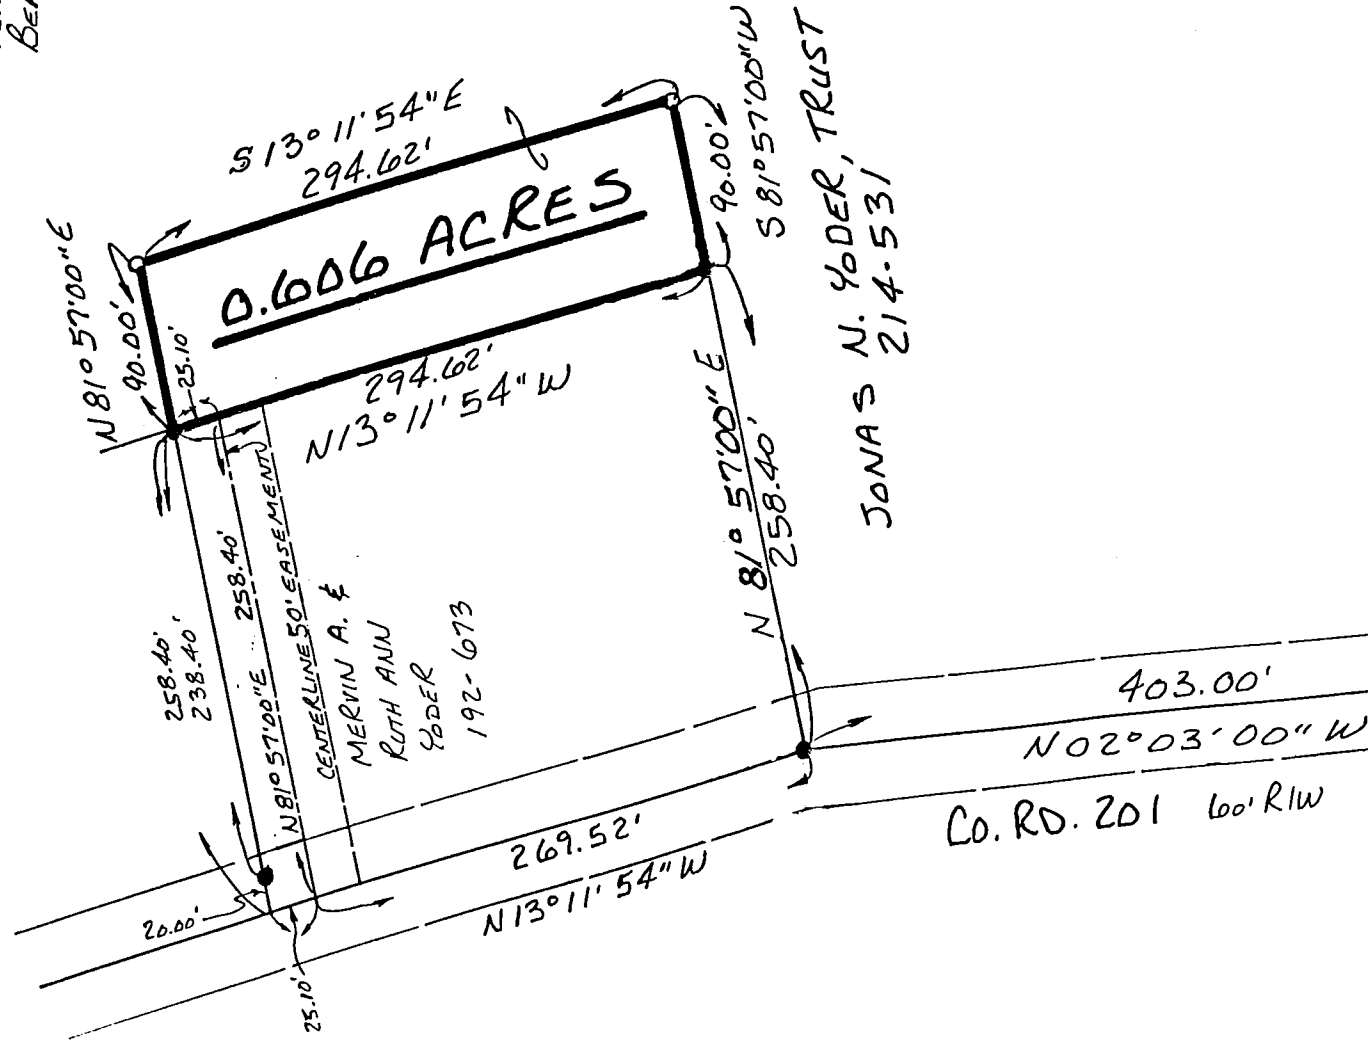

I CERTIFY THIS SURVEY
 TO BE CORRECT TO THE
 BEST OF MY KNOWLEDGE.

Donald C. Baker
 DONALD C. BAKER P.S. 6938
 5938 T.R. 322
 MILLESBURGH, OHIO 44654
 PH. (216)-674-4788
 SEPT. 20, 1994

52594-MLS
 (REMOVED OCTOBER 5, 1994 ADDED EASEMENT)
 (REMOVED OCTOBER 13, 1994 MOVED EASEMENT)