VILLAGE OF BENTON
LOT 13
HOLMES COUNTY, OHIO

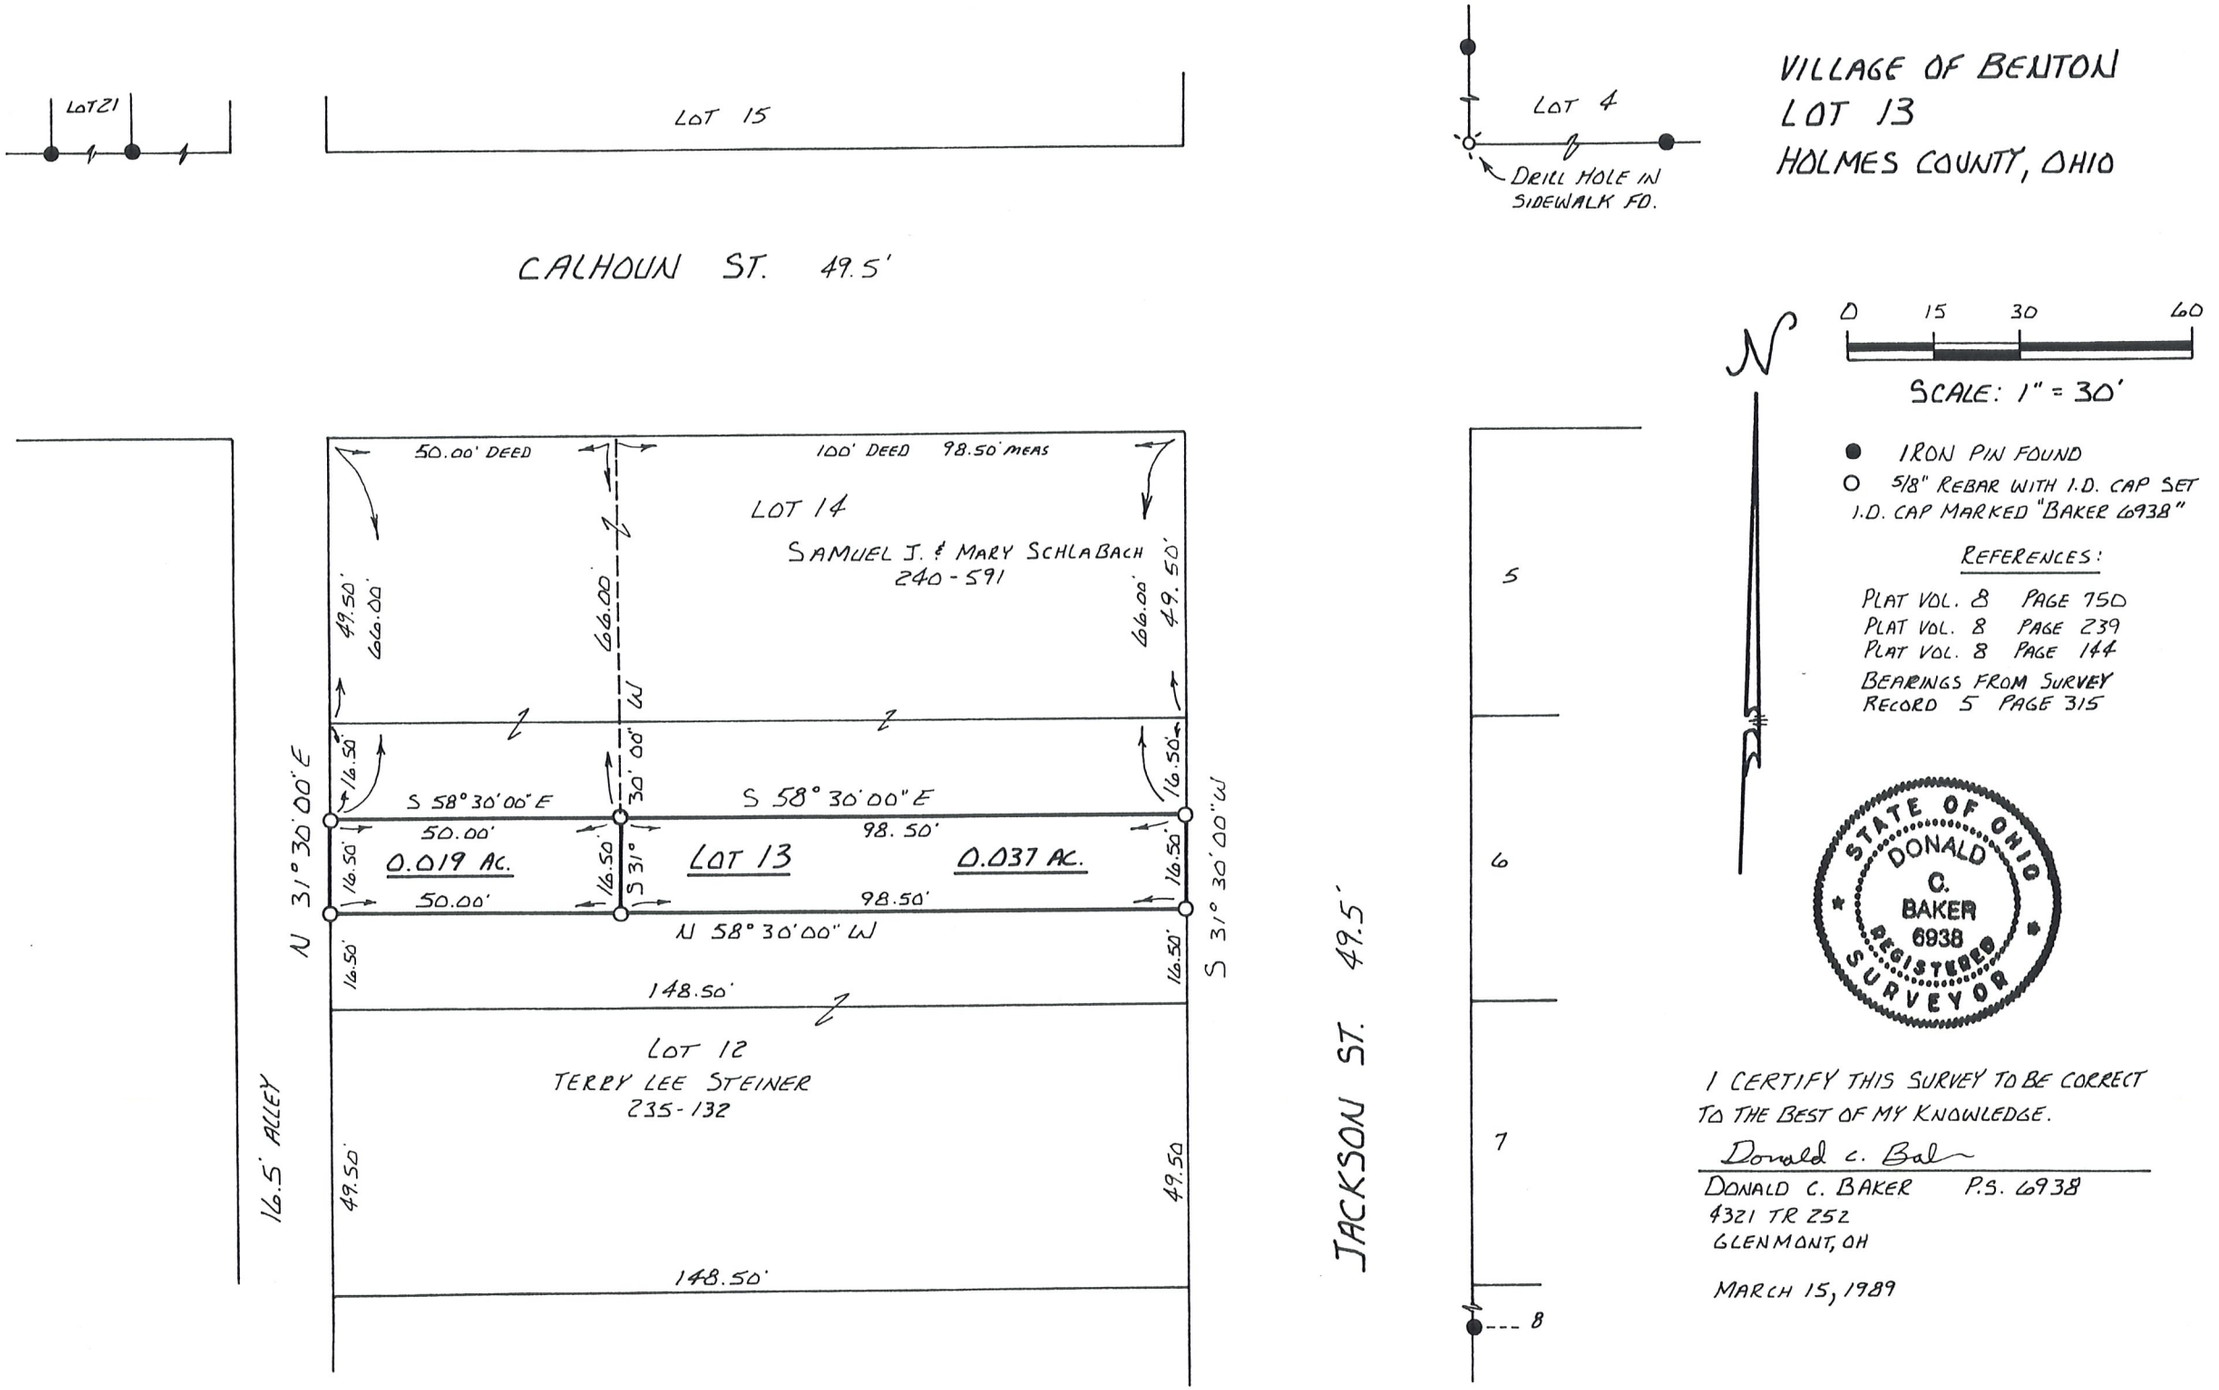

- IRON PIN FOUND
- ○ 5/8" REBAR WITH I.D. CAP SET
  I.D. CAP MARKED "BAKER 6938"

REFERENCES:

PLAT VOL. 8 PAGE 750
PLAT VOL. 8 PAGE 239
PLAT VOL. 8 PAGE 144
BEARINGS FROM SURVEY RECORD 5 PAGE 315

STATE OF OHIO
DONALD C. BAKER
6938
REGISTERED SURVEYOR

I CERTIFY THIS SURVEY TO BE CORRECT TO THE BEST OF MY KNOWLEDGE.

Donald C. Baker

DONALD C. BAKER P.S. 6938
4321 TR 252
GLENMONT, OH

MARCH 15, 1989