



SALT CREEK TOWNSHIP  
 N. W. QTR. SECTION 2  
 T-14N ; R-12W  
 HOLMES COUNTY, OHIO

BEARINGS FROM PLAT VOL. 5 Pg. 17

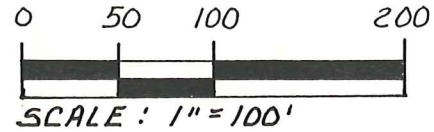

- IRON PIN FOUND
- ▲ R. R. SPIKE FOUND
- STONE FOUND
- 5/8" REBAR WITH I. D. CAP SET.  
I. D. CAP MARKED "BAKER 6938."
- ⊗ P. K. NAIL SET.

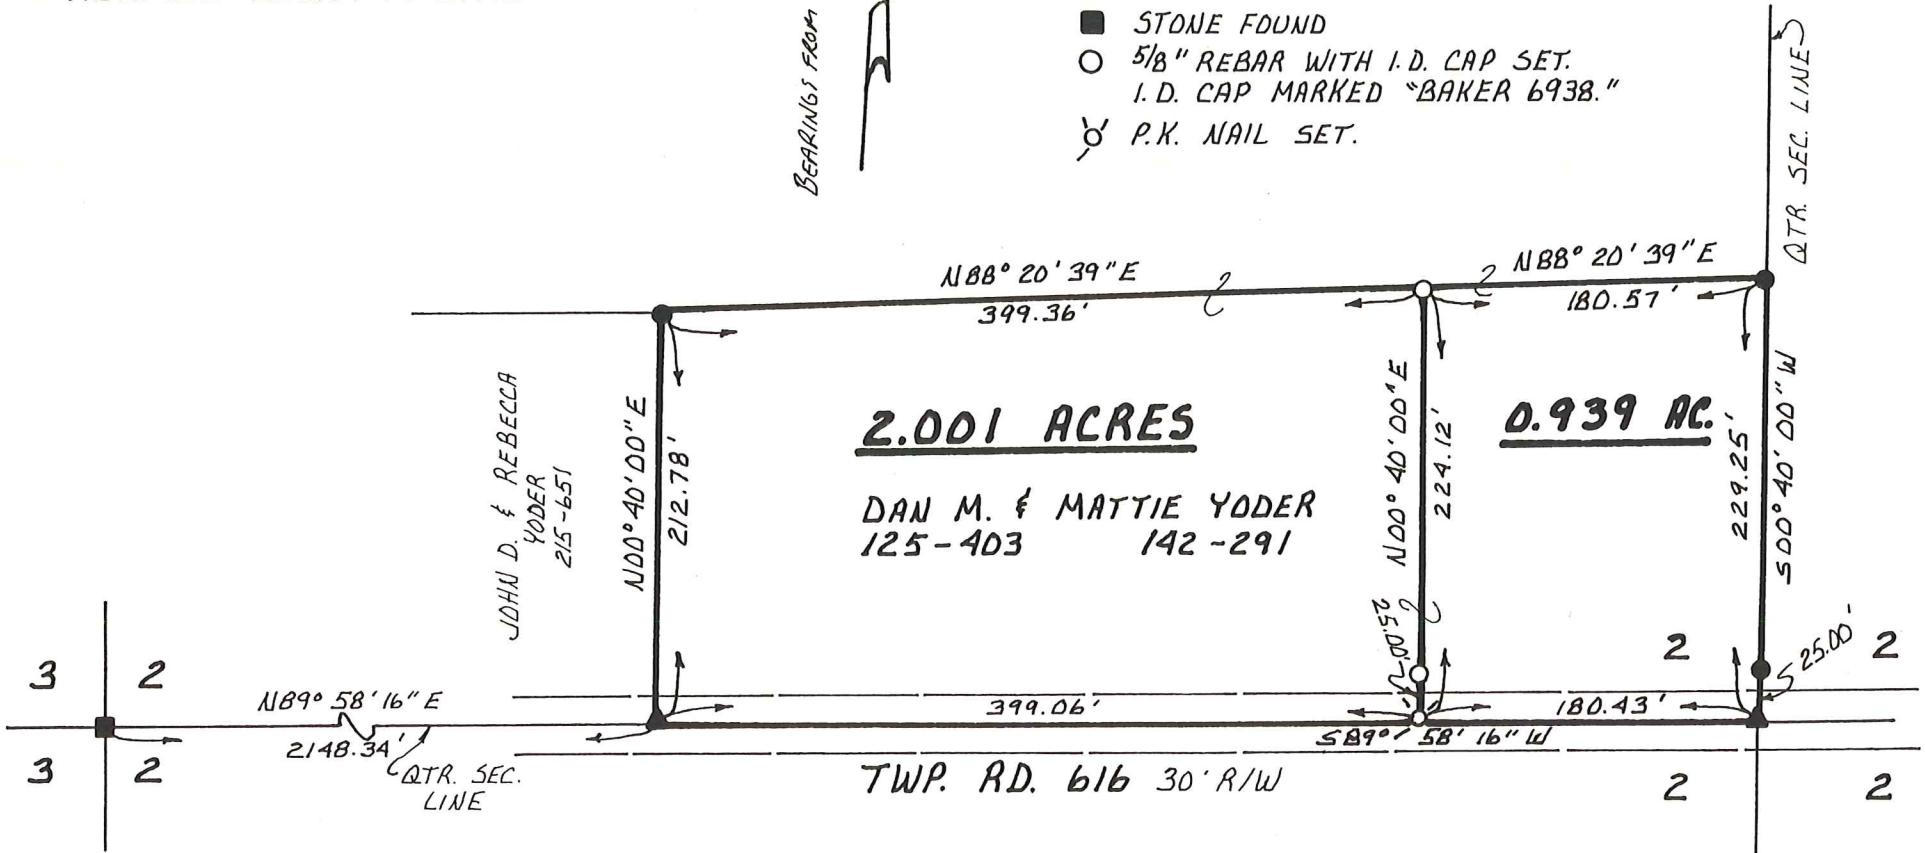

I CERTIFY THIS SURVEY TO BE CORRECT  
 TO THE BEST OF MY KNOWLEDGE.

*Donald C Baker*  
 DONALD C. BAKER P.S. 6938  
 595B T. R. 322  
 MILLERSBURG, OHIO 44654  
 PH: (216) 674-4788

FEBRUARY 16, 1994

B394 - BEC



REFERENCES:

- DEED VOL. 125 PAGE 403
- DEED VOL. 142 PAGE 291
- DEED VOL. 215 PAGE 651
- PLAT VOL. 8 PAGE B36