

SALT CREEK TOWNSHIP
 S.E. QTR. SECTION 5
 T-14N; R-12W
 HOLMES COUNTY, OHIO

RESURVEY OF DEED VOL. 219 PAGE 812



SCALE: 1"=100'


- IRON PIN FOUND
- 5/8" RE BAR WITH I.D. CAP SET
- I.D. CAP MARKED "BAKER 6938"

REFERENCES:


DEED VOL 219 PAGE 812
 " " 252 " 958
 " " 212 " 409

PLAT VOL. 8 PAGE 725
 " " 10 " 759

SURVEY RECORD 5 PAGE 143

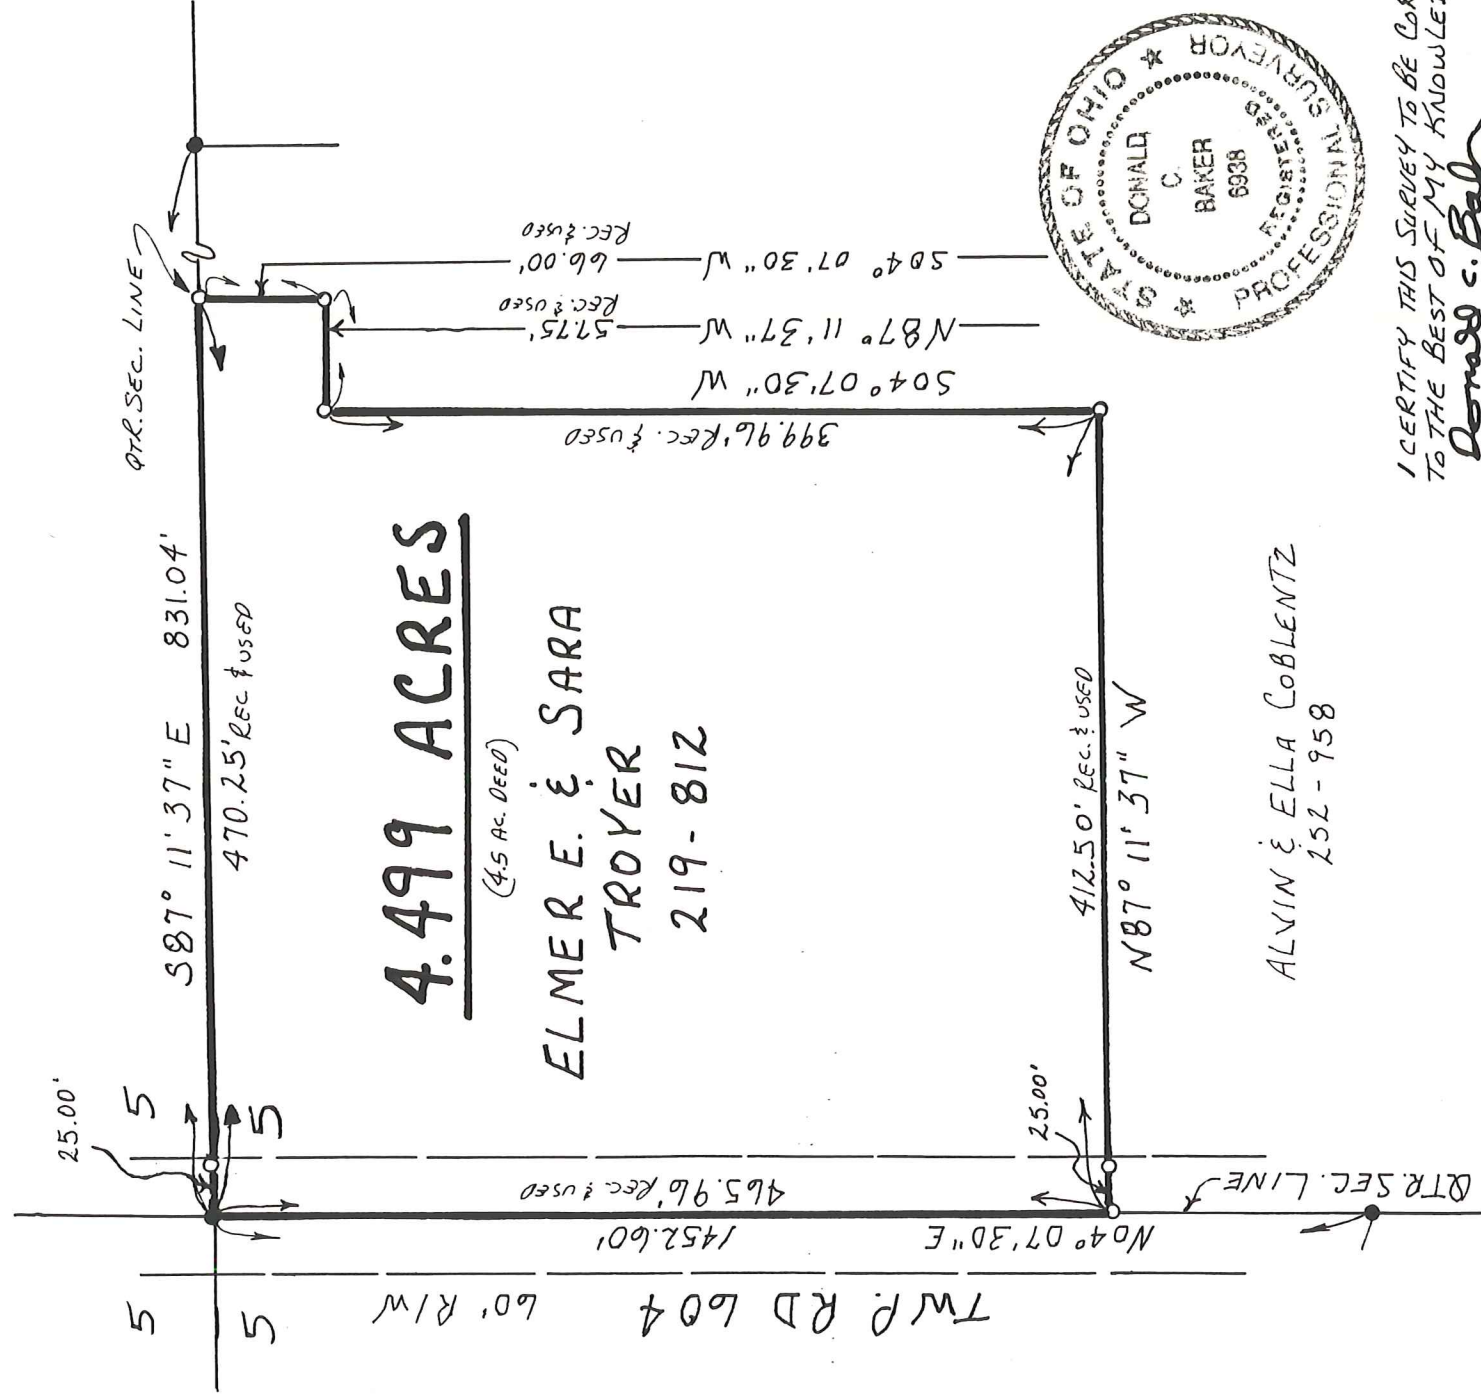

ALVIN & ELLA COBLENTZ
 252 - 958

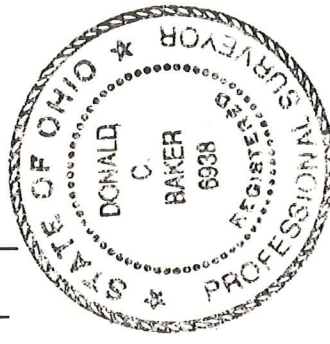

I CERTIFY THIS SURVEY TO BE CORRECT
 TO THE BEST OF MY KNOWLEDGE.

Donald C. Baker

DONALD C. BAKER P.S. 6938

5958 T.R. 322
 MILLERSBURG, OHIO 44654
 PH. (330) 674-4788

APRIL 21 1996

16596-SRU/MLS