


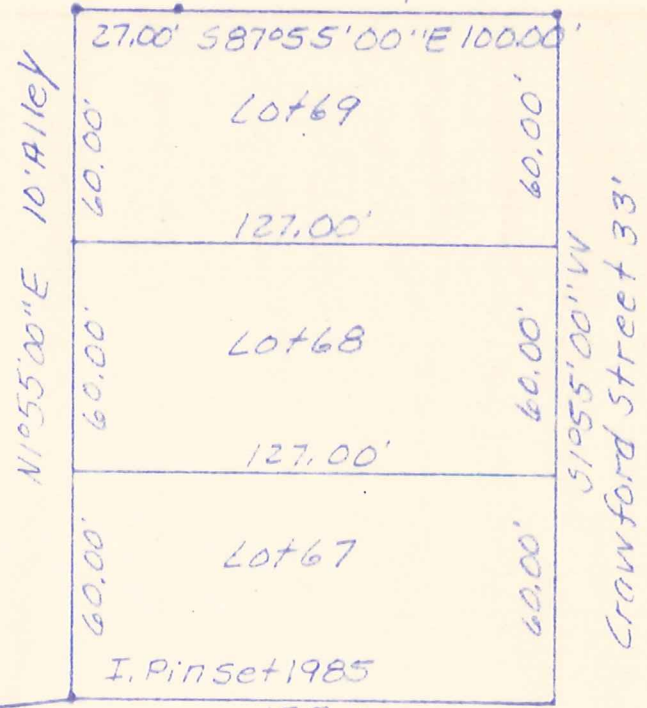

I. Pin Set 1985
10' Alley



I. Pin F'd 1985

I. Pipe F'd 1985


I. Pin Set 1985

587°02' E
56.1'
R.B. 5 Pg. 161
1972

N 85°24'10\"/>

127.00'
587°55'00\"/>

81.47'
Calculated

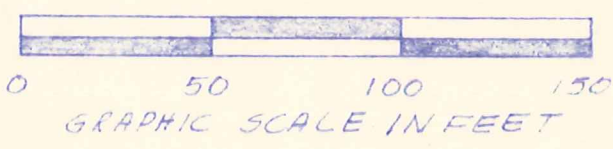

PLAT OF SURVEY OF
Lots 67, 68, & 69 in
MOUNT HOPE
Known as part of Sec. 12,
Twp. 14 N., R. 12 W. of
Salt Creek Twp., Hol. Co.,
Ohio.

Robert L. Kasner P.S. 5193
P.E. 28820
8/12/85

MAP OFFICE COPY