PROPERTY LINE SURVEY

(NOT TO BE RECORDED)

SALT CREEK TOWNSHIP
N.W. & S.W. QTRS. SECTION 28
T–15 N; R–12 W
HOLMES COUNTY, OHIO

SURVEYED FOR: ANDY SHAW

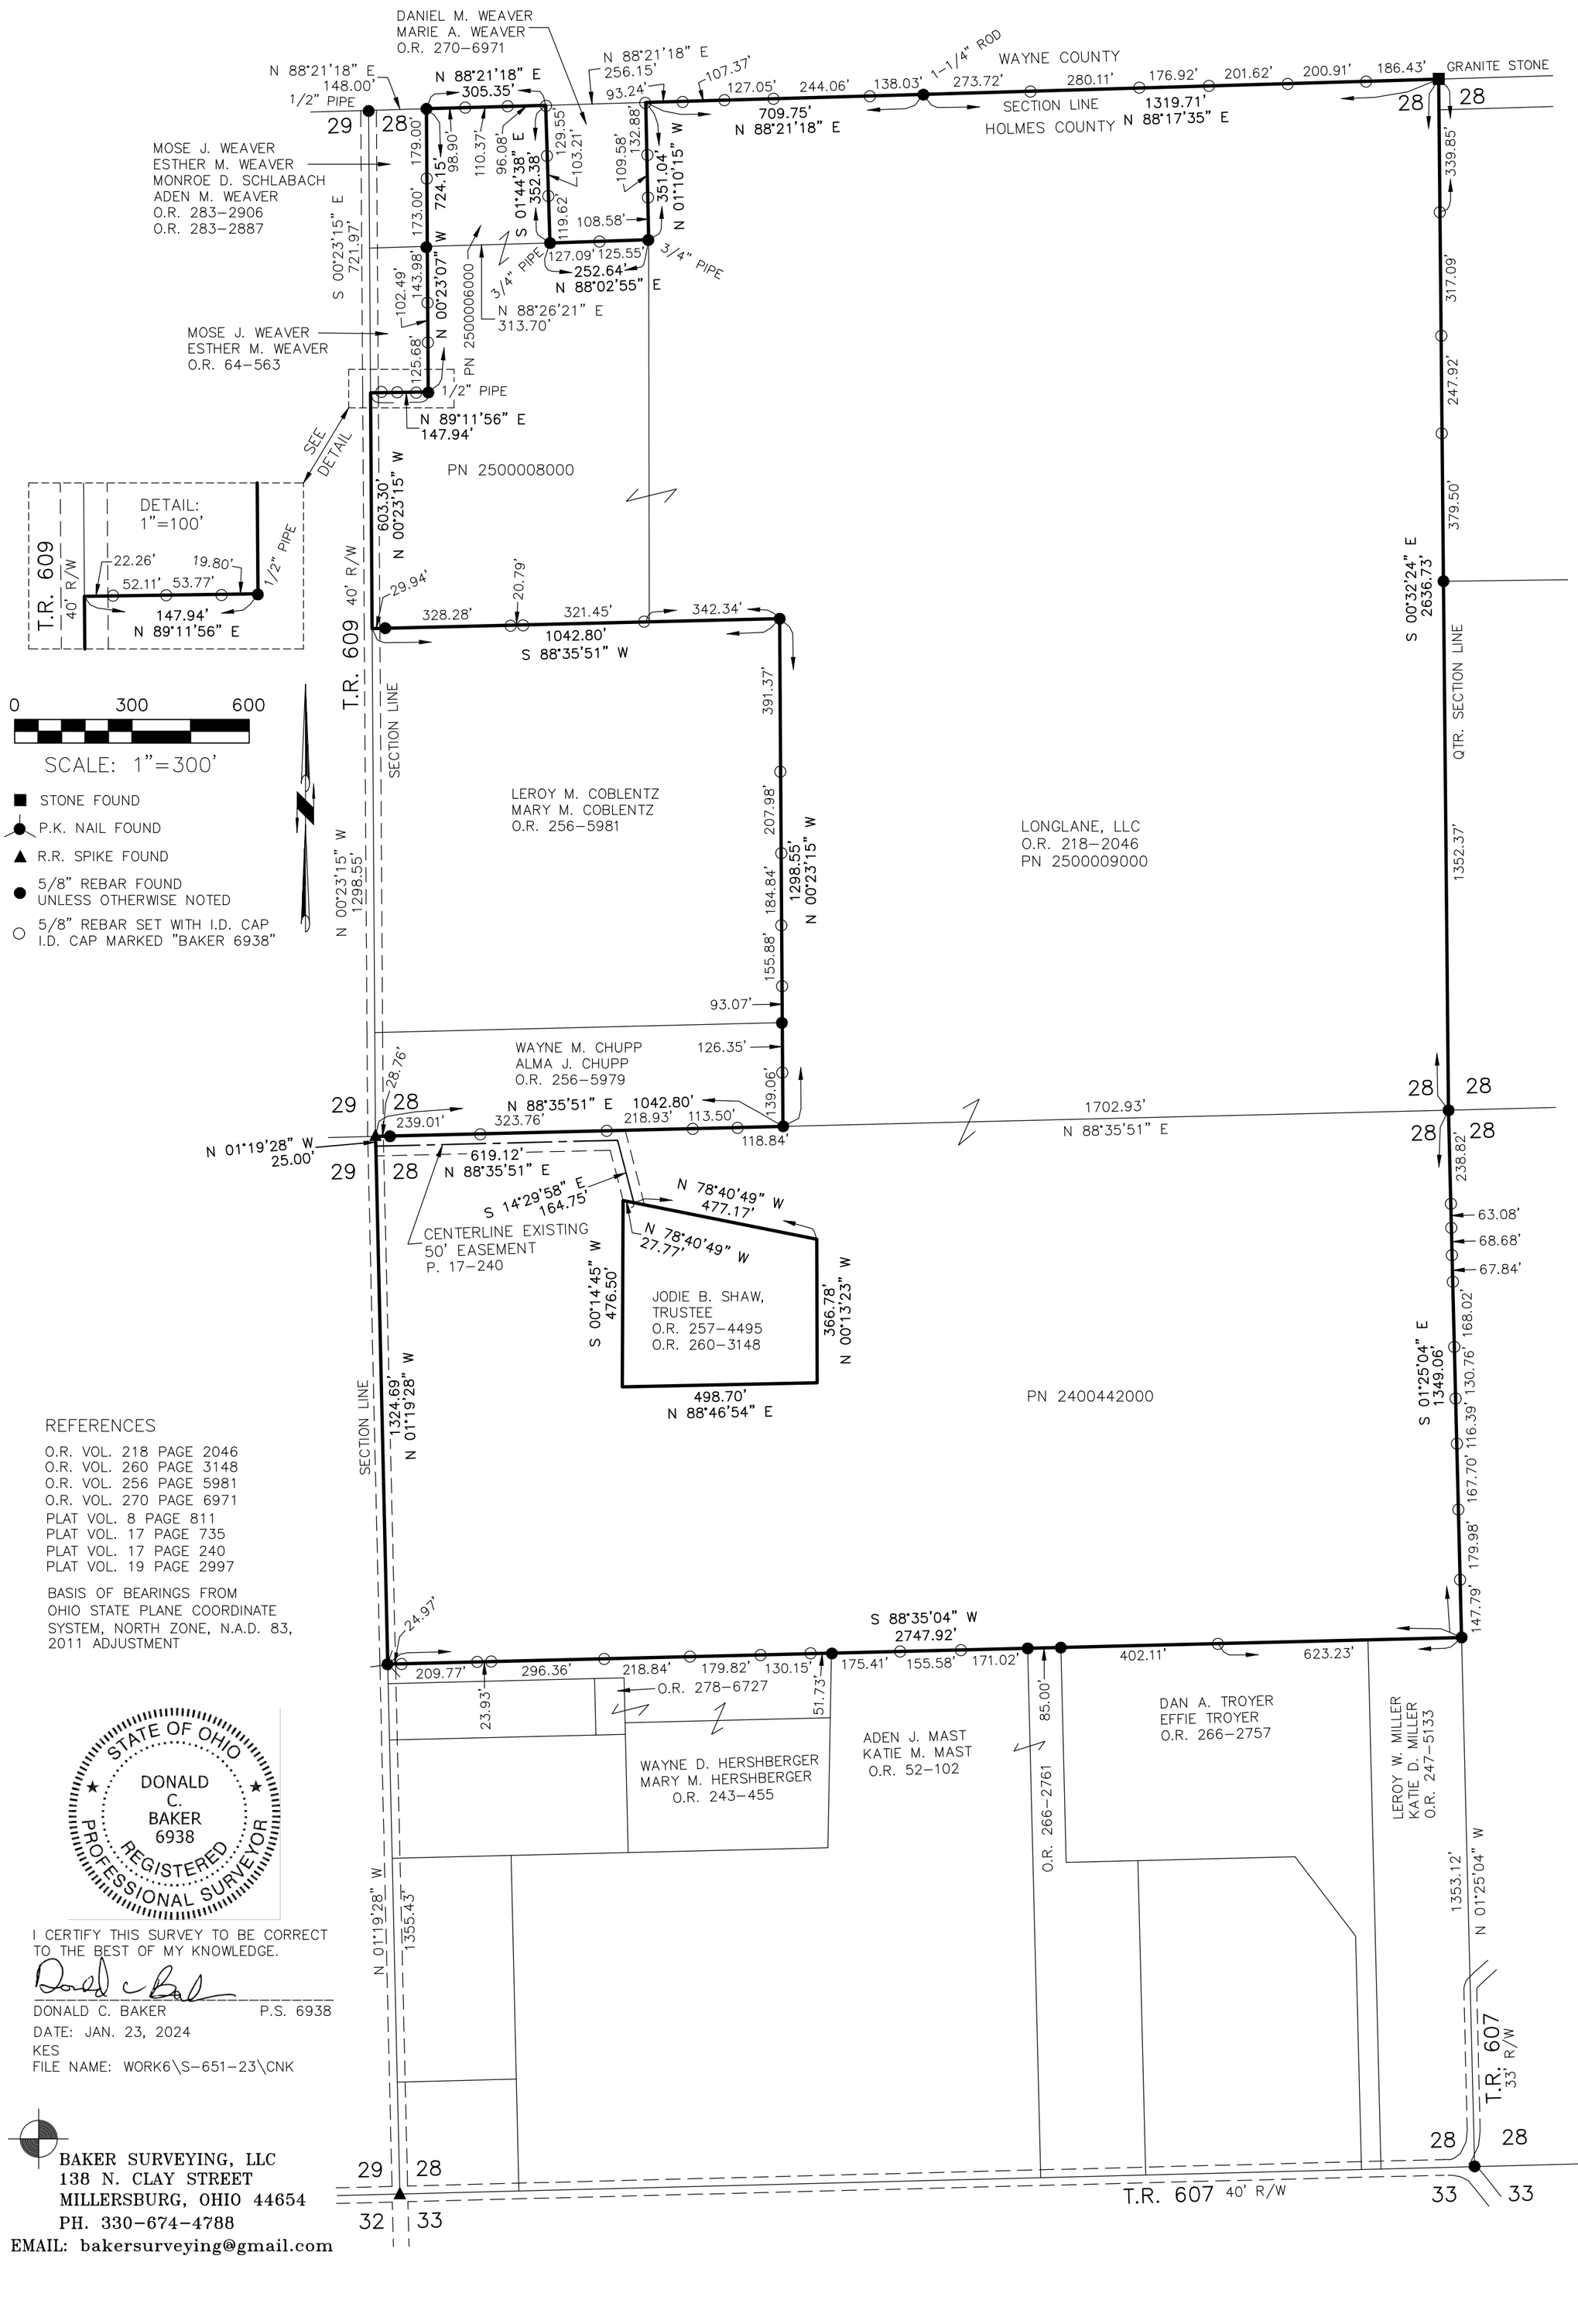

REFERENCES

O.R. VOL. 218 PAGE 2046
O.R. VOL. 260 PAGE 3148
O.R. VOL. 256 PAGE 5981
O.R. VOL. 270 PAGE 6971
PLAT VOL. 8 PAGE 811
PLAT VOL. 17 PAGE 735
PLAT VOL. 17 PAGE 240
PLAT VOL. 19 PAGE 2997

BASIS OF BEARINGS FROM OHIO STATE PLANE COORDINATE SYSTEM, NORTH ZONE, N.A.D. 83, 2011 ADJUSTMENT

STATE OF OHIO
DONALD C. BAKER 6938
REGISTERED PROFESSIONAL SURVEYOR

I CERTIFY THIS SURVEY TO BE CORRECT TO THE BEST OF MY KNOWLEDGE.

DONALD C. BAKER P.S. 6938

DATE: JAN. 23, 2024
KES
FILE NAME: WORK6\S–651–23\CNK

BAKER SURVEYING, LLC
138 N. CLAY STREET
MILLERSBURG, OHIO 44654
PH. 330–674–4788
EMAIL: bakersurveying@gmail.com