


WALNUT CREEK TOWNSHIP  
 N.W. QTR. SECTION 1  
 T-8N; R-5W  
 HOLMES COUNTY, OHIO

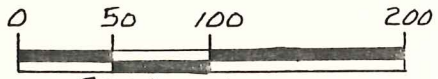


SCALE: 1" = 100'

- STONE FOUND
- IRON PIN FOUND
- 5/8" RE BAR WITH I.D. CAP SET  
I.D. CAP MARKED "BAKER 6938"

REFERENCES:

- PLAT Vol. 11 PAGE 150
- PLAT Vol. 11 PAGE 139
- PLAT Vol. 11 PAGE 146
- DEED Vol. 234 PAGE 413
- DEED Vol. 251 PAGE 637
- PLAT Vol. 12 PAGE 20

BEARINGS FROM DEED Vol. 251 PAGE 637

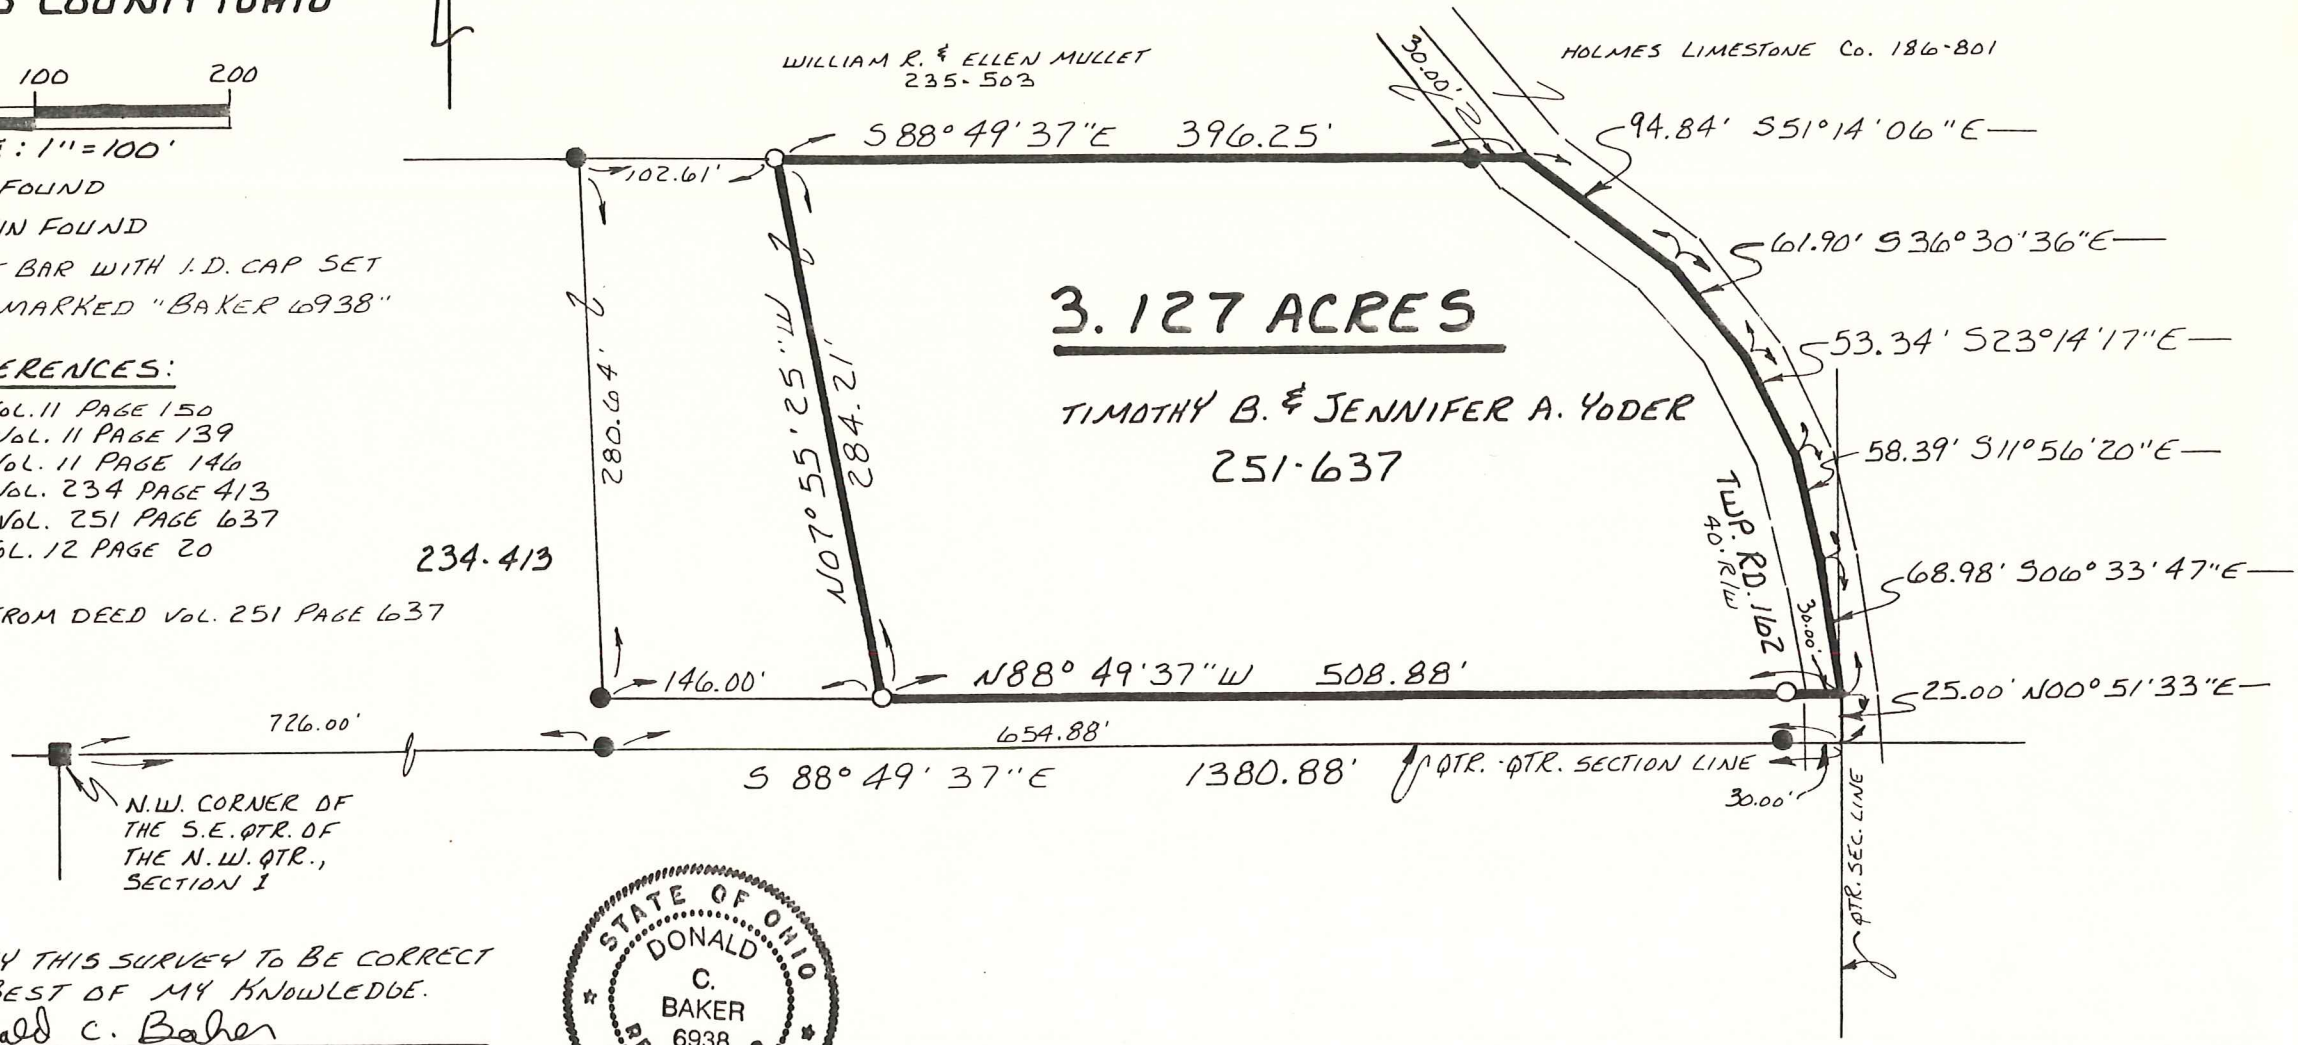

**3.127 ACRES**

TIMOTHY B. & JENNIFER A. YODER  
 251-637

WILLIAM R. & ELLEN MULLET  
 235-503

HOLMES LIMESTONE Co. 186-801

234.413

N.W. CORNER OF  
 THE S.E. QTR. OF  
 THE N.W. QTR.,  
 SECTION 1



I CERTIFY THIS SURVEY TO BE CORRECT  
 TO THE BEST OF MY KNOWLEDGE.  
Donald C. Baker  
 DONALD C. BAKER P.S. 6938  
 4321 T. R. 252  
 GLENMONT, OHIO 44628  
 SEPTEMBER 11, 1991