

REFERENCES:

DEED Vol. 234 PAGE 677  
 " " 242 " 311

O.R. Vol. 12 PAGE 220

BEARINGS FROM DEED Vol. 234 PAGE 677


WALNUT CREEK TOWNSHIP  
 S.W. QTR. SECTION 6  
 T. 9N; R. 4W  
 HOLMES COUNTY, OHIO  
 (SURVEYED FOR: ATLEE MILLER)

0 50 100 200



SCALE: 1" = 100'

- STONE FOUND
- 5/8" RE BAR WITH A.D. CAP SET  
I.D. CAP MARKED "BAKER 6938"

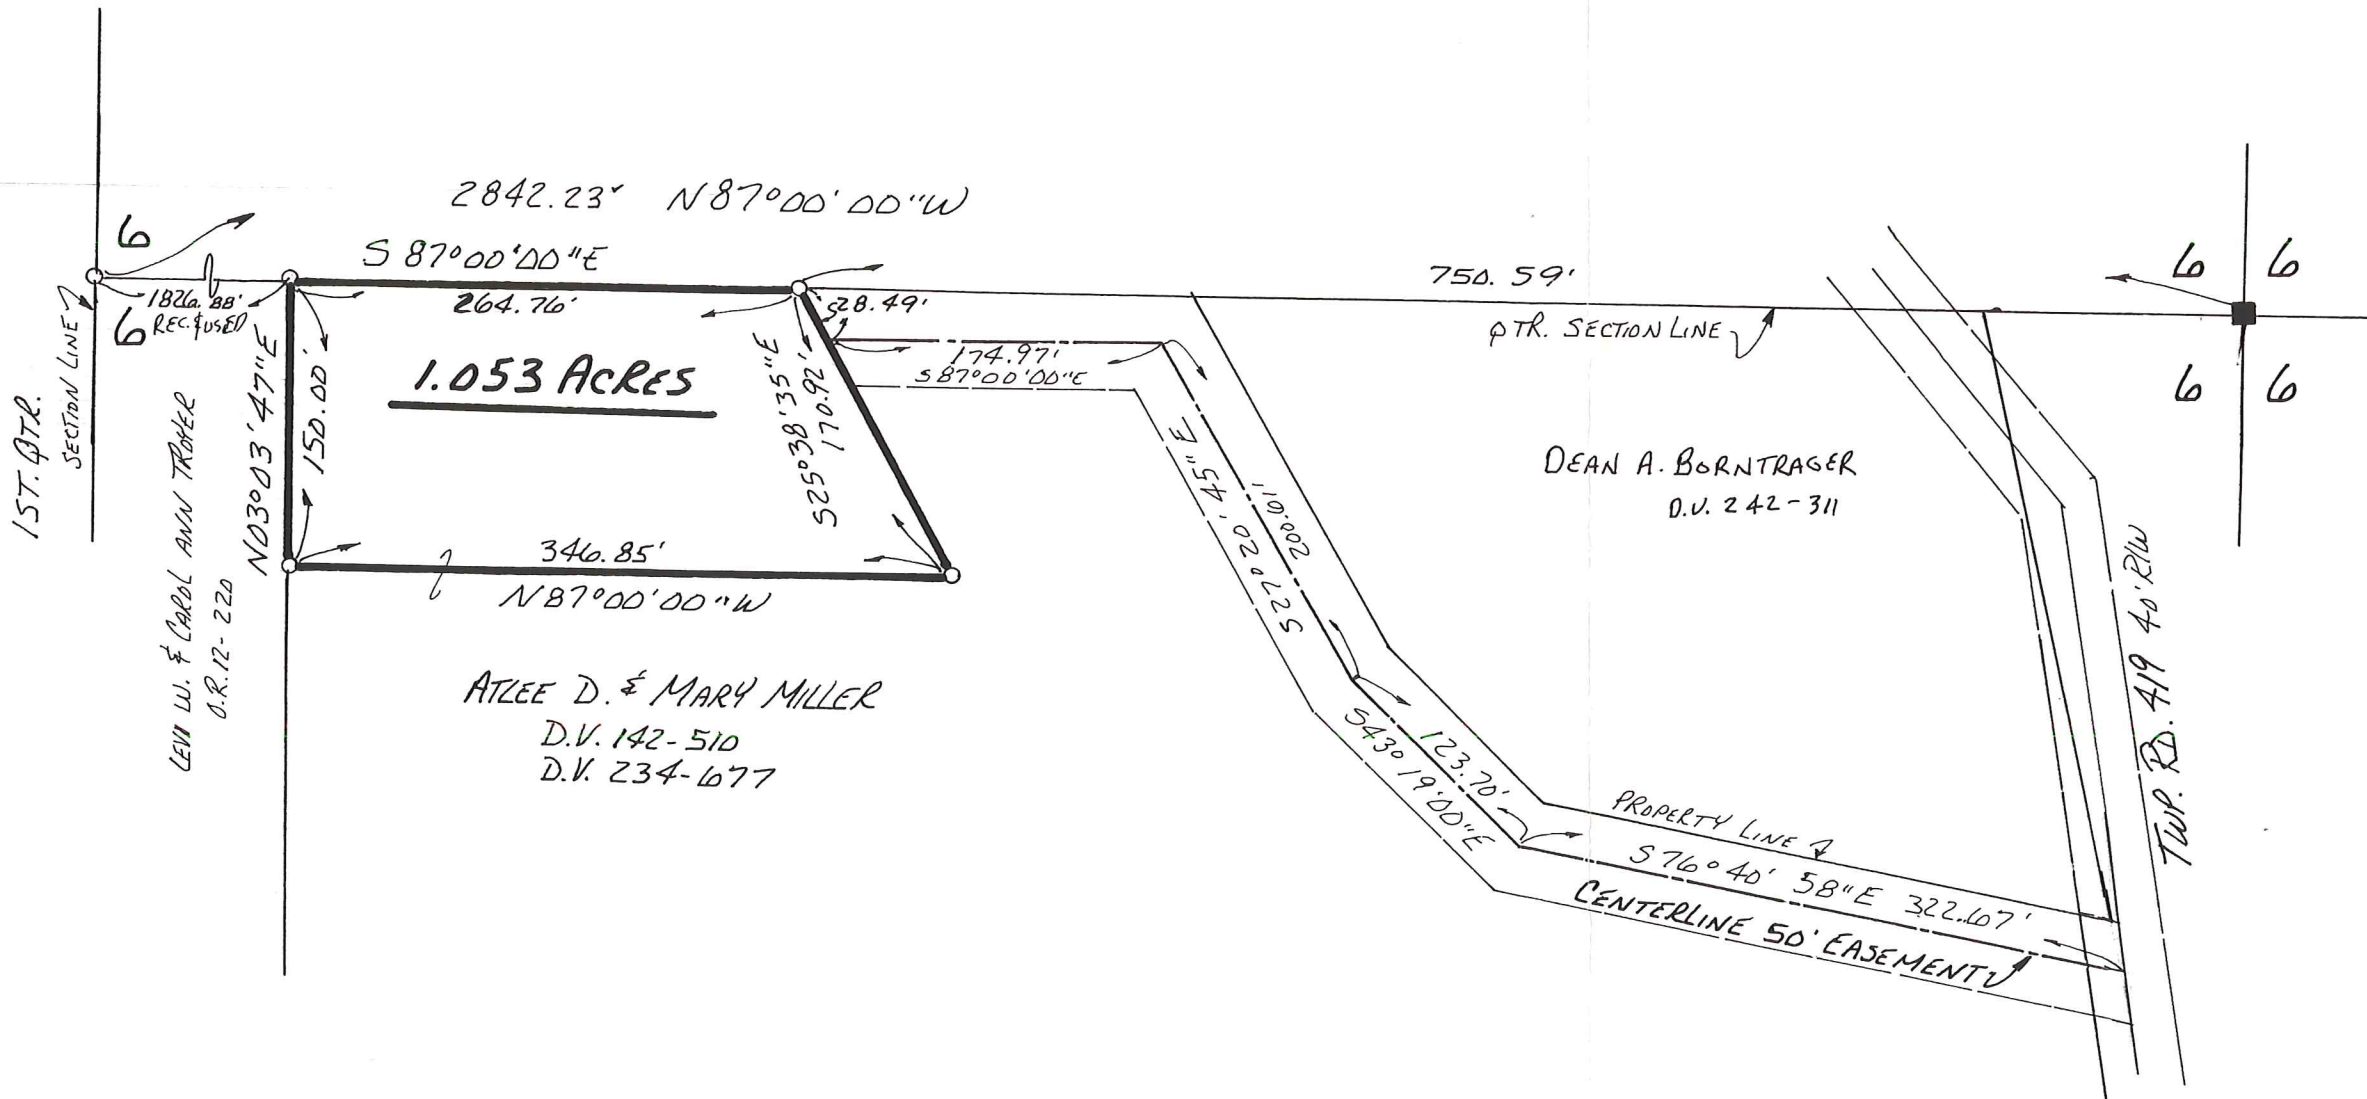

RECEIVED

JAN 12 2000

Hol. Co. Tax Map Office

I CERTIFY THIS SURVEY TO BE CORRECT  
 TO THE BEST OF MY KNOWLEDGE.

JAMIE D. DARR P.S. 7755

DONALD C. BAKER SURVEYING  
 138 N. CLAY ST.

MILLERSBURG, OHIO 44654

PH. (330) 674-4788

JANUARY 10, 2000

#81899- M.L. DAVIS  
 F.C.C.-J.D. DARR