

0 300 600

SCALE: 1"=300'

■ STONE FOUND

● 5/8" REBAR FOUND
UNLESS OTHERWISE NOTED

○ 5/8" REBAR SET WITH I.D. CAP
I.D. CAP MARKED "BAKER
SURVEYING LLC"


BASIS OF BEARINGS FROM OHIO STATE PLANE
COORDINATE SYSTEM, NORTH ZONE,
N.A.D. 83, 2011 ADJUSTMENT

WALNUT CREEK TOWNSHIP
S.E. & S.W. QTRS. SECTION 4
N.E. & N.W. QTRS. SECTION 7
T-9 N; R-4 W
HOLMES COUNTY, OHIO

SURVEYED FOR: DAVID TROYER

REFERENCES

DEED VOL. 230 PAGE 450
O.R. VOL. 268 PAGE 2673
PLAT VOL. 16 PAGE 113
PLAT VOL. 19 PAGE 4171
PLAT VOL. 19 PAGE 688
PLAT VOL. 19 PAGE 747
PLAT VOL. 19 PAGE 3124
PLAT VOL. 19 PAGE 5348

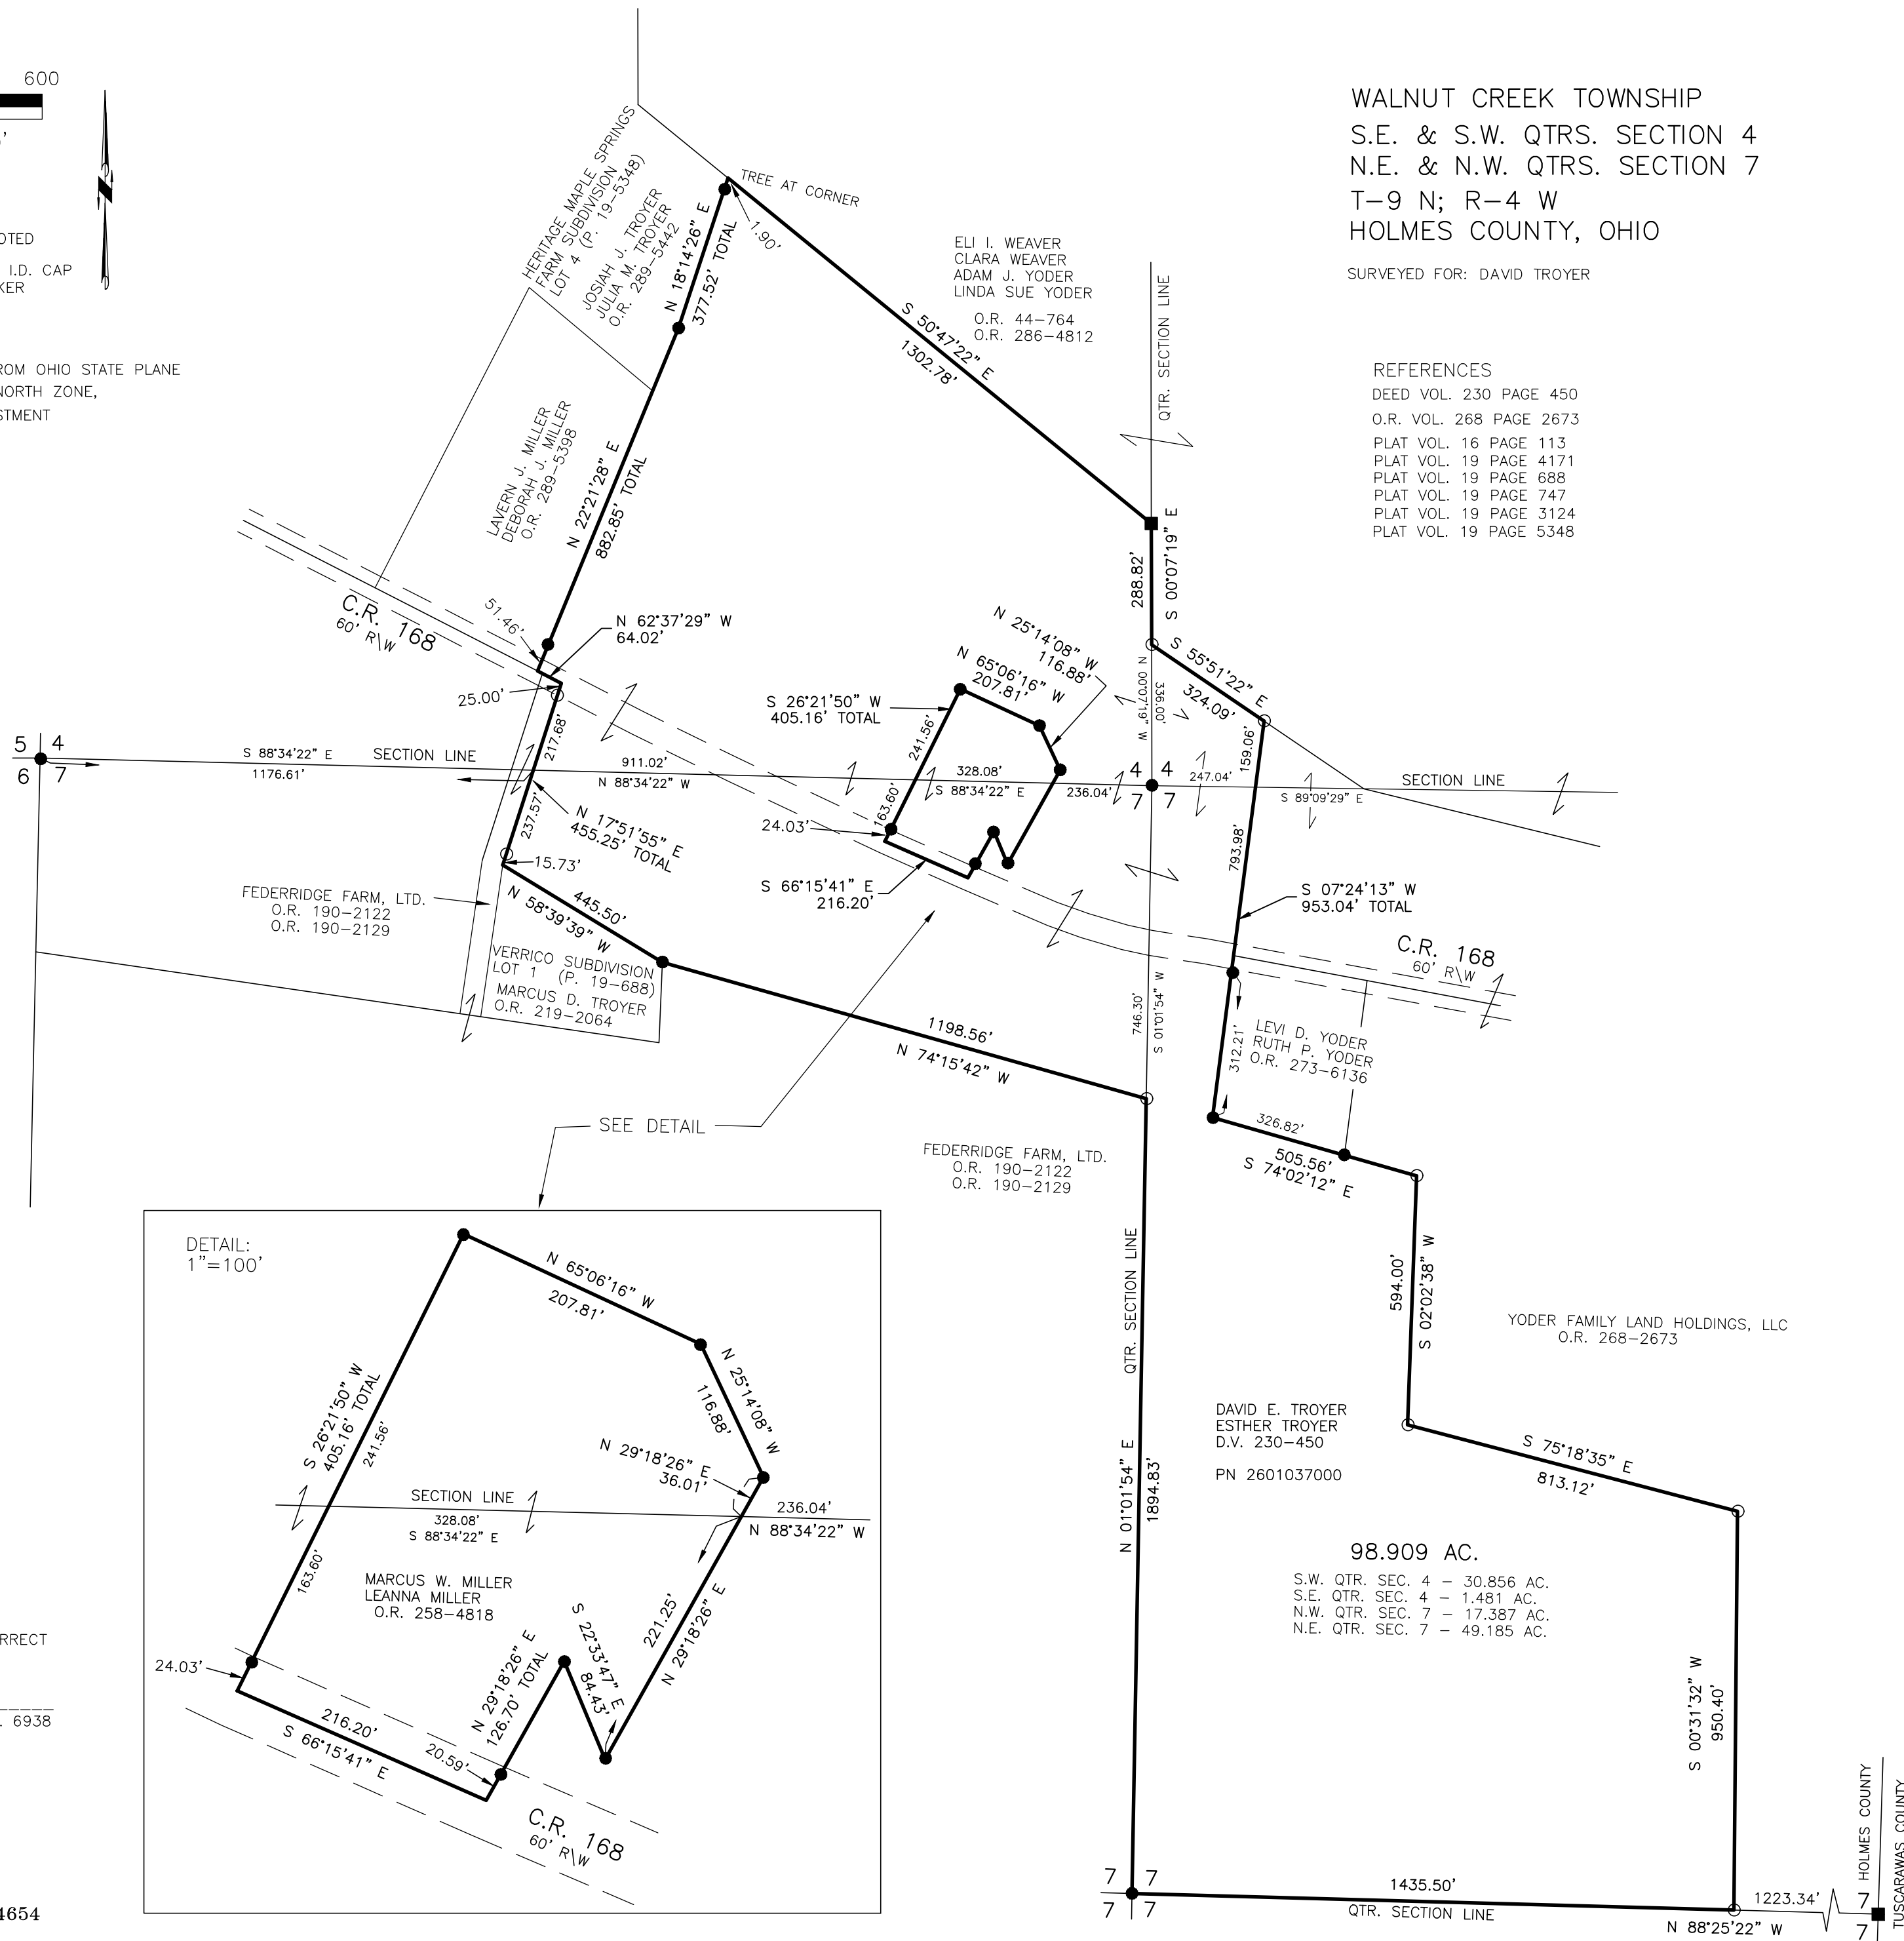

I CERTIFY THIS SURVEY TO BE CORRECT
TO THE BEST OF MY KNOWLEDGE.

DONALD C. BAKER P.S. 6938
DATE: JAN. 19, 2026
KES
FILE NAME: WORK7\S-26-205



BAKER SURVEYING
138 N. CLAY STREET
MILLERSBURG, OHIO 44654
PH. 330-674-4788

EMAIL: bakersurveying@gmail.com