


WALNUT CREEK TOWNSHIP
 N.W. QTR. SECTION 14
 T-9N; R-4W
 HOLMES COUNTY, OHIO
 (SURVEYED FOR: IVAN TROYER)

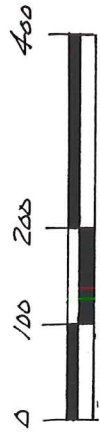

SCALE: 1" = 200'

- ▲ R.R. SPIKE FOUND
- IRON PIN FOUND
- R.R. SPIKE SET
- 5/8" REBAR WITH I.D. CAP SET
- I.D. CAP MARKED "BAKER 6938"

REFERENCES:

DEED VOL. 185 PAGE 565 & 567 & 569
" " 258 " 697
" " 162 " 193
" " 204 " 677
" " 205 " 90
" " 258 " 708
" " 258 " 699
" " 265 " 794

PLAT VOL. 14 PAGE 137

BEARINGS FROM DEEP 265
 Pg. 794

RESURVEY OF A 4.72 AC.
 TRACT (D.V. 185-565) &
 A 7.8 AC. TRACT (D.V.
 162-193) & A 2.3448
 AC. TRACT (D.V. 258-697).




I CERTIFY THIS SURVEY TO BE CORRECT
 TO THE BEST OF MY KNOWLEDGE.

Donald C. Baker
 DONALD C. BAKER P.S. 6938
 DONALD C. BAKER SURVEYING
 138 N. CLAY ST.
 MILLERSBURG, Ohio 44654
 PH. (330) 694-4788

AUGUST 24, 2000

57400 - M.L. DAVIS
 F.C.C. - F. D. BAKER

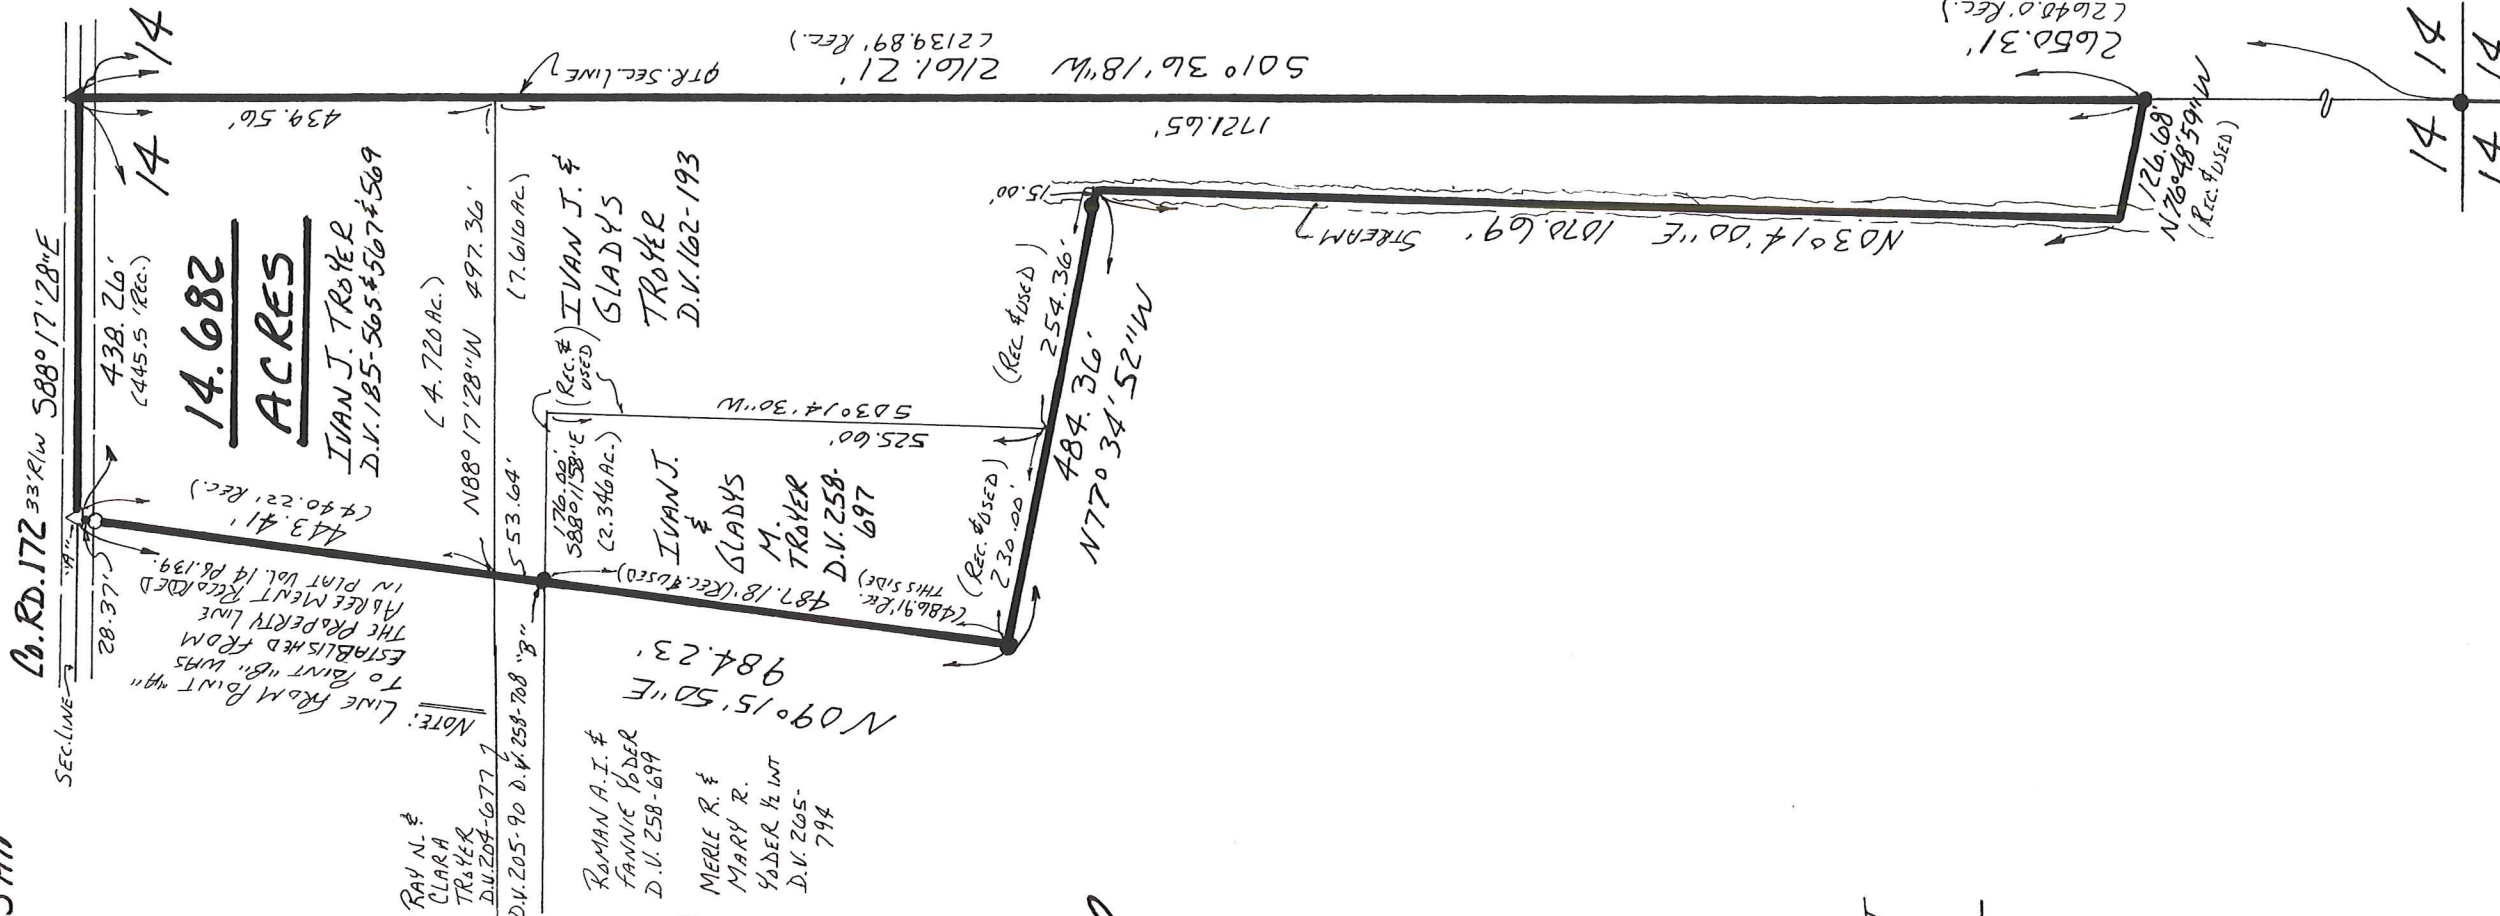

14 14
 14 14