


WALNUT CREEK TOWNSHIP
 N.W. QTR. SECTION 17
 T-9N; R-4W
 HOLMES COUNTY, OHIO
 (SURVEYED FOR: MARVIN & CLARA TROYER)

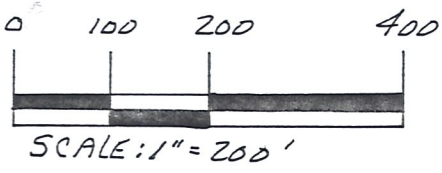


- STONE FOUND
- IRON PIN FOUND
- 5/8" RE BAR WITH I.D. CAP SET I.D. CAP MARKED "BAKER 6938"

REFERENCES:

- DEED VOL. 201 PAGE 161
 " " 236 " 364
 " " 256 " 838
 O.R. VOL. 13 PAGE 414
 PLAT VOL. 16 PAGE 800
 " " 12 " 987
 " " 12 " 673
 " " 10 " 529

BEARINGS FROM PLAT VOL. 16 PAGE 800

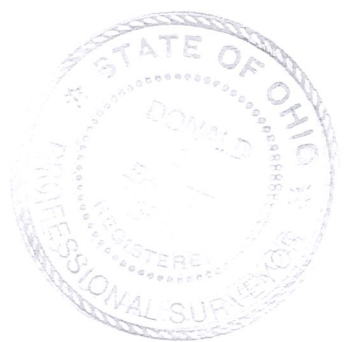

I CERTIFY THIS SURVEY TO BE CORRECT TO THE BEST OF MY KNOWLEDGE.

Donald C. Baker
 DONALD C. BAKER P.S. 6938
 138 N. CLAY ST.
 MILLERSBURG, OHIO 44654
 P.H. (330) 674-4788
 JANUARY 5, 1999

#83898 - M.L. DAVIS
 F.C.C. - J.D. DARR

