


WALNUT CREEK TOWNSHIP  
 1ST QTR., LOT 6  
 T-9 N; R-5 W  
 HOLMES COUNTY, OHIO

SURVEYED FOR: KAUFMAN REALTY

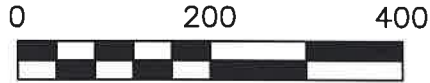

SCALE: 1"=200'

- STONE FOUND
- 5/8" REBAR FOUND  
UNLESS OTHERWISE NOTED
- 5/8" REBAR SET WITH I.D. CAP  
I.D. CAP MARKED "BAKER  
SURVEYING LLC"



I CERTIFY THIS SURVEY TO BE CORRECT  
 TO THE BEST OF MY KNOWLEDGE.

*Donald C. Baker*  
 DONALD C. BAKER P.S. 6938  
 DATE: JULY 1, 2021  
 ALG\TAB  
 FILE NAME: WORK6\S-355-21\CNK


S.R. 515

MICHAEL D. MILLER  
 SHARON MILLER  
 O.R. 251-4589  
 PN 2601419011

REFERENCES

- O.R. VOL. 251 PAGE 4589
- O.R. VOL. 276 PAGE 1945
- O.R. VOL. 260 PAGE 4181
- PLAT VOL. 16 PAGE 56
- PLAT VOL. 19 PAGE 2662
- PLAT VOL. 19 PAGE 3396
- PLAT VOL. 19 PAGE 3630

BASIS OF BEARINGS FROM  
 PLAT VOL. 19 PAGE 2662

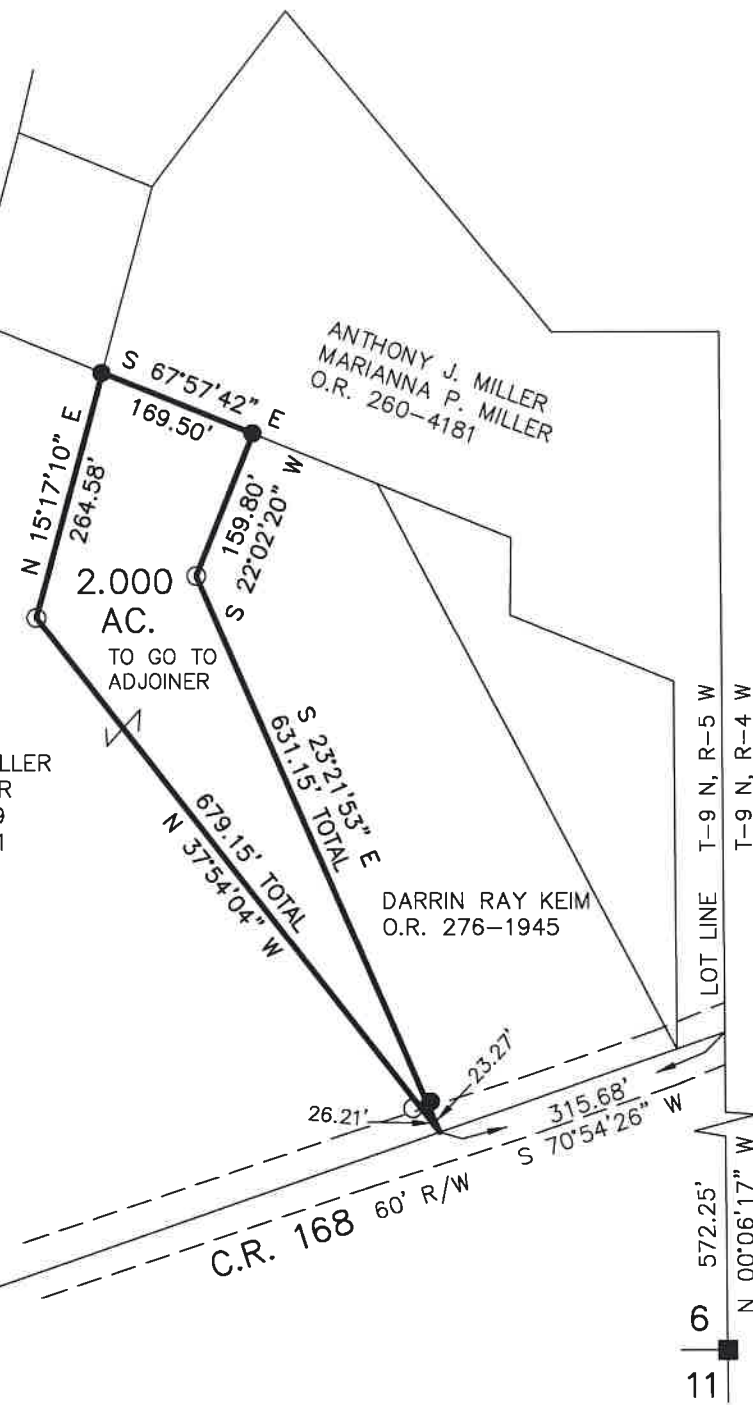

ANTHONY J. MILLER  
 MARIANNA P. MILLER  
 O.R. 260-4181

DARRIN RAY KEIM  
 O.R. 276-1945

LOT LINE T-9 N, R-5 W  
 T-9 N, R-4 W  
 572.25'  
 6'  
 11' N 00°06'17\"



BAKER SURVEYING, LLC  
 138 N. CLAY STREET  
 MILLERSBURG, OHIO 44654  
 PH. 330-674-4788  
 EMAIL: bakersurveying@gmail.com