


WALNUT CREEK TOWNSHIP
 1ST. QTR. LOT 7
 T-9N ; R-5W
 HOLMES COUNTY, OHIO

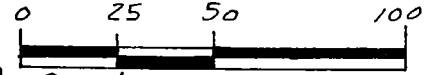


SCALE: 1" = 50'

- IRON PIN FOUND
- 5/8" RE BAR WITH I.D. CAP SET (I.D. CAP MARKED "BAKER 6938")

REFERENCE:

DEED VOL. 249 PAGE 177
 " " 204 " 165
 " " 210 " 726
 " " 204 " 42
 PLAT VOL. 8 PAGE 341
 " " 2 " 35
 " " 14 " 493
 " " 12 " 80

BEARINGS FROM DEED VOL. 204
 PAGE 42

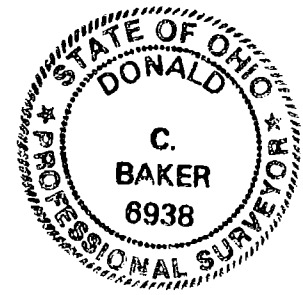

I CERTIFY THIS SURVEY TO BE CORRECT
 TO THE BEST OF MY KNOWLEDGE.

Donald C. Baker

DONALD C. BAKER P.S. 6938
 5958 T.R. 322
 MILLERSBURG, OHIO 44654
 PH. (614) 674-4788
 MAY 31, 1995

25695-MLS

