



WALNUTCREEK TOWNSHIP, 1ST QTR.
 LOT 8, T-9N; R-5W
 HOLMES COUNTY, OHIO

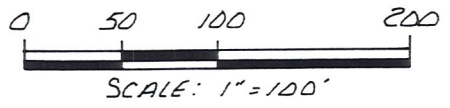

- IRON PIN FOUND
- 5/8" REBAR WITH I.D. CAP SET I.D. CAP MARKED "BAKER 6938"

REFERENCES:
 BEARINGS FROM PLAT VOL. 9
 PAGE 84

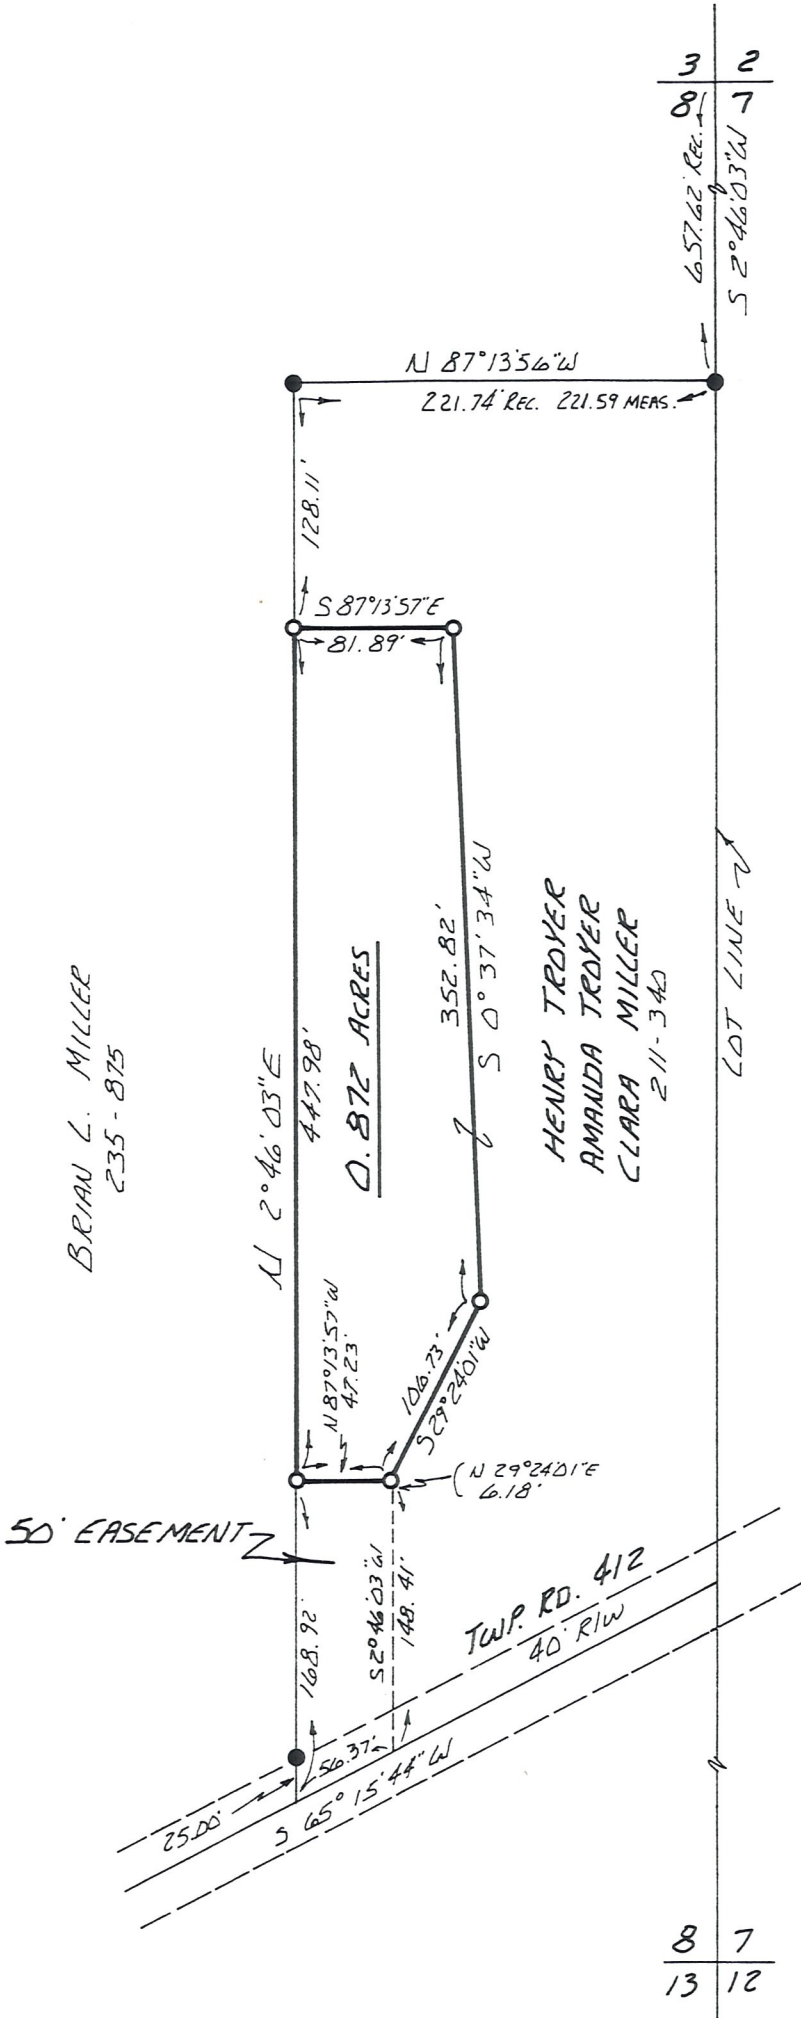

I CERTIFY THIS SURVEY TO BE CORRECT TO THE BEST OF MY KNOWLEDGE.

Donald C. Baker
 DONALD C. BAKER P.S. 6938
 4321 T.R. 252
 GLENMONT, OH.

AUGUST 20, 1988

3 2
8 7
657.62' Rec. 657.62' Rec.
S 2°46'03"W
N 87°13'56"W
221.74' Rec. 221.59' MEAS.
128.11'
S 87°13'57"E
81.89'
N 2°46'03"E
447.98'
0.872 ACRES
352.82'
S 0°37'34"W
LOT LINE
106.73'
S 29°24'01"W
6.18'
(N 29°24'01"E
148.41'
56.37'
S 65°15'44"W
168.92'
50' EASEMENT
TWP. RD. 412
40' R/W
25.00'
8 7
13 12

BRIAN L. MILLER
 235 - 875

HENRY TROYER
 AMANDA TROYER
 CLARA MILLER
 211-340