

RESURVEY OF A 26.51 ACRE TRACT RECORDED IN O.R. VOL. 36 PG. 765

WALNUT CREEK TOWNSHIP

1ST. QTR. LOT 21

T-9N; R-5W

HOLMES COUNTY, OHIO

(SURVEYED FOR FERMAN & FANNIE WENGERD)

0 100 200 400

SCALE: 1" = 200'

- STONE FOUND
- IRON PIN FOUND
- 5/8" REBAR WITH I.D. CAP SET
- I.D. CAP MARKED "BAKER 6938"



I CERTIFY THIS SURVEY TO BE CORRECT TO THE BEST OF MY KNOWLEDGE.

Donald C. Baker

DONALD C. BAKER P.S. 6938

DONALD C. BAKER SURVEYING


138 N. CLAY ST.

MILLERSBURG, OHIO 44654

PH: (330) 674-4788

MARCH 3, 2000

11000 - FJM
F.C.C. - F.D. BAKER

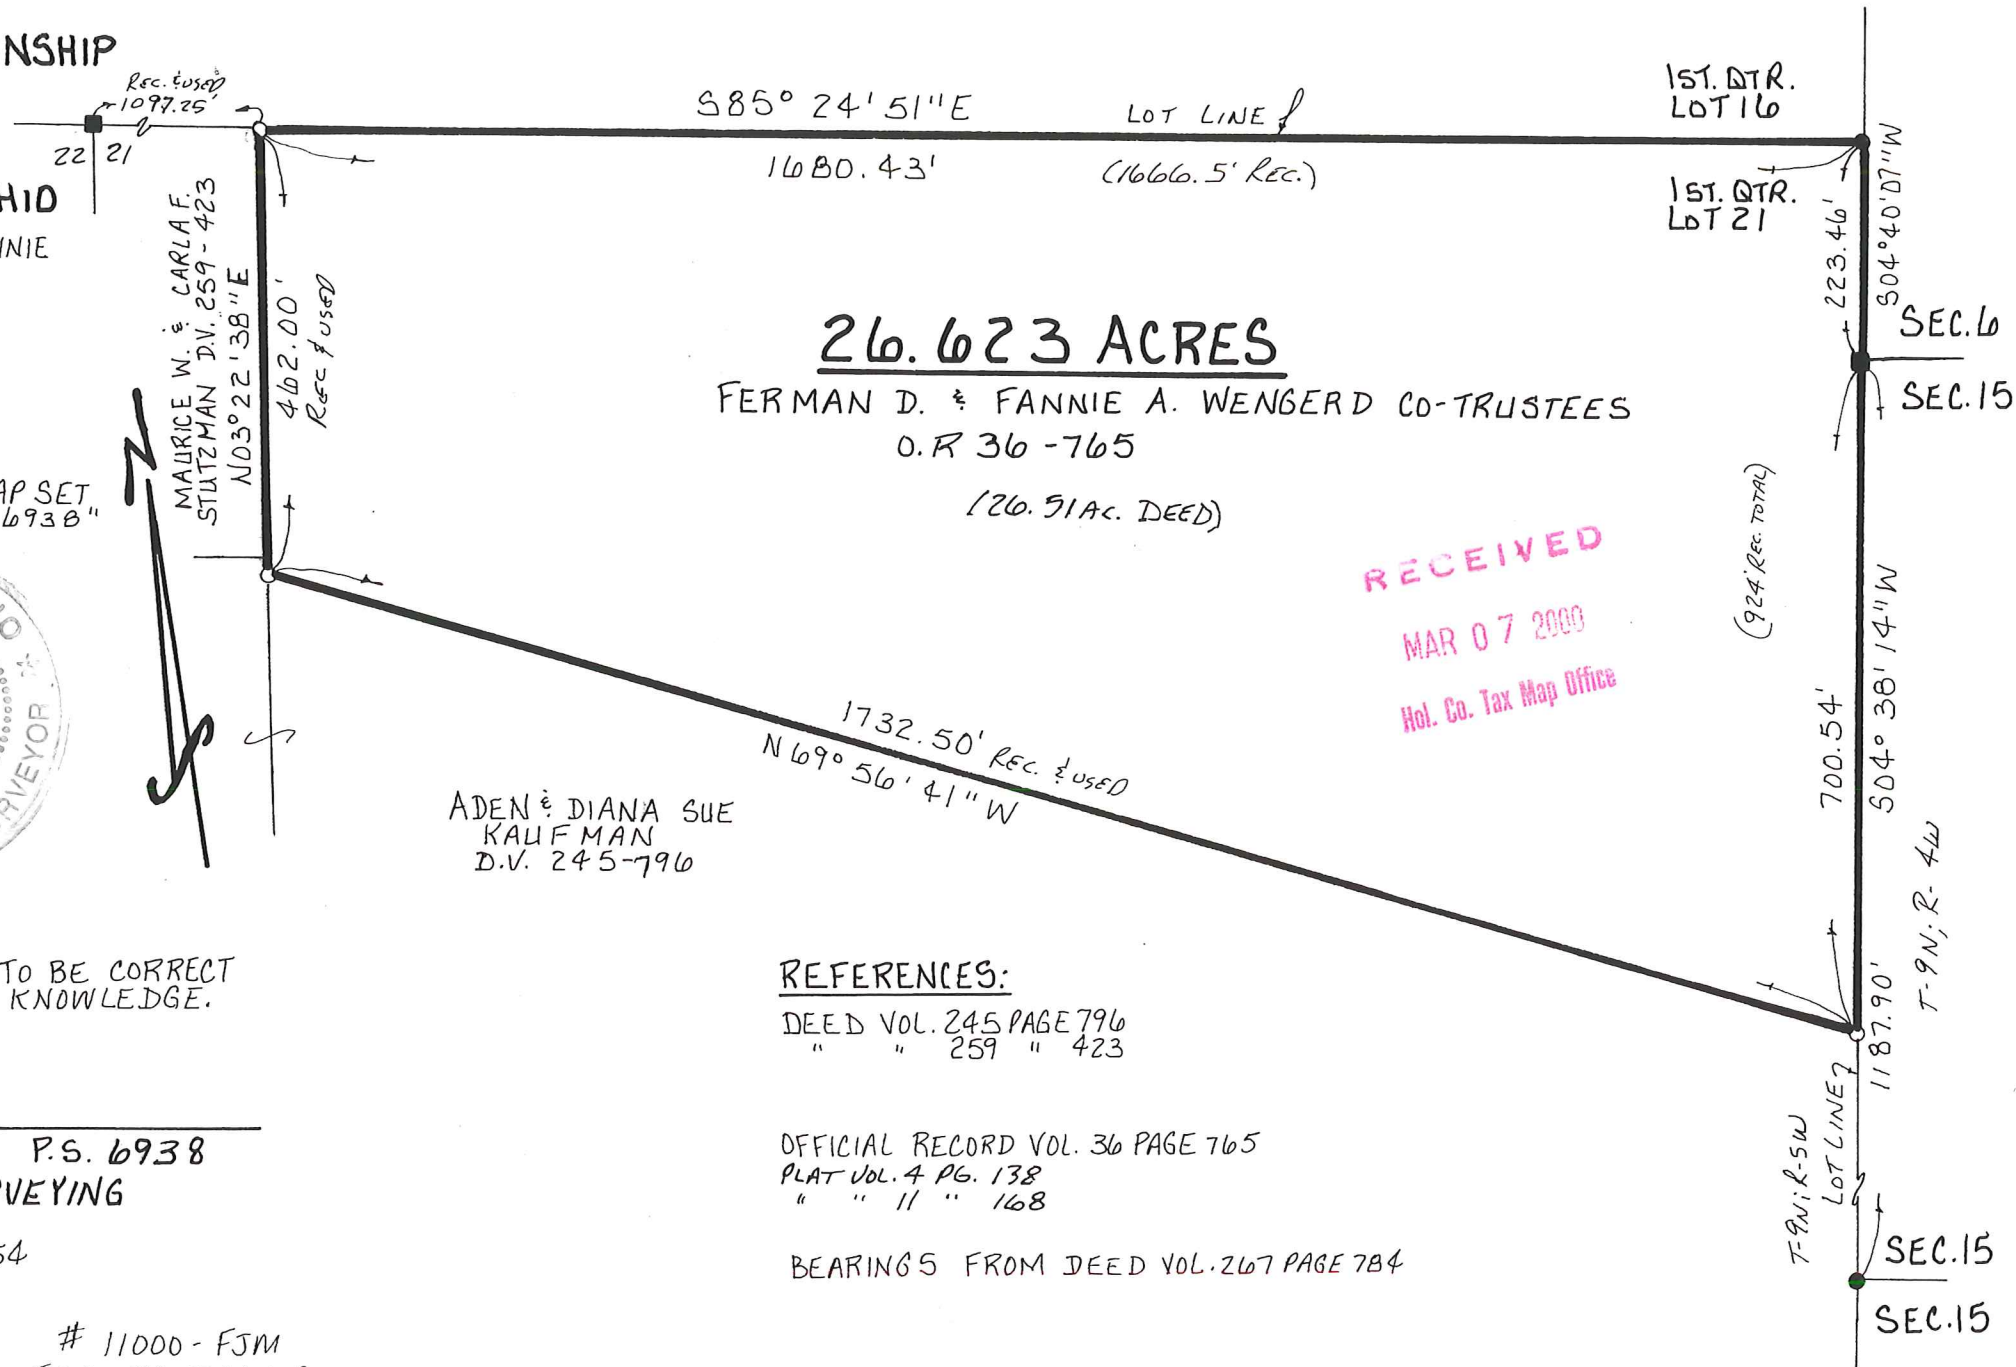

26.623 ACRES

FERMAN D. & FANNIE A. WENGERD CO-TRUSTEES
O.R. 36-765

(26.91 AC. DEED)

RECEIVED
MAR 07 2000
Hol. Co. Tax Map Office

REFERENCES:

DEED VOL. 245 PAGE 796
" " 259 " 423

OFFICIAL RECORD VOL. 36 PAGE 765
PLAT VOL. 4 PG. 138
" " 11 " 168

BEARINGS FROM DEED VOL. 267 PAGE 784