


WALNUT CREEK TOWNSHIP  
 N.E. QTR. SECTION 18  
 T-9N: R-5W  
 HOLMES COUNTY, OHIO  
 SURVEYED FOR MERVIN MILLER

REFERENCES:


- DEED VOL. 233 PAGE 895
- DEED VOL. 269 PAGE 401
- DEED VOL. 267 PAGE 700
- DEED VOL. 190 PAGE 718
- DEED VOL. 258 PAGE 213
- PLAT VOL. 7 PAGE 449
- PLAT VOL. 10 PAGE 682
- PLAT VOL. 8 PAGE 418

BEARINGS FROM PLAT VOL. 10 PAGE 682

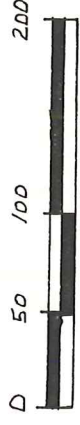

SCALE: 1" = 100'

- STONE FOUND
  - IRON PIN FOUND
  - 5/8" REBAR WITH ID. CAP SET
- ID. CAP MARKED "BAKER 6938"

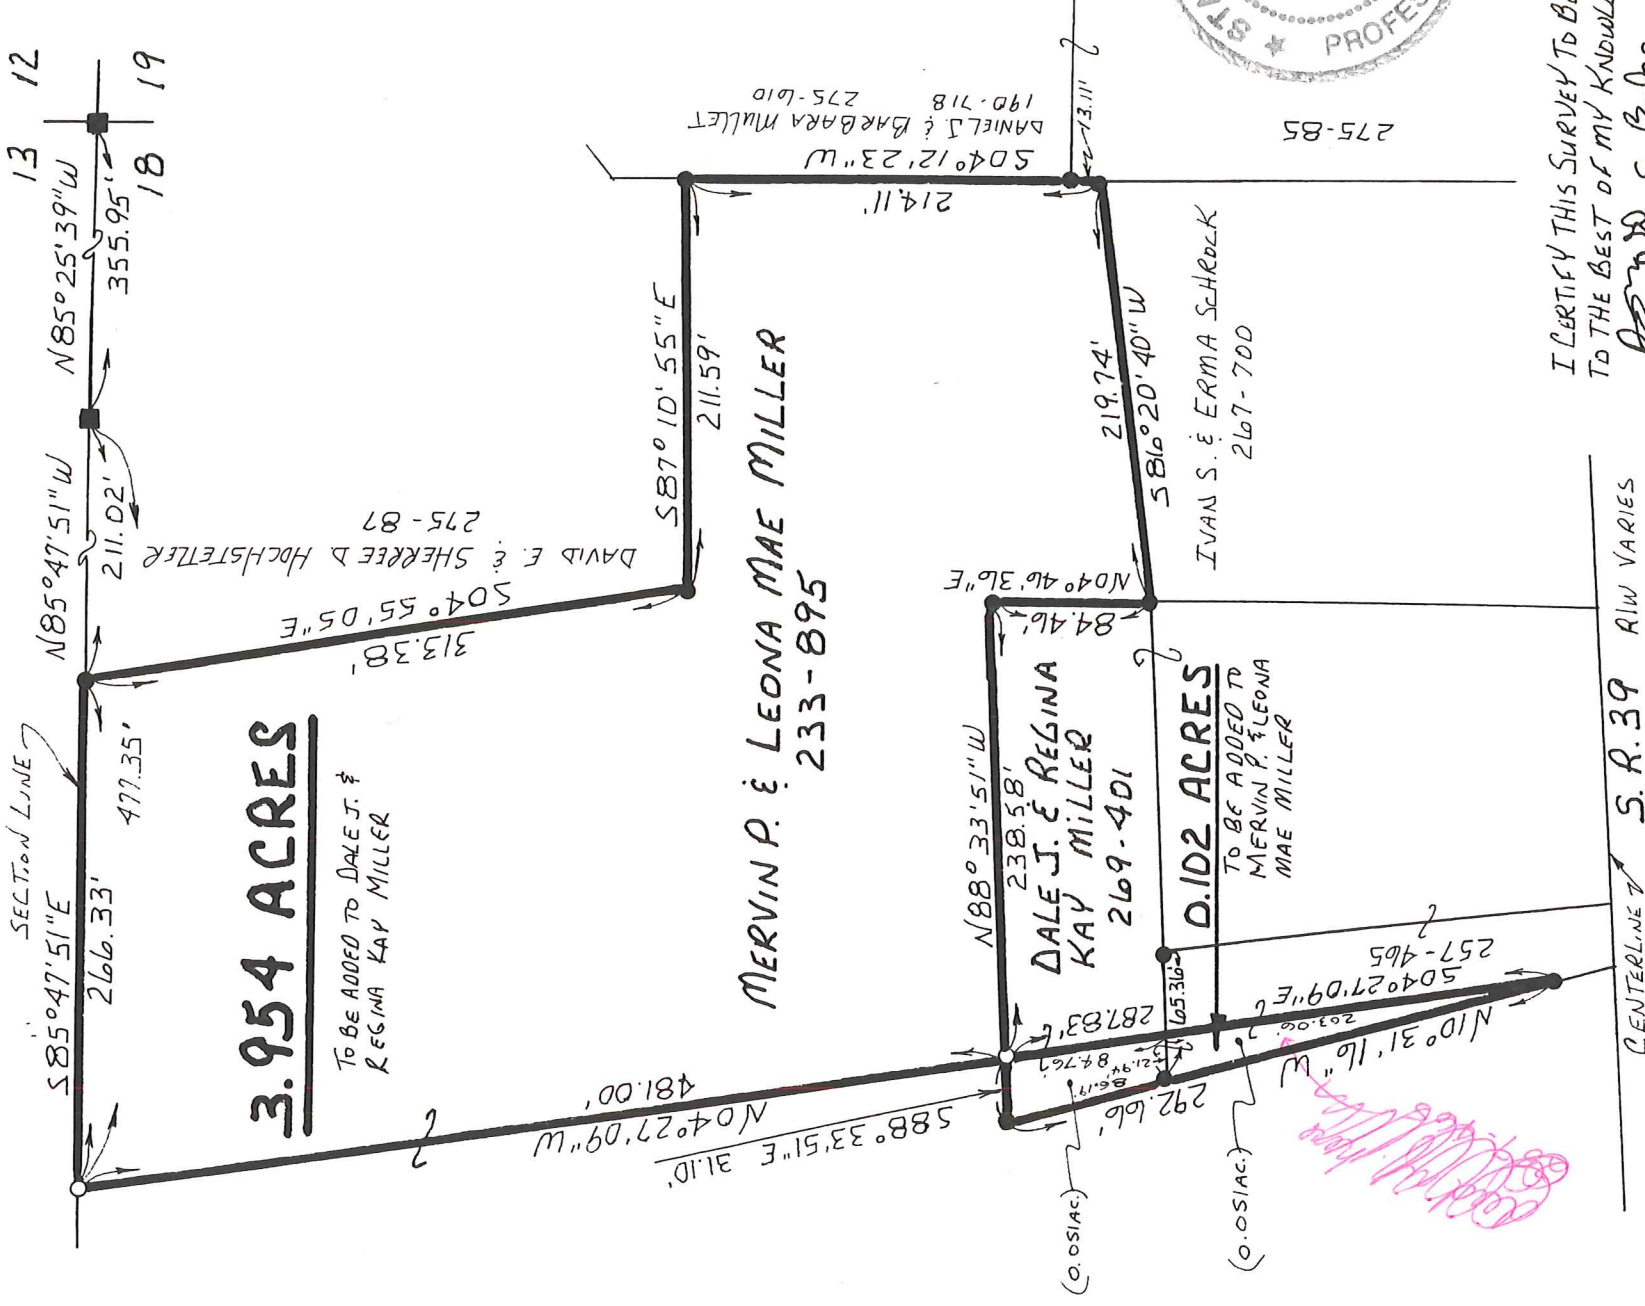

I CERTIFY THIS SURVEY TO BE CORRECT  
 TO THE BEST OF MY KNOWLEDGE.

Donald C. Baker  
 DONALD C. BAKER P.S. 6938  
 5958 T.R. 322  
 MILLERSBURG, OHIO 44654  
 PH. (330) 674-4788  
 FEBRUARY 4, 1997  
 6197 - SRU  
 FCC - J.D. DARR