

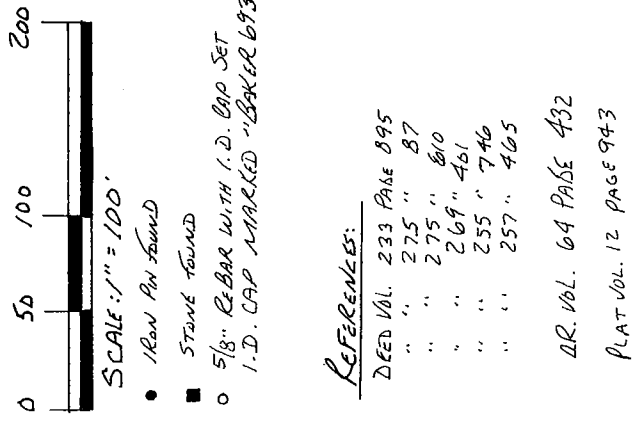


WALNUT CREEK TOWNSHIP  
 S.E. QTR. SECTION 13  
 N.E. QTR. SECTION 18  
 T. 9 N.; R. 5 W  
 HOLMES COUNTY, OHIO  
 (SURVEYED FOR: MERVIN P. & LEOANA MAE MILLER)

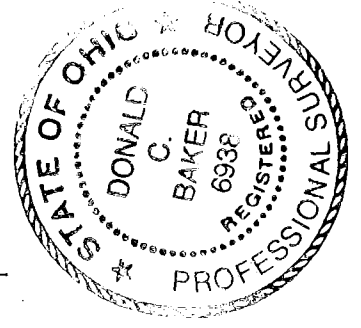

SCALE: 1" = 100'  
 REFERENCES:  
 DEED VOL. 233 PAGE 895  
 " " 275 " 87  
 " " 275 " 810  
 " " 269 " 461  
 " " 255 " 746  
 " " 257 " 465  
 D.R. VOL. 64 PAGE 432  
 PLAT VOL. 12 PAGE 943

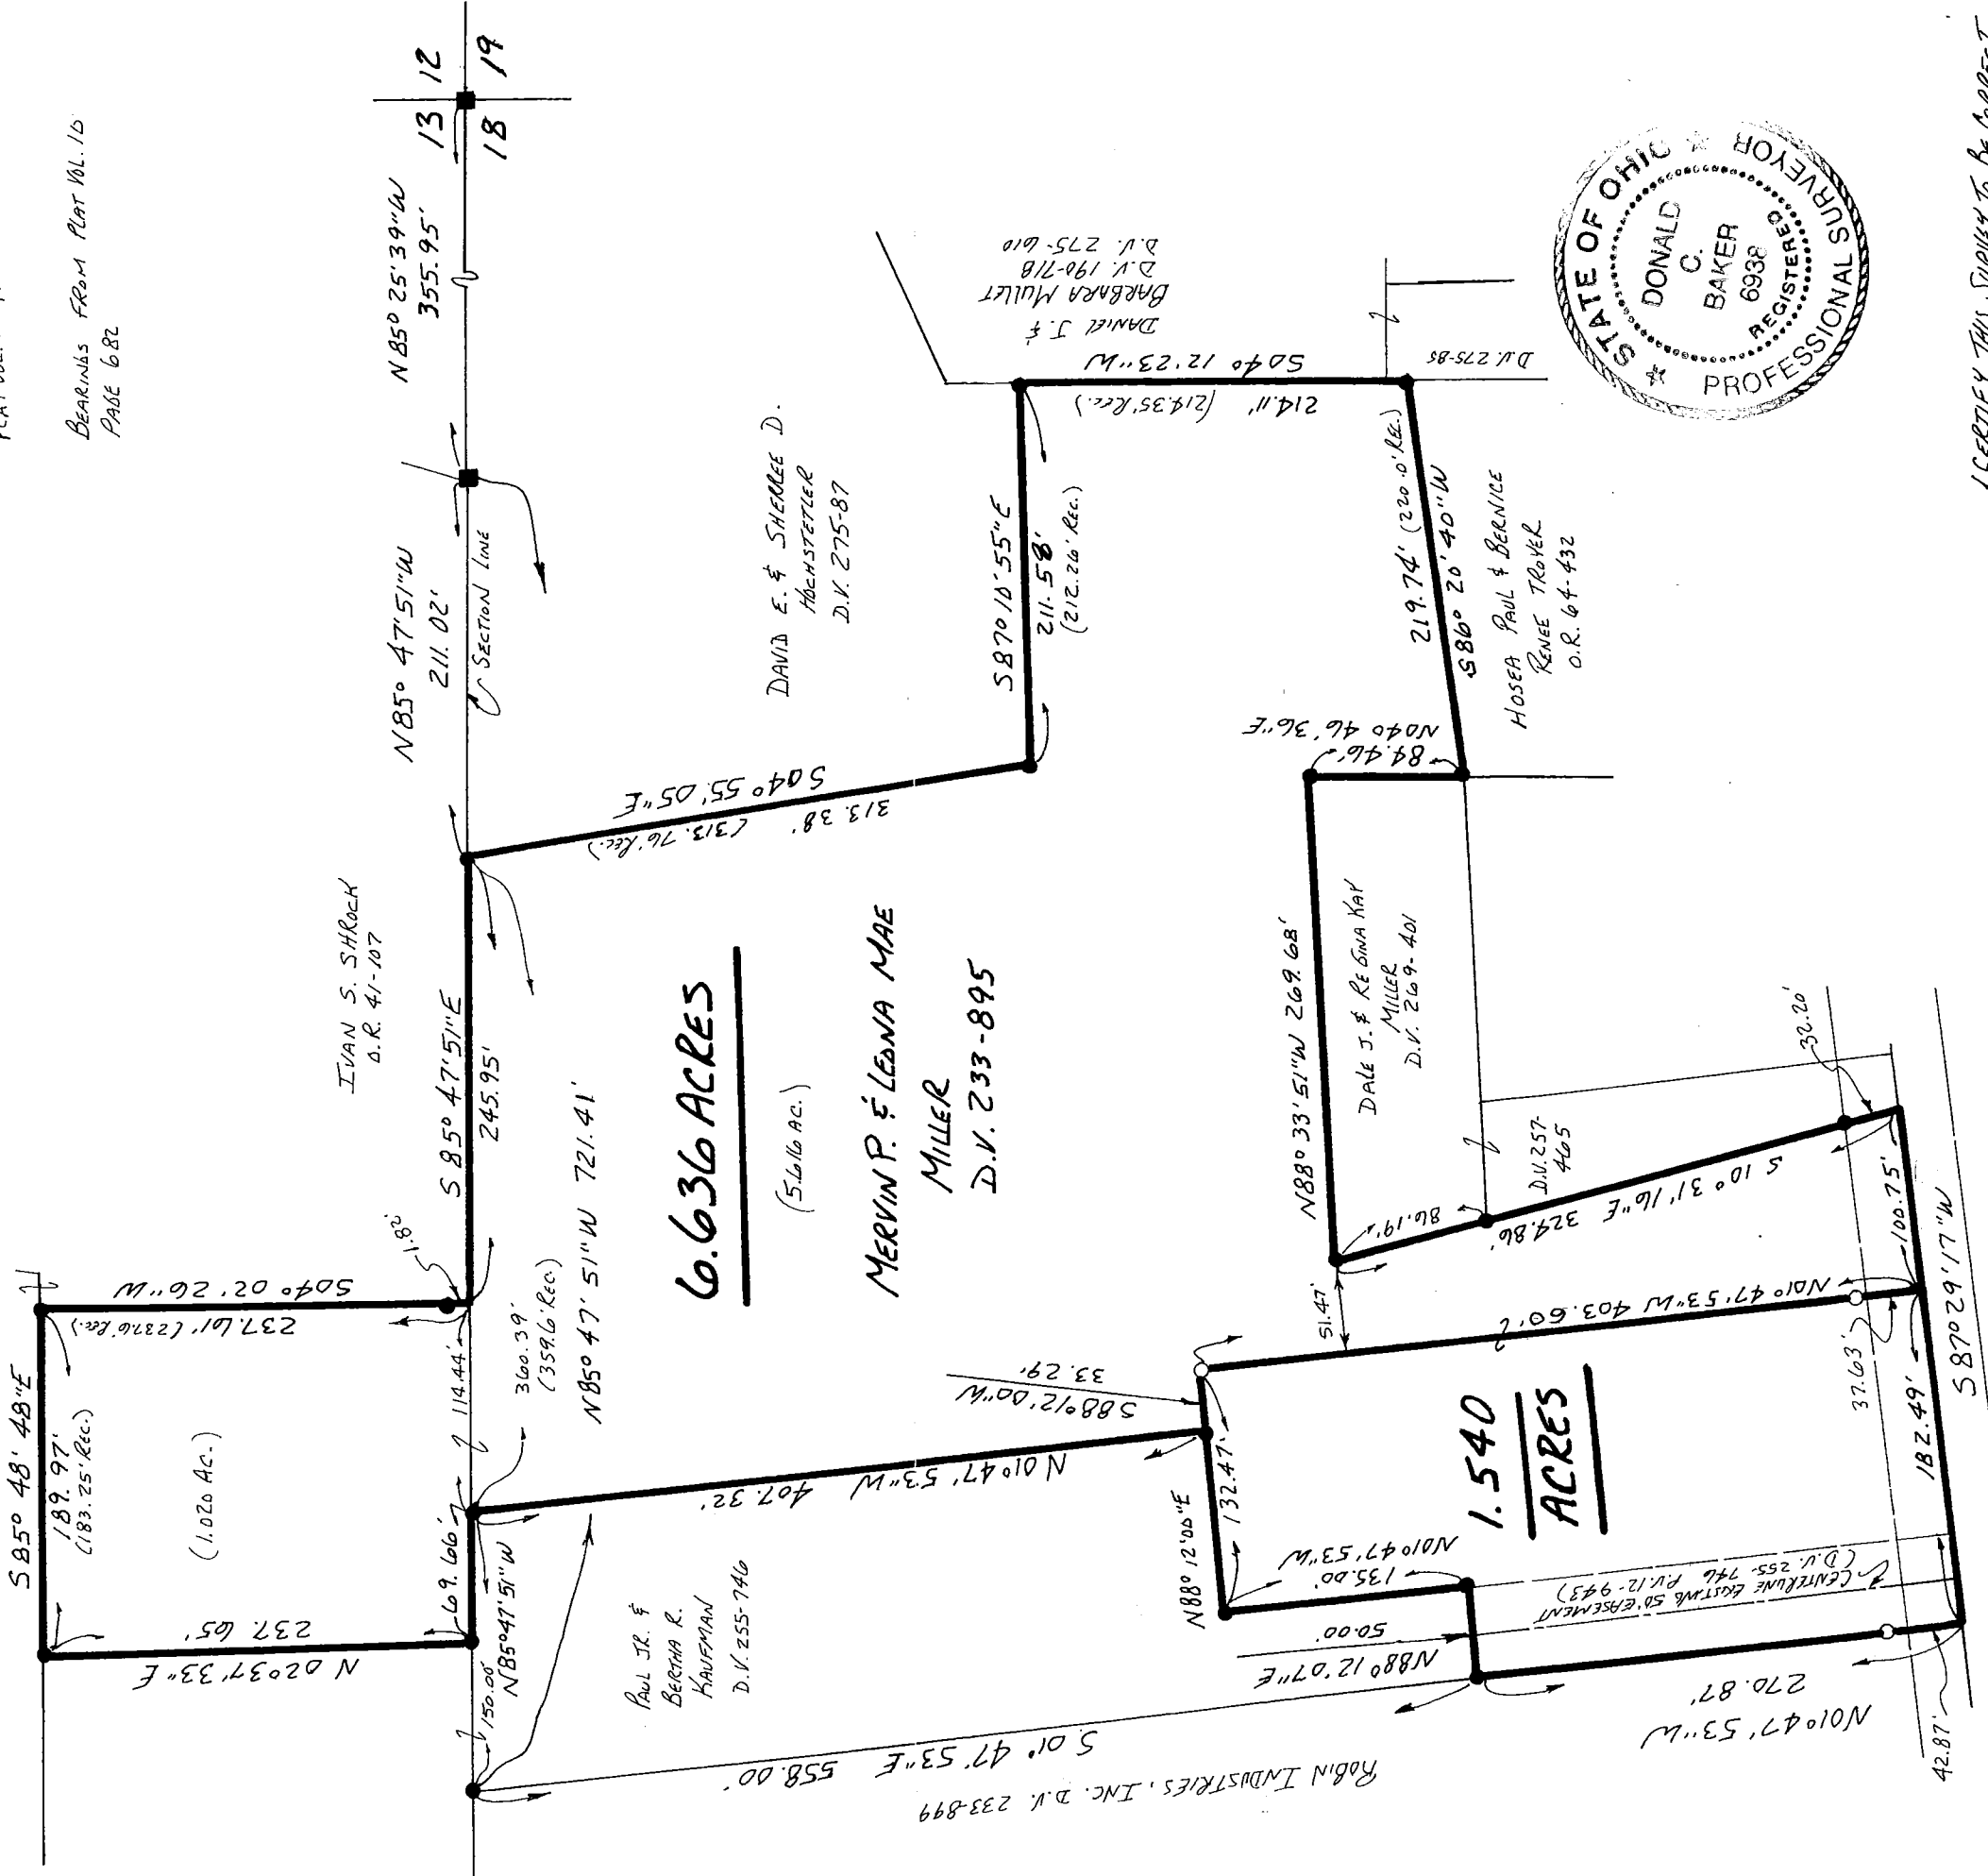

I CERTIFY THIS SURVEY TO BE CORRECT  
 TO THE BEST OF MY KNOWLEDGE  
 Donald C. Baker  
 DONALD C. BAKER P.S. 6938  
 DONALD C. BAKER SURVEYING  
 138 N. CLAY ST.  
 MILLERSBURG, OHIO 44654  
 PH. 330-674-4788  
 JULY 29, 2001  
 #54901-M.D.  
 F.C.C. F.D.B./K.W.

S.R. 39 R/W VARIES