

WALNUT CREEK TOWNSHIP
HOLMES COUNTY, OHIO
SW QTR SECTION 20, T-9N, R-5W

Lot 52 VILLAGE OF WALNUT CREEK

PUMP ST

Vacated

33'

10'

N 87° 21' 27" W, 261.12'

(260.04 rec)

87.00

Daniel J. & Shirley Lehman
Vol 219, Pg 935

Leather Shop

88.35

25.00

S 89° 11' 39" E

157.53' calc.
(151' rec.)

St. Johns United Church Of
Christ Inc.

Andrew B. Mast
Vol 181, Pg 893

5 09° 34' 43" E 206.25

60.15

57.75

82.5

orig. church
bldg

N 1° 12' 59" E
100.00

181.32 calc.
182.4 rec.


5 04° 27' 02" W
169.75 meas
169.4 rec.

78.00'

I.P. Fd NW 3.21'

S 84° 05' 11" W, 214.5

C.R. 145

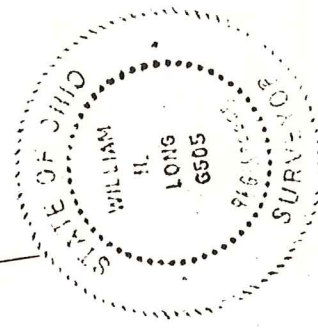

Scale: 1" = 50'

- I.P. Found
- I.P. Set
(5/8" Bar w/ Yellow Cap)

Bearings Assumed
References:

- Plat Vol 3 Pg 77
- Deed Vol 141, Pg 521
- Tax Map
- Other Deeds As Shown

This Survey Was Done To
Locate The North & East
Lines Of Lands Owned By
St. Johns United Church Of
Christ Inc.

I Certify This Survey To Be Correct To The
Best Of My Knowledge

William H. Long Aug 18, 1983
William H. Long R.S. 6505
RD 1 Box 69A
Big Prairie, Ohio 44611