




VILLAGE OF WALNUT CREEK
 WALNUT CREEK TOWNSHIP
 HOLMES COUNTY, OHIO
 N.W. QTR., SEC. 20, T-9N, R-5W

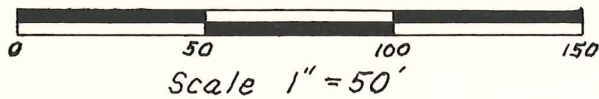

- Iron Pin Found
- Drill Hole In Conc. Found
- Iron Pin Set (5/8" Re-Bar with Yellow Cap Marked "Long 7115")
- ⊗ Drill Hole Set in Conc.

References:

Plat Vol. 10 Pg. 665
 Baker's Survey of Lot 36
 Dated July 21, 1987
 Bearings Assumed

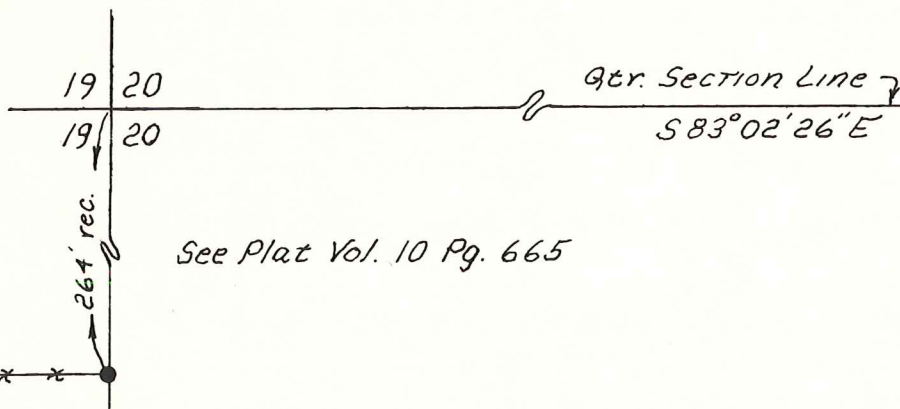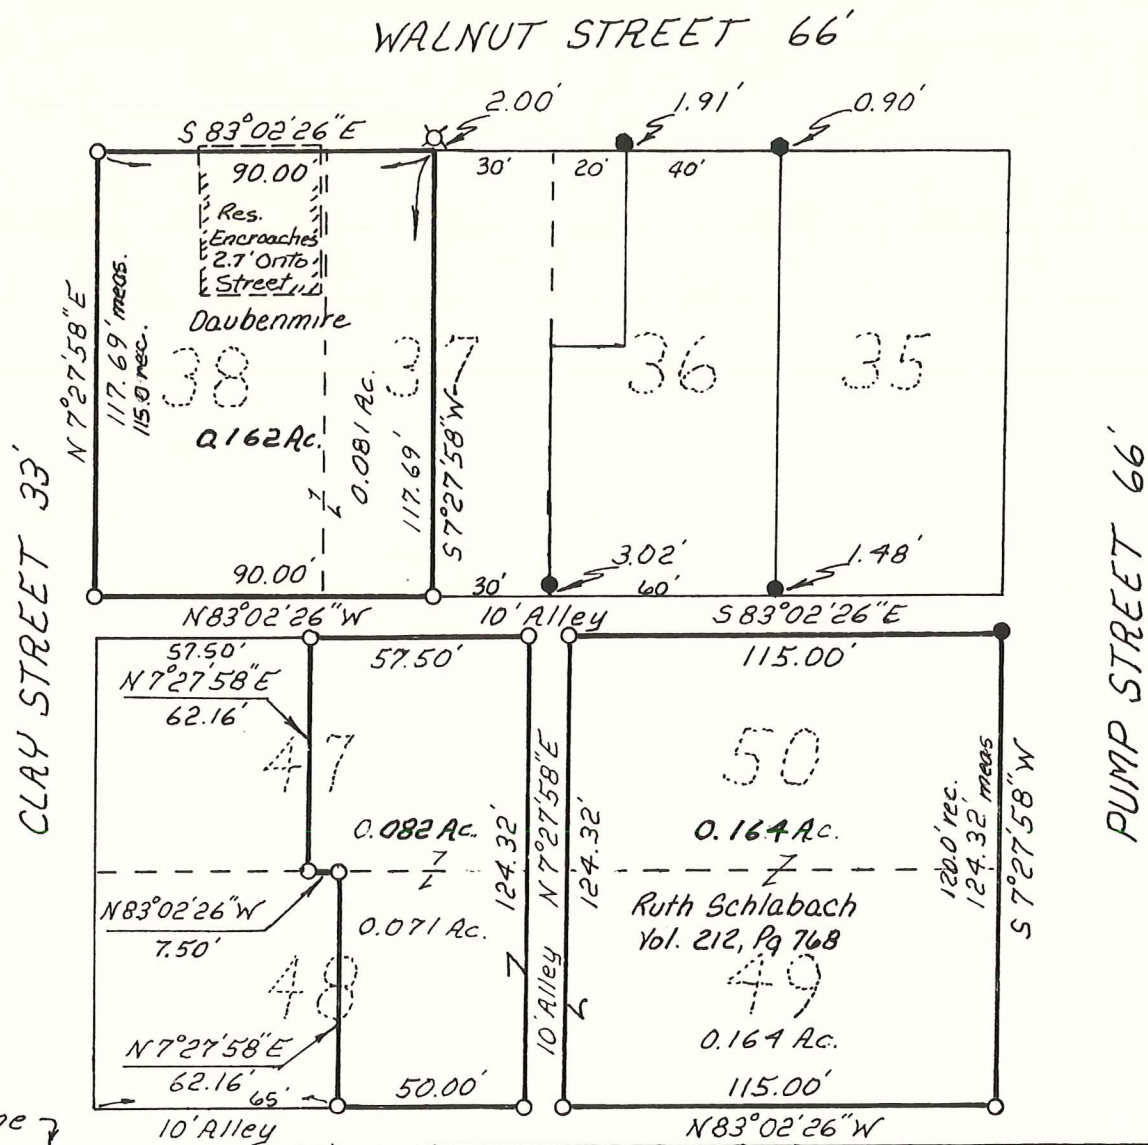

See Plat Vol. 10 Pg. 665

I Certify This Survey To Be Correct
 To The Best Of My Knowledge.

Donald G. Long August 25, 1987
 Donald G. Long P.S. 7115
 13301 T.R. 503
 Big Prairie, Ohio 44611

