WALNUT CREEK TOWNSHIP
N.W. QTR. SECTION 20
T- 9N ; R-5W
HOLMES COUNTY, OHIO

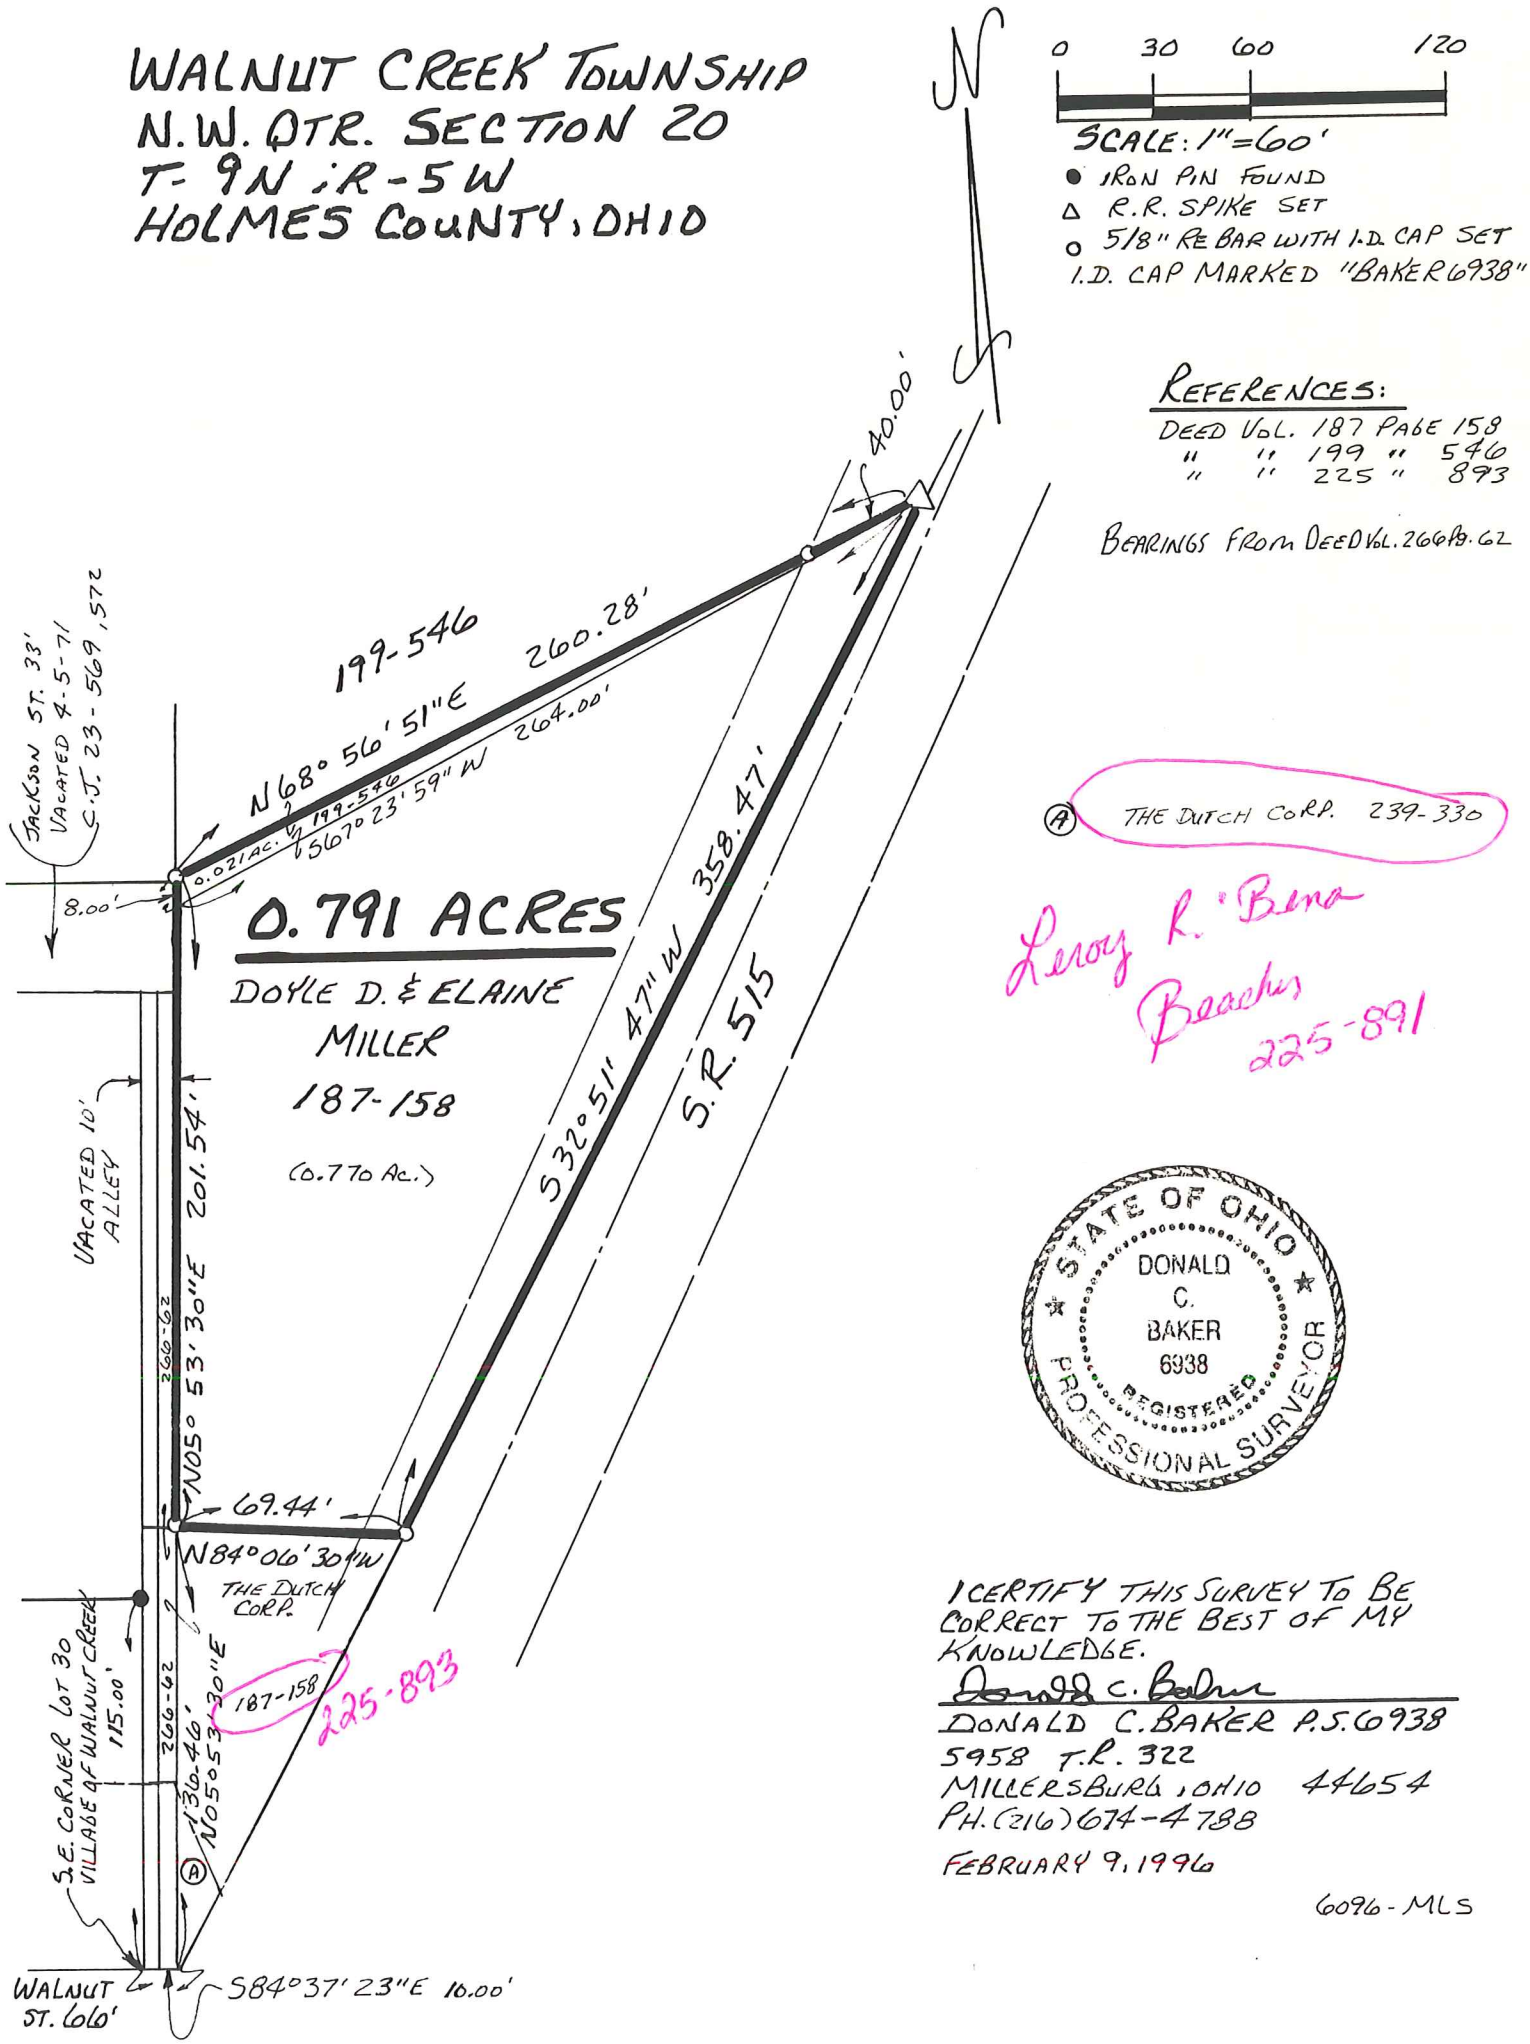

STATE OF OHIO
DONALD C. BAKER 6938
REGISTERED PROFESSIONAL SURVEYOR

I CERTIFY THIS SURVEY TO BE CORRECT TO THE BEST OF MY KNOWLEDGE.

Donald C. Baker

DONALD C. BAKER P.S. 6938
5958 T.R. 322
MILLERSBURG, OHIO 44654
PH. (216) 674-4788

FEBRUARY 9, 1996

6096 - MLS