

WALNUT CREEK TOWNSHIP
 S.E. QTR. SECTION 21
 T. 9N j R. 5W
 HOLMES COUNTY, OHIO





SCALE: 1" = 100'

- IRON PIN FOUND
- 5/8" RE BAR WITH I.D. CAP SET
- I.D. CAP MARKED "BAKER 0938"

REFERENCES:

- PLAT VOL. 7 PAGE 202
- PLAT VOL. 40 PAGE 1
- DEED VOL. 186 PAGE 391
- DEED VOL. 233 PAGE 410
- DEED VOL. 216 PAGE 389
- PLAT VOL. 10 PAGE 325
- BEARINGS FROM PLAT VOL. 6 PAGE 1

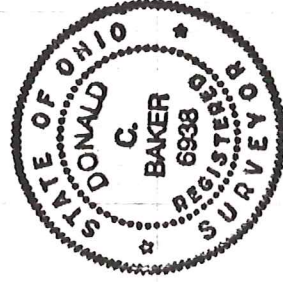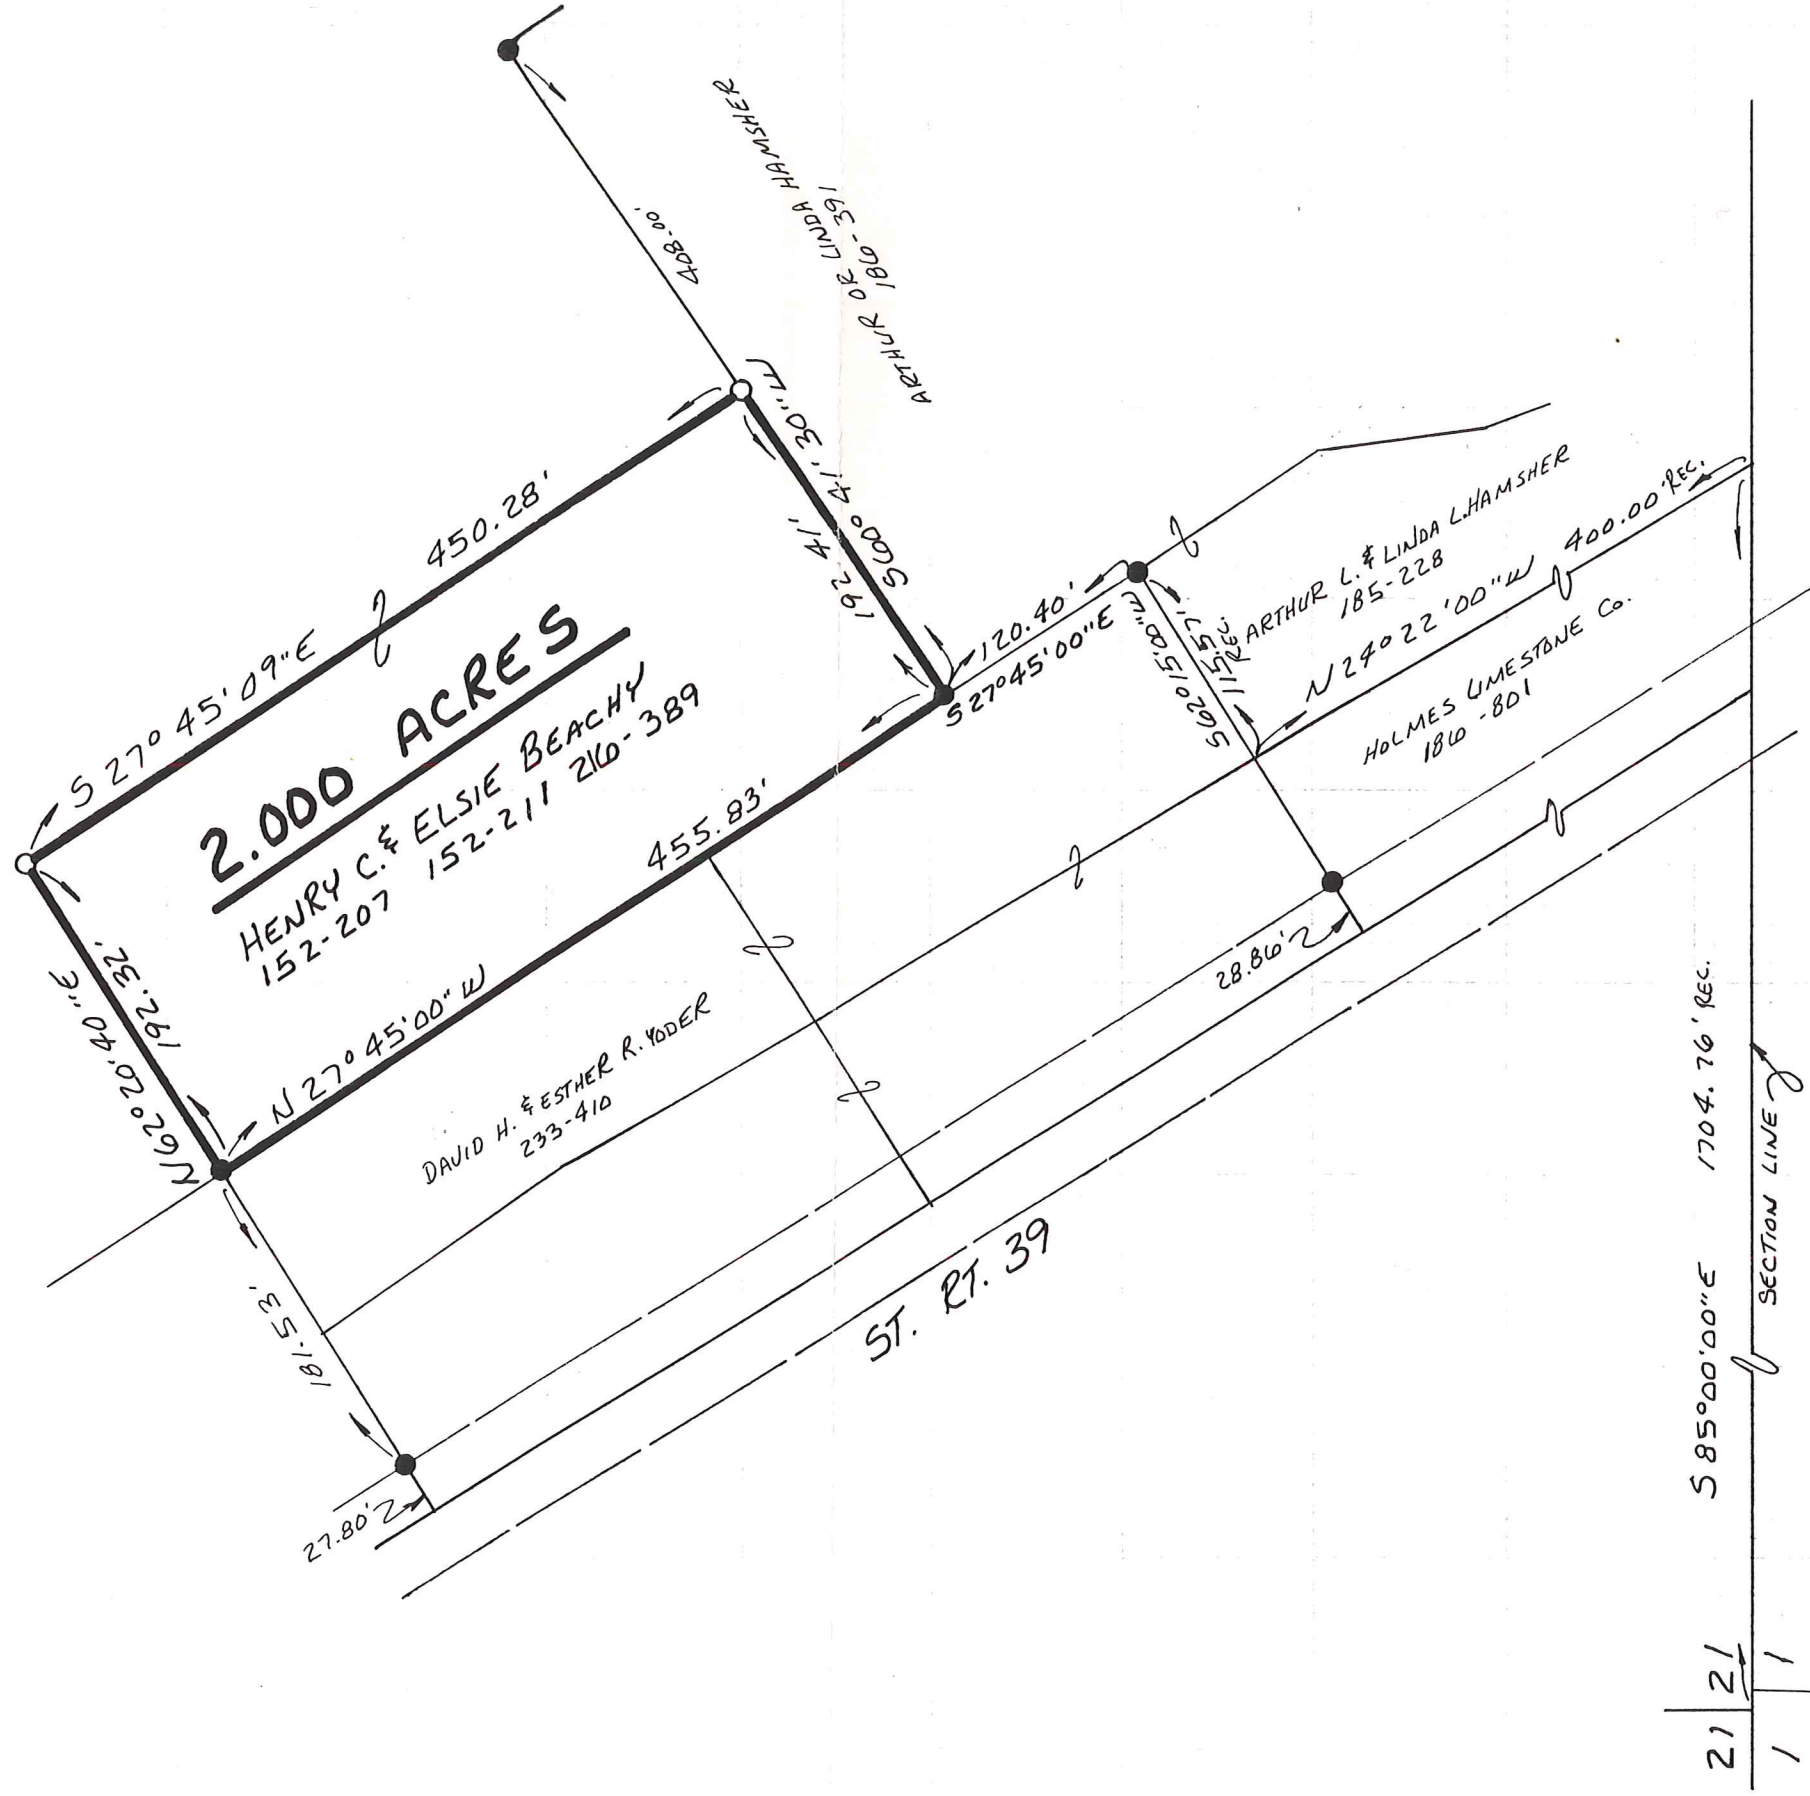

I CERTIFY THIS SURVEY TO BE CORRECT
 TO THE BEST OF MY KNOWLEDGE.

Donald C. Baker
 DONALD C. BAKER P.S. 6938
 5958 T. R. 322
 MILLERSBURG, OHIO 44654
 PH. 216/674-4788
 JUNE 30, 1992

26392-MLS