


WALNUT CREEK TOWNSHIP
 S.E. QTR. SECTION 22
 T. 9N R. 5W
 HOLMES COUNTY, OHIO

EASEMENT SURVEY

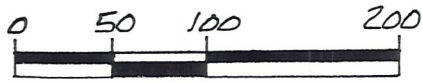


SCALE: 1" = 100'

- STONE FOUND
- 5/8" RE BAR WITH I.D. CAP SET
- I.D. CAP MARKED "BAKER 6938"

REFERENCES:

- PLAT VOL. 7 PAGE 158
- PLAT VOL. 12 PAGE 773
- PLAT VOL. 4 PAGE 186
- DEED VOL. 246 PAGE 942
- DEED VOL. 168 PAGE 563 & 566
- BEARINGS FROM DEED VOL. 246 PAGE 942

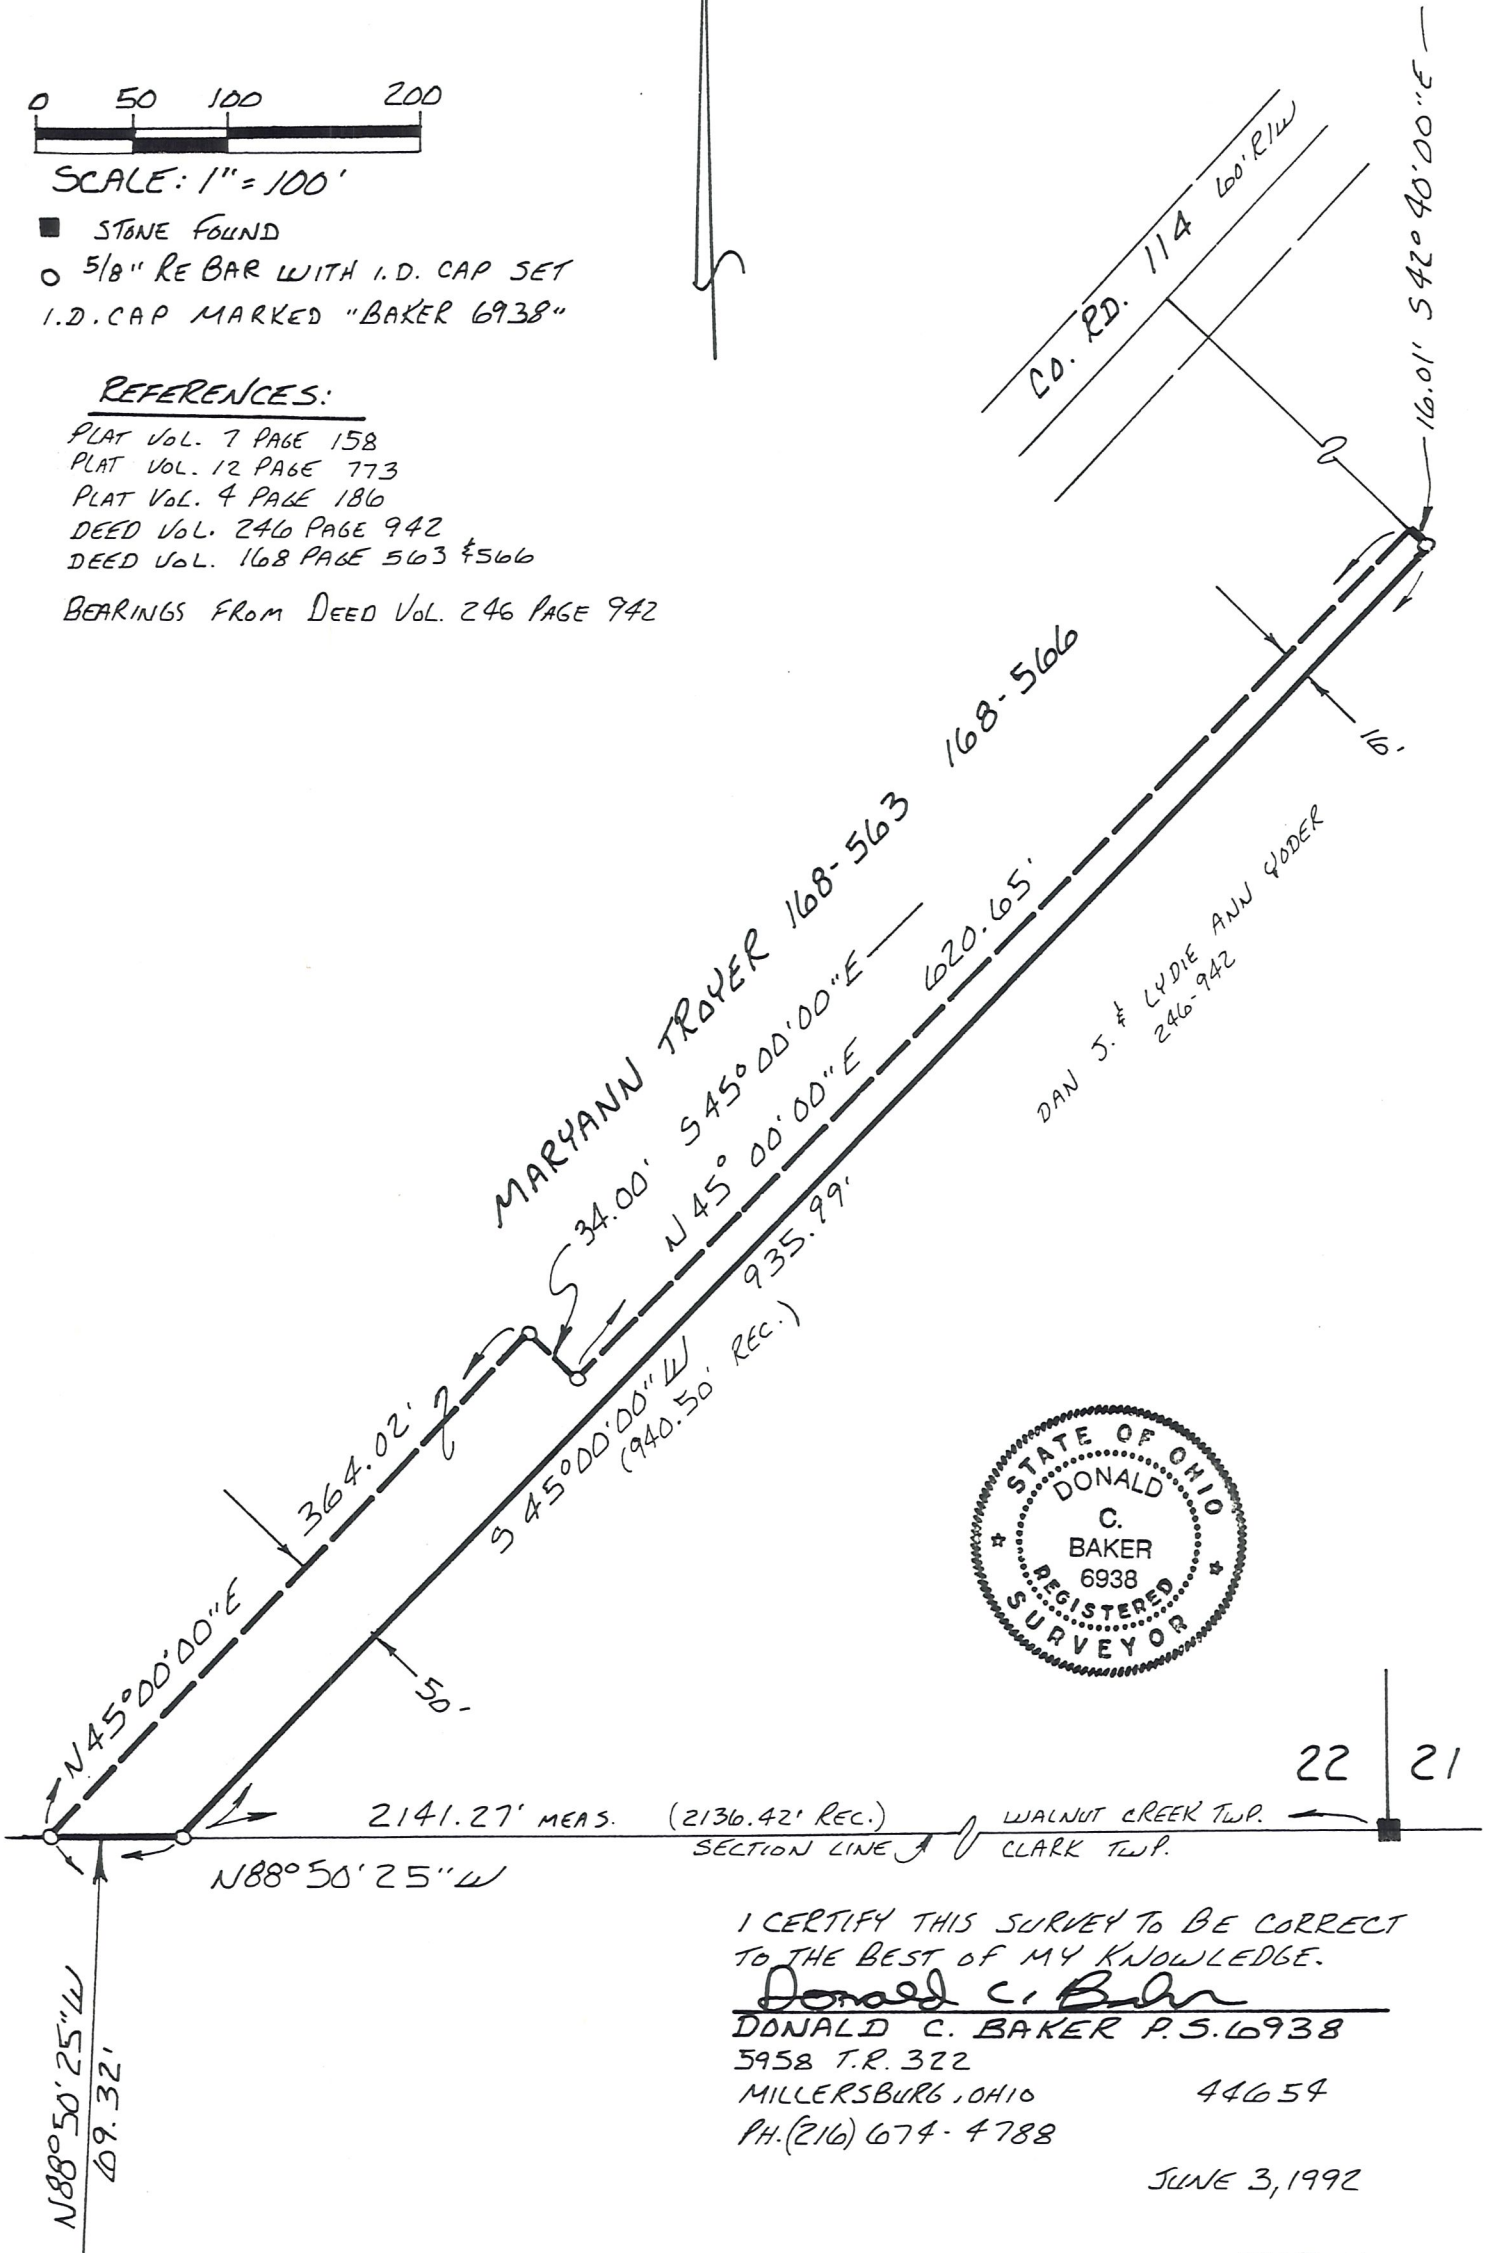

I CERTIFY THIS SURVEY TO BE CORRECT TO THE BEST OF MY KNOWLEDGE.

Donald C. Baker
 DONALD C. BAKER P.S. 6938
 5958 T.R. 322
 MILLERSBURG, OHIO 44654
 PH. (216) 674-4788

JUNE 3, 1992