



WALNUT CREEK TOWNSHIP
 N.E. QTR. SECTION 22
 T-9 N; R-5 W
 HOLMES COUNTY, OHIO

SURVEYED FOR: BEN TROYER, JR.

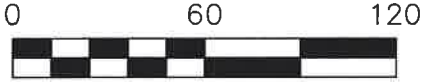

SCALE: 1"=60'


- 5/8" REBAR FOUND
UNLESS OTHERWISE NOTED
- 5/8" REBAR SET WITH I.D. CAP
I.D. CAP MARKED "BAKER 6938"

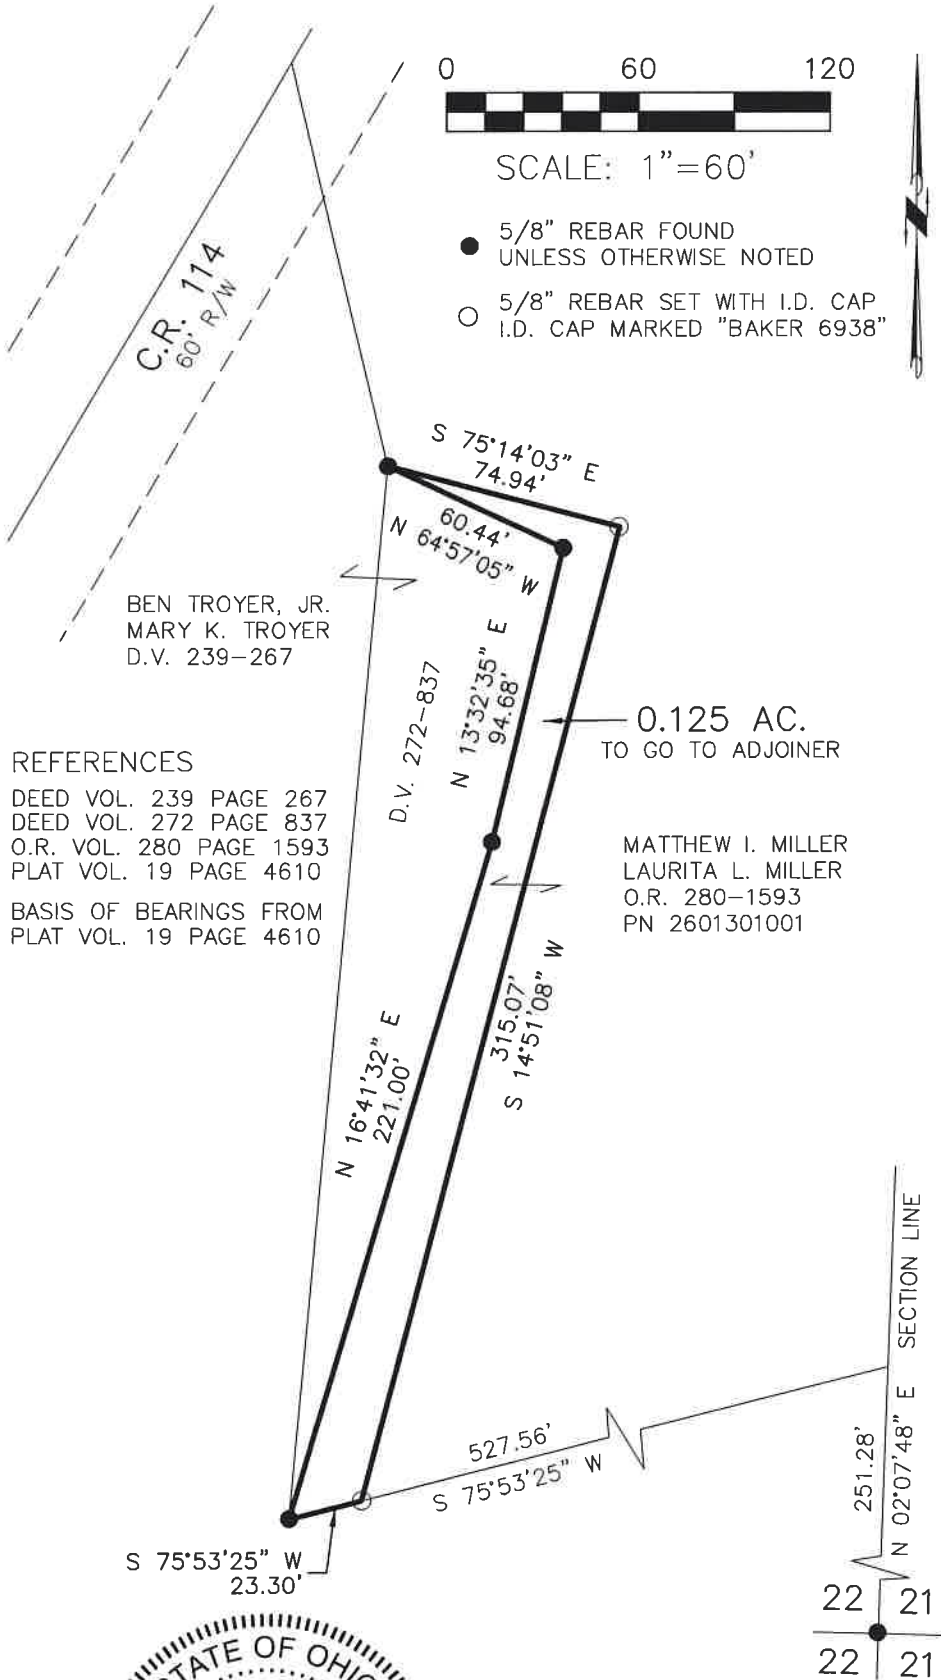

I CERTIFY THIS SURVEY TO BE CORRECT
 TO THE BEST OF MY KNOWLEDGE.

Donald C. Baker

DONALD C. BAKER P.S. 6938
 DATE: JULY 26, 2022
 TAB
 FILE NAME: WORK6\S-388-22\CNK

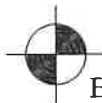

BAKER SURVEYING, LLC
 138 N. CLAY STREET
 MILLERSBURG, OHIO 44654
 PH. 330-674-4788
 EMAIL: bakersurveying@gmail.com