


WALNUT CREEK TOWNSHIP
 N.E. & S.E. QTR. SECTION 23
 T-9N; R-5W
 HOLMES COUNTY, OHIO

18 19
 23 22


ALTA M. KASER 106-571 150-596 230-777

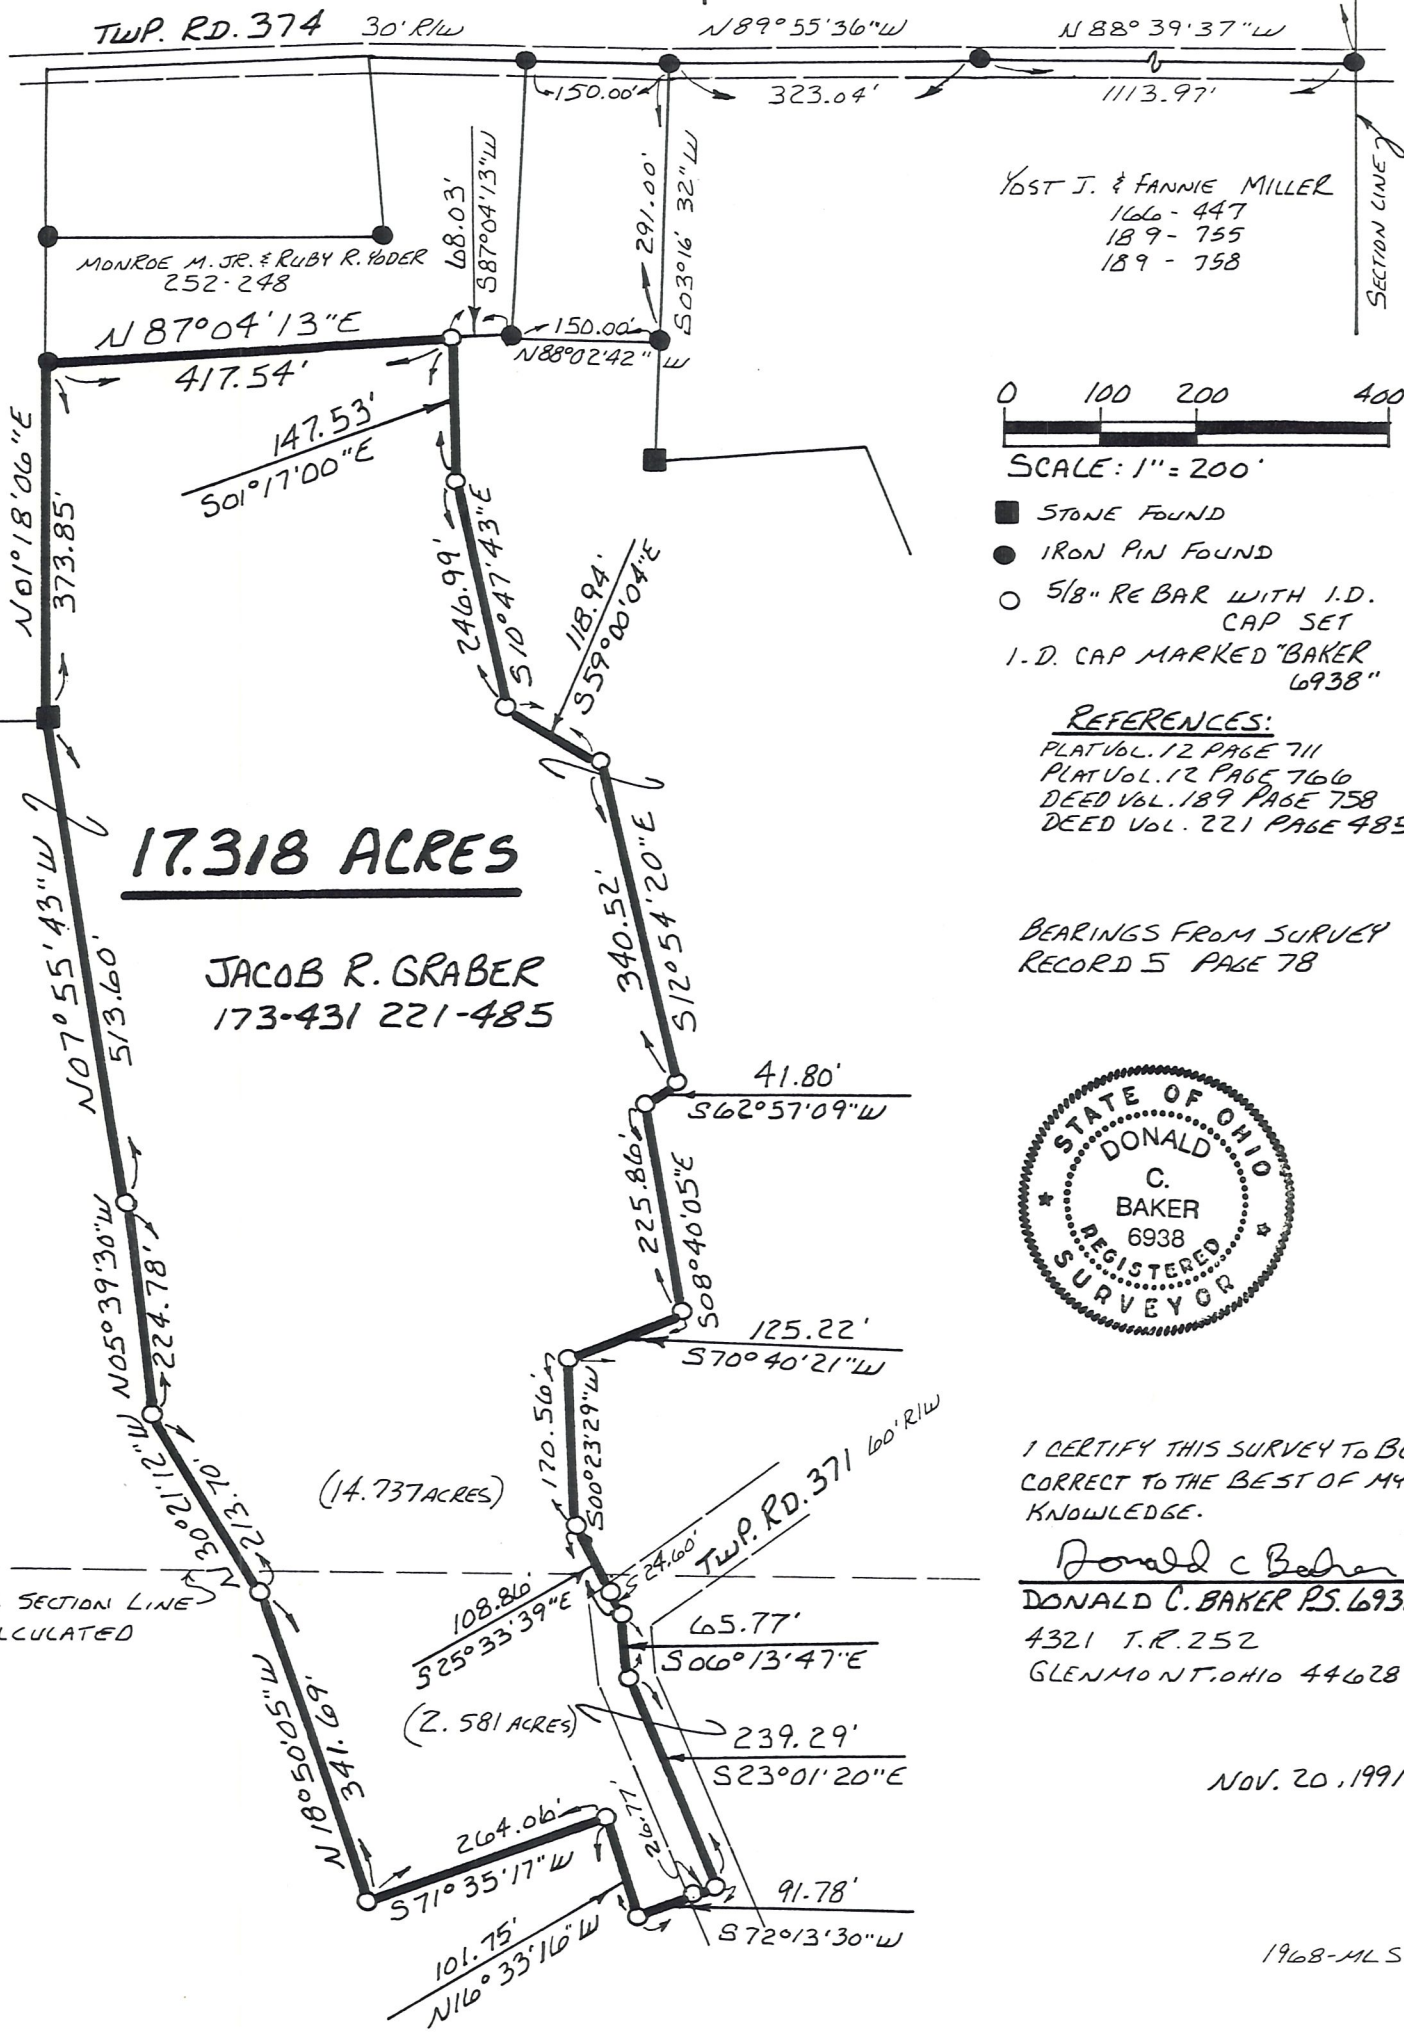

17.318 ACRES

JACOB R. GRABER
 173-431 221-485


YOST J. & FANNIE MILLER
 166-447
 189-755
 189-758

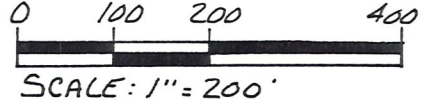

- STONE FOUND
- IRON PIN FOUND
- 5/8" RE BAR WITH I.D. CAP SET
- I.D. CAP MARKED "BAKER 6938"

REFERENCES:
 PLAT VOL. 12 PAGE 711
 PLAT VOL. 12 PAGE 766
 DEED VOL. 189 PAGE 758
 DEED VOL. 221 PAGE 485

BEARINGS FROM SURVEY
 RECORD 5 PAGE 78

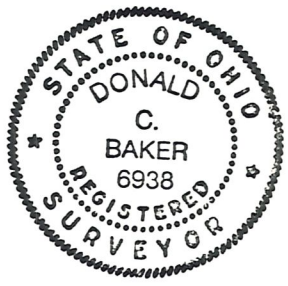

I CERTIFY THIS SURVEY TO BE
 CORRECT TO THE BEST OF MY
 KNOWLEDGE.

Donald C Baker
 DONALD C. BAKER P.S. 6938
 4321 T.R. 252
 GLENMONT, OHIO 44628

NOV. 20, 1991