

VILLAGE OF NASHVILLE  
 LOT 152  
 PART OF LOTS 78 & 79  
 HOLMES COUNTY, OHIO



SURVEYED FOR: RUTH KAYLOR

REFERENCES:

- DEED VOL. 209 PAGE 53
- DEED VOL. 245 PAGE 50
- O.R. VOL. 51 PAGE 916
- O.R. VOL. 153 PAGE 769
- PLAT VOL. 12 PAGE 967
- BEARINGS FROM PLAT VOL. 18 PAGE 461

- 5/8" REBAR FOUND UNLESS OTHERWISE NOTED
- △ R.R. SPIKE SET
- DRILL HOLE or CROW'S FOOT
- P.K. NAIL SET
- 5/8" REBAR WITH I.D. CAP SET I.D. CAP MARKED "BAKER 6938"

DONALD C. BAKER SURVEYING  
 138 N. CLAY ST.  
 MILLERSBURG, OHIO 44654  
 PH. 330-674-4788  
 FAX 330-674-6027

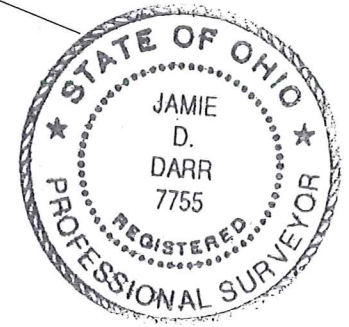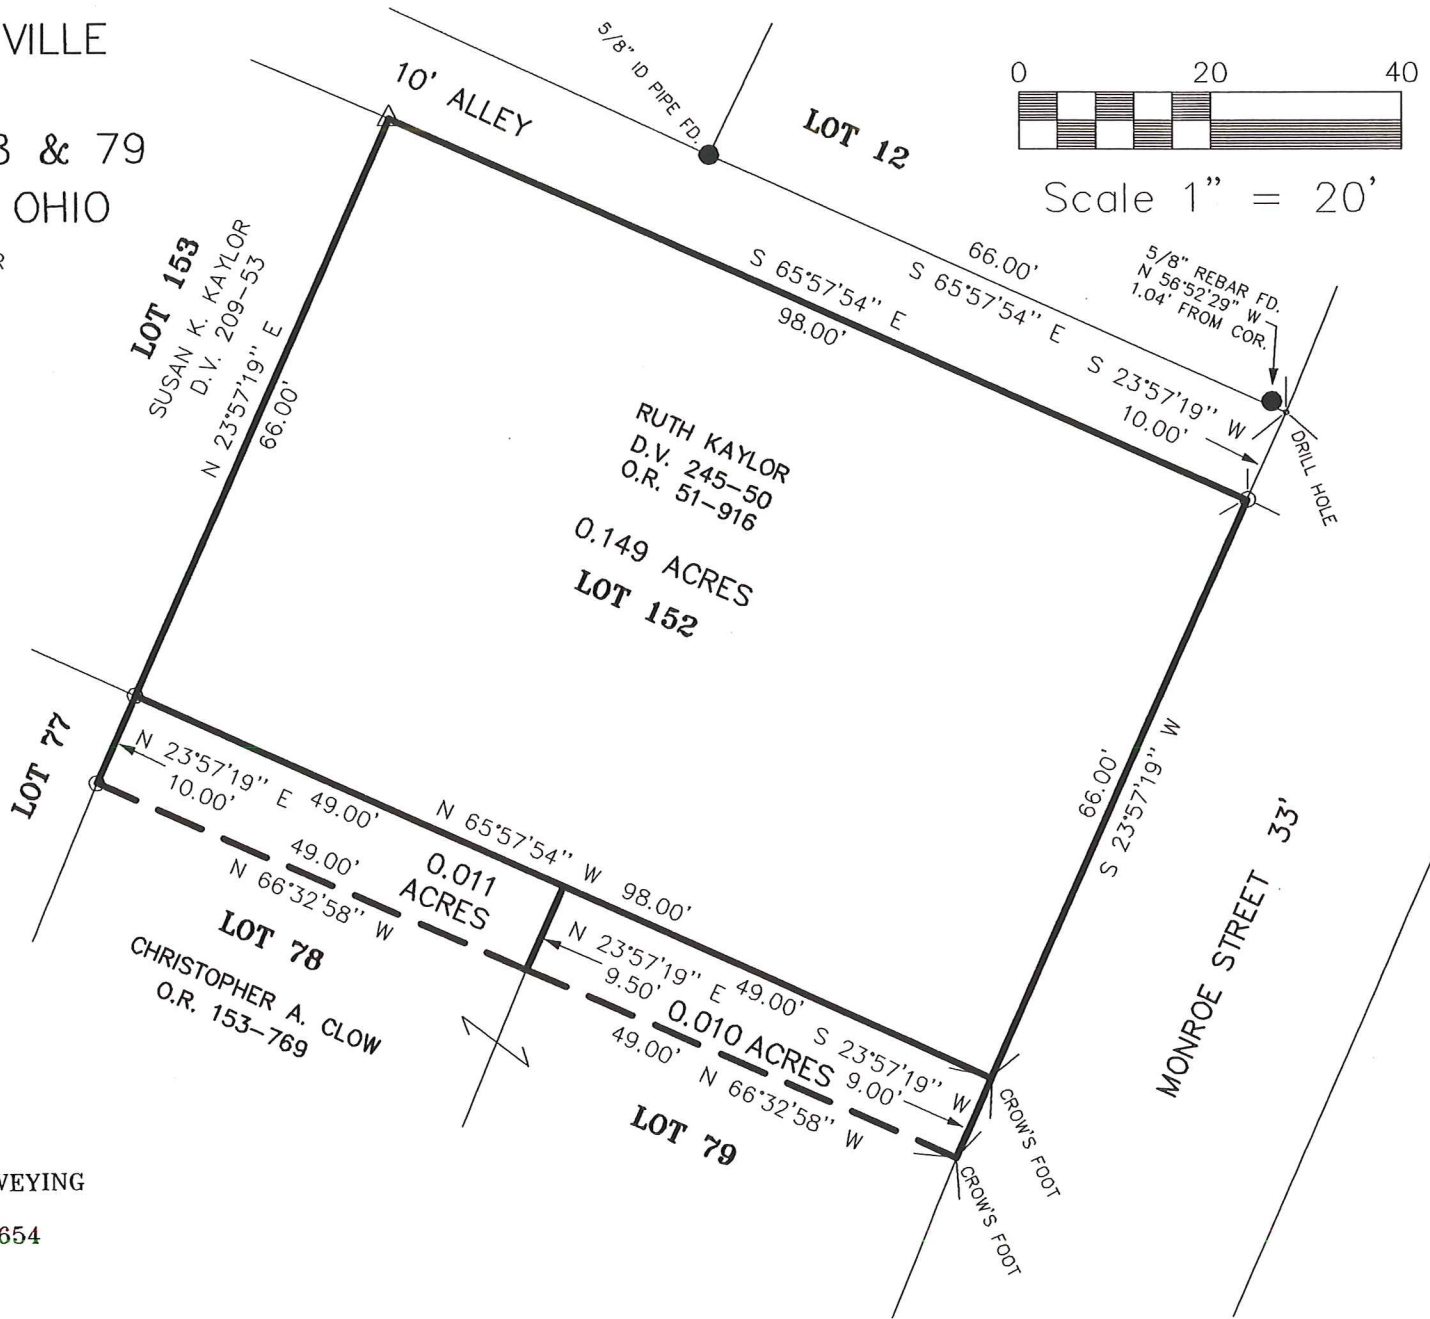

I CERTIFY THIS SURVEY TO BE CORRECT TO THE BEST OF MY KNOWLEDGE.  
 \_\_\_\_\_  
 JAMIE D. DARR P.S. 7755  
 DATE: JULY 23, 2003  
 FCC\JDD  
 File name: C:\JOBS1\S-308-03\ERZ