



WASHINGTON TOWNSHIP
 S.W. 4^{TR} SECTION I
 T-19 N; R-15 W
 HOLMES COUNTY, OHIO
 (SURVEYED BY: FLORENCE MAURER)

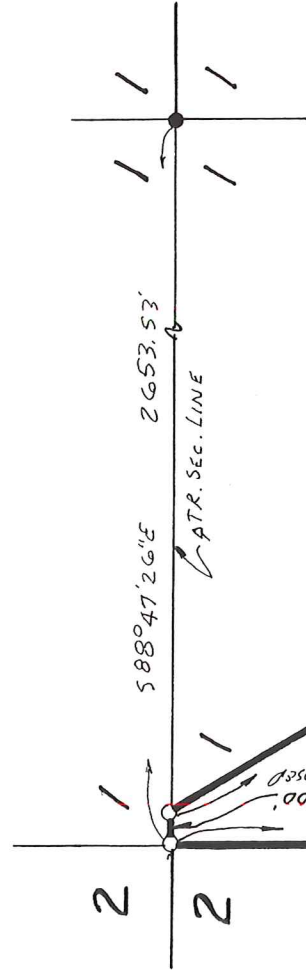

S 28° 39' 16" E
 1114.55' MEAS.
 (1119.36' REC)

ROBERT B. GIBBS
 D.V. 247-916

18.489 ACRES
FLORENCE MAURER
 D.V. 274-199
 (17 1/2 AC. DEED)

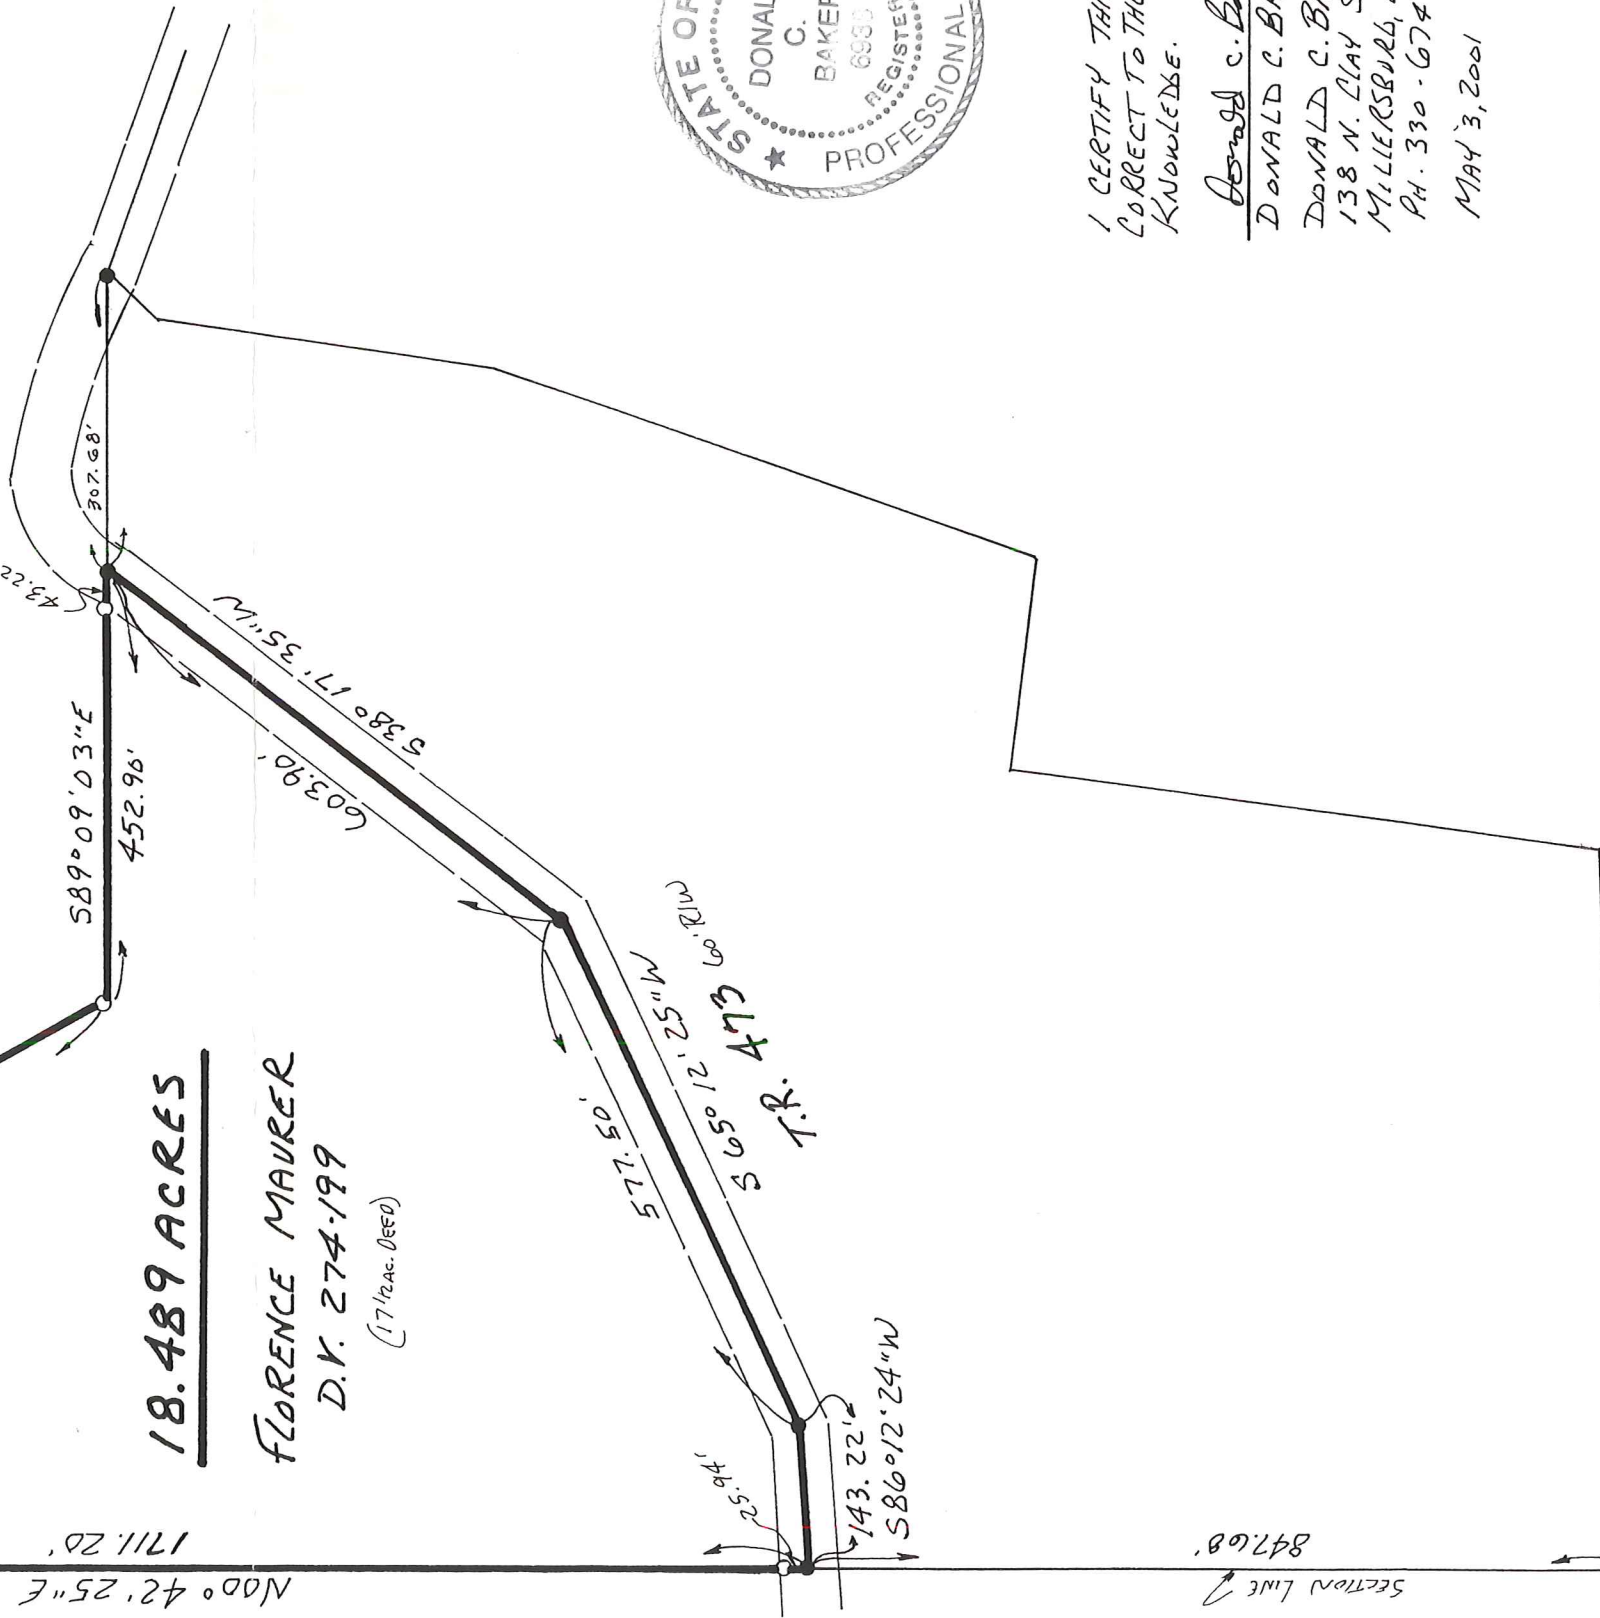

- IRON PIN FOUND
- 5/8" LE BAR WITH I.D. CAP SET
- I.D. CAP MARKED "BAKER 6938"

REFERENCES:

- DEED VOL. 274 PAGE 199
- " " 247 " 916
- " " 219 " 549
- " " 201 " 508
- SURVEY RECORD 5 PAGE 114
- PLAT VOL. 11 PAGE 39
- PLAT VOL. 7 PAGE 165

BEARINGS FROM PLAT VOL 9 PAGE 165



I CERTIFY THIS SURVEY TO BE
 CORRECT TO THE BEST OF MY
 KNOWLEDGE.

Donald C. Baker

DONALD C. BAKER P.S. 6938
 DONALD C. BAKER SURVEYING
 138 N. CLAY ST.
 MILLERSBURG, OHIO 44654
 PH. 330-674-4788

MAY 3, 2001

25001-M.L.DAVIS
 F.C.C.-F.D. Baker

