


# WM. TERRY BURKEY SURVEYING



DAN WILES SURVEY  
 EAST HALF SECTION #4  
 TOWNSHIP 19 RANGE 15  
 WASHINGTON TOWNSHIP  
 HOLMES COUNTY, OHIO  
 COMPLETED JULY 21, 1977

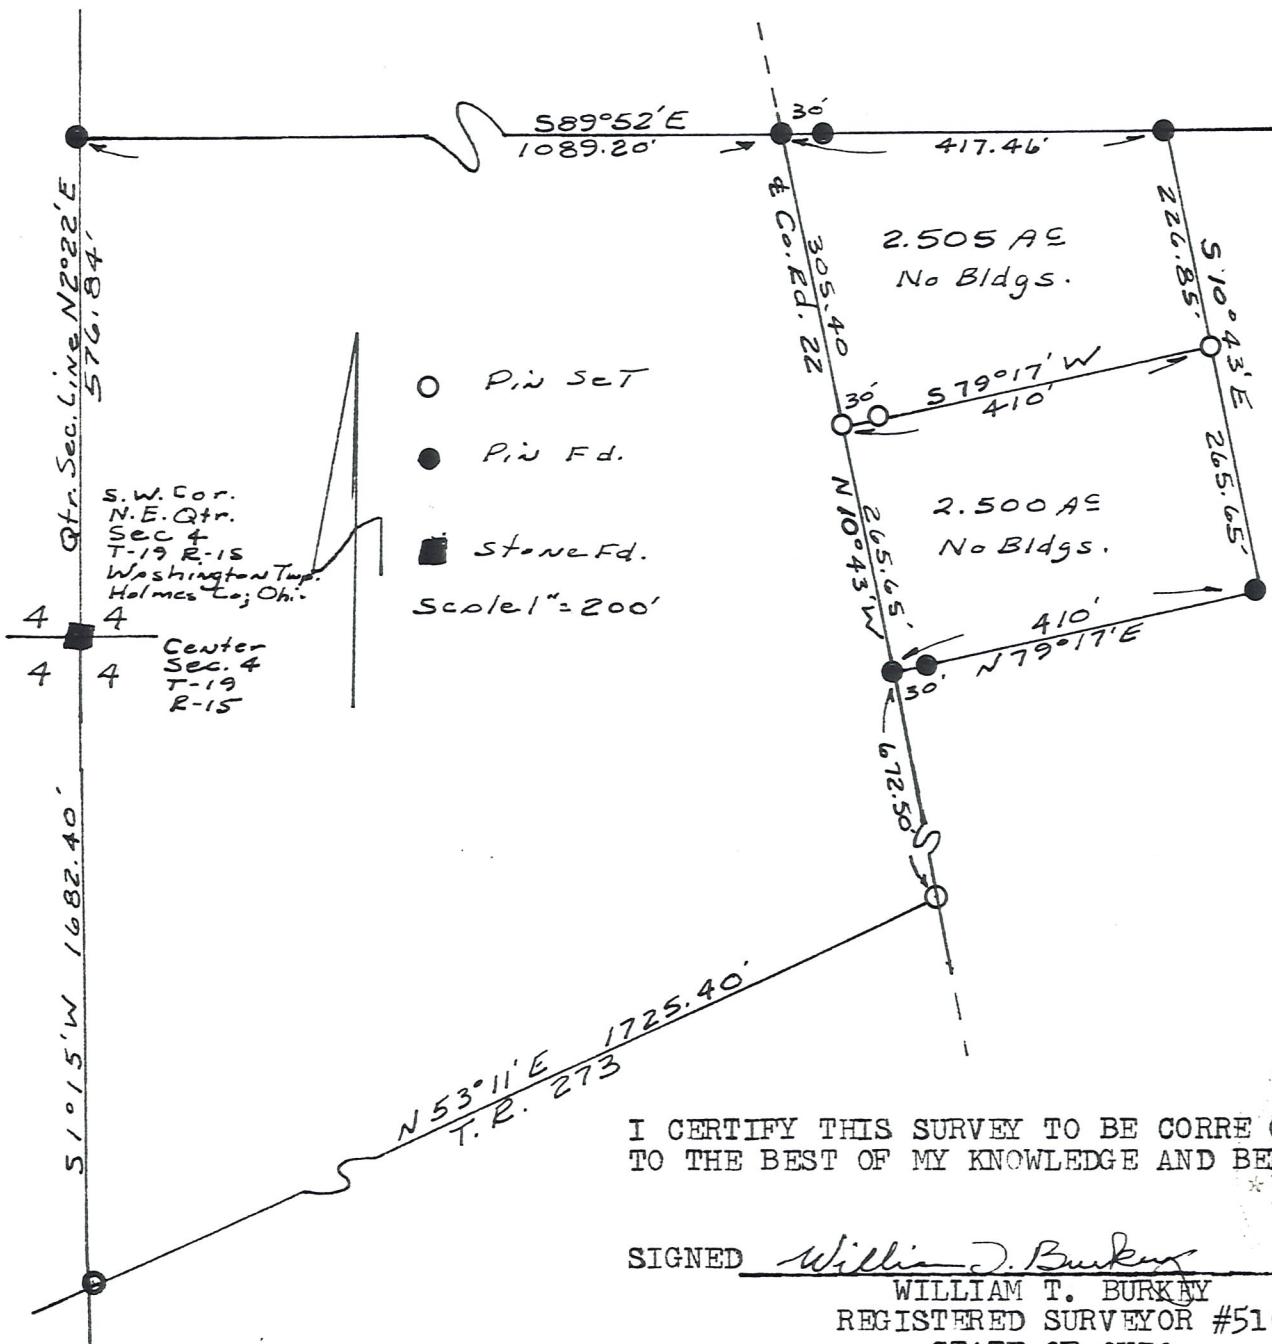

I CERTIFY THIS SURVEY TO BE CORRECT TO THE BEST OF MY KNOWLEDGE AND BELIEF.

SIGNED William T. Burkey  
 WILLIAM T. BURKEY  
 REGISTERED SURVEYOR #5107  
 STATE OF OHIO

