


WM. TERRY BURKEY SURVEYING



PHILLIP BOREMAN SURVEY
 S.E. QUARTER SECTION 4
 N.E. QUARTER SECTION 9
 TOWNSHIP 19 RANGE 15
 WASHINGTON TOWNSHIP
 HOLMES COUNTY, OHIO
 COMPLETED 11/22/1975

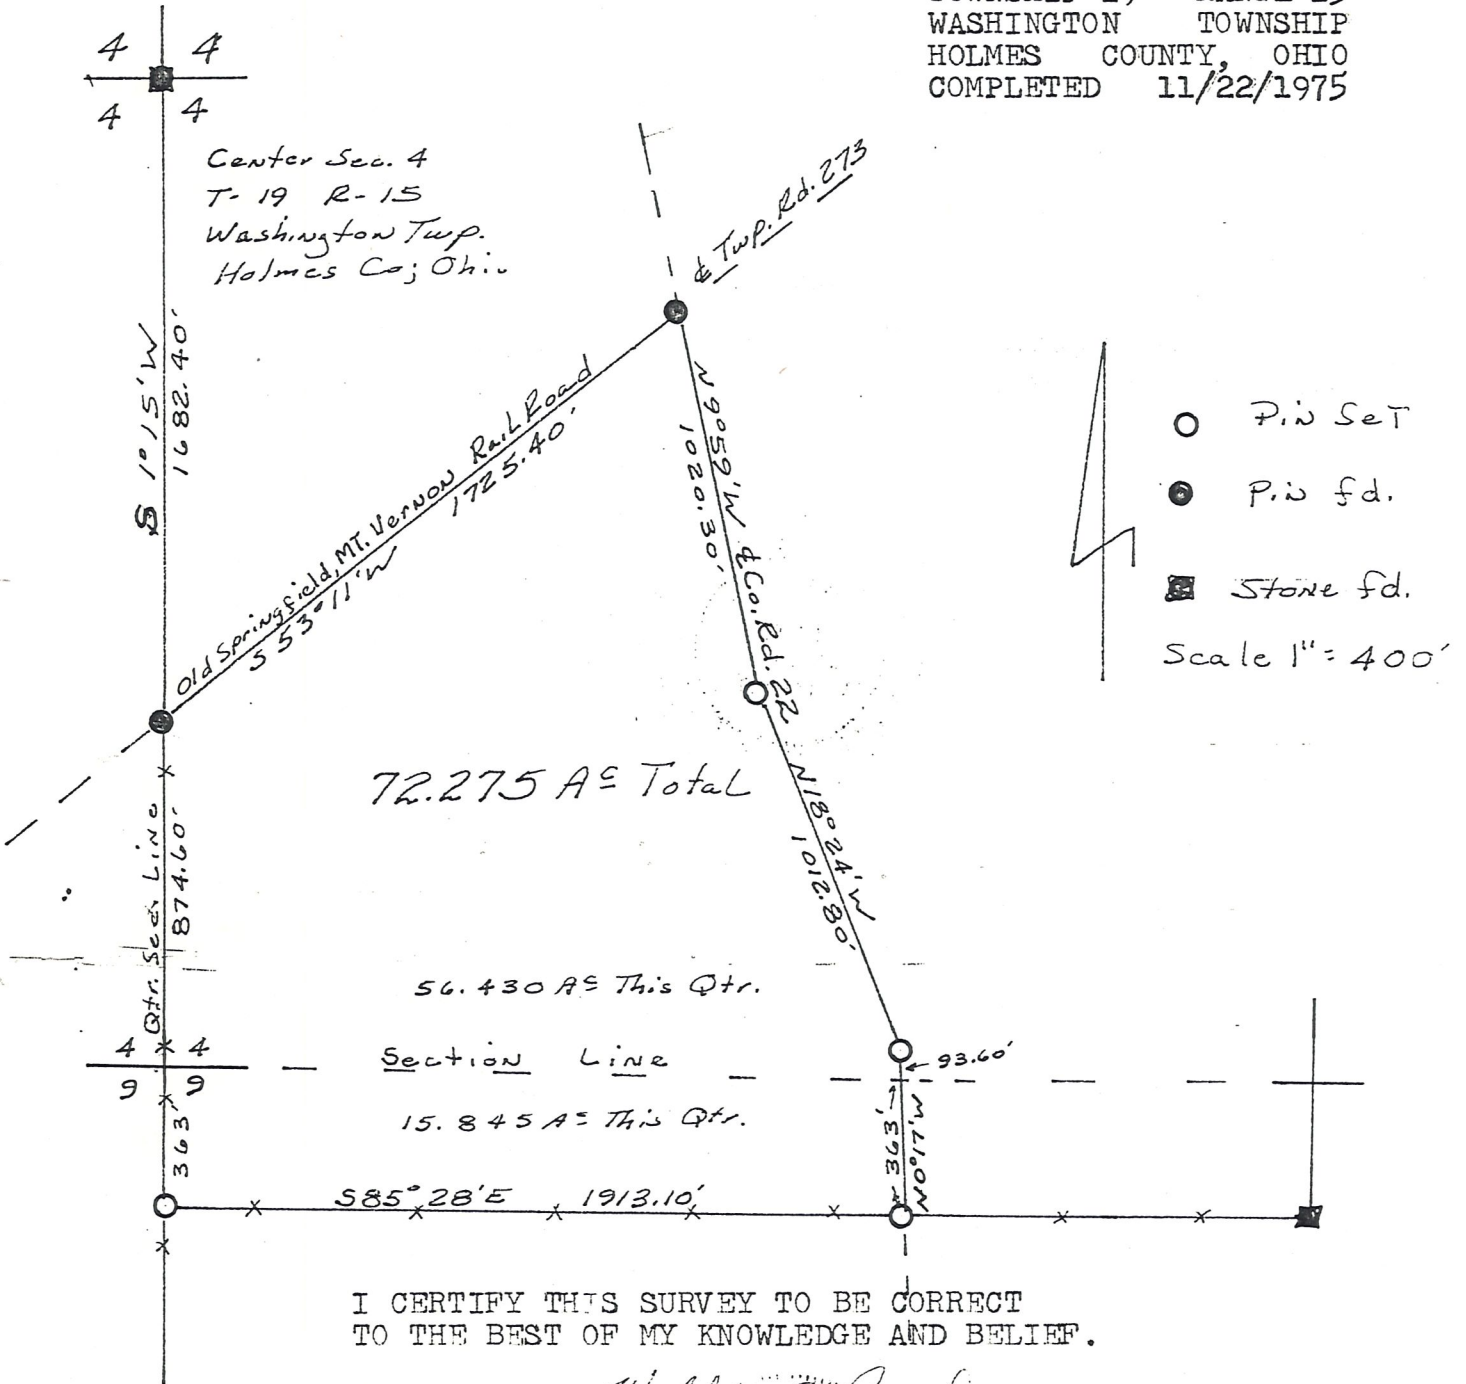

I CERTIFY THIS SURVEY TO BE CORRECT
 TO THE BEST OF MY KNOWLEDGE AND BELIEF.

SIGNED

William T. Burkey
 WILLIAM T. BURKEY
 REGISTERED SURVEYOR #5107
 STATE OF OHIO

