


WASHINGTON TOWNSHIP
 N.W. QTR. SECTION 6
 T-19N; R-15W
 HOLMES COUNTY, OHIO

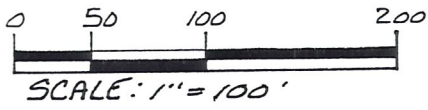


- ▲ R.R. SPIKE FOUND
- IRON PIN FOUND
- △ R.R. SPIKE SET
- 5/8" RE BAR WITH I.D. CAP SET
- I.D. CAP MARKED "BAKER 6938"

REFERENCES:

- PLAT VOL. 4 PAGE 144
- PLAT VOL. 5 PAGE 127
- PLAT VOL. 6 PAGE 132
- PLAT VOL. 5 PAGE 67
- PLAT VOL. 12 PAGE 226
- DEED VOL. 119 PAGE 572
- DEED VOL. 236 PAGE 305
- PLAT VOL. 8 PAGE 356

BEARINGS FROM PLAT VOL. 10
 PAGE 818

- (A) RUTH J. MILLER 214-370, 215-96
- (B) JOHN C. JR. & MYCHELLE R. WALES
248-473 248-475
- (C) THE VILLAGE OF LONDONVILLE
204-408
- (D) EDGAR P. & BARBARA J. HAUDENSCHILD
202-238
- (E) DAVID B. & PAULA M. YOUNG
229-137

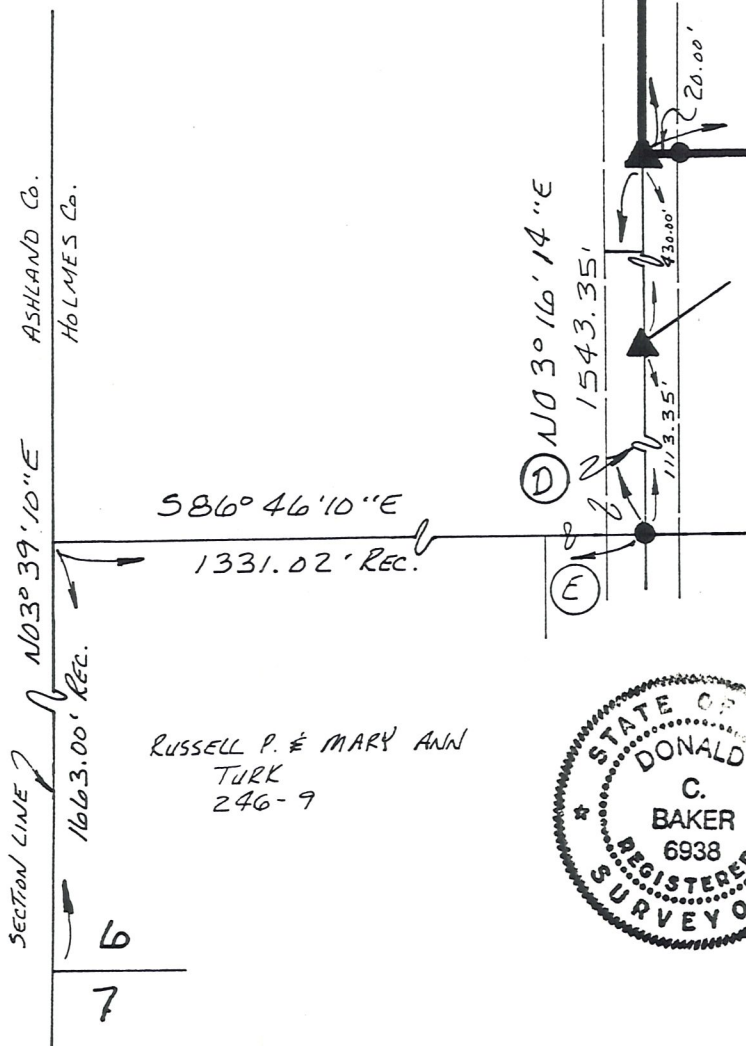

4.483 ACRES
 C. R. & EDNA QUICKLE
 119-572

BRAD A. & LISA D. HARRIS
 236-305

RUSSELL P. & MARY ANN
 TURK
 246-9

I CERTIFY THIS SURVEY TO BE
 CORRECT TO THE BEST OF MY
 KNOWLEDGE.

Donald C. Baker
 DONALD C. BAKER P.S. 6938
 5958 T.R. 322
 MILLERSBURG, OHIO 44654
 PH. (216) 674-4788



AUGUST 31, 1992