


WASHINGTON TOWNSHIP
 S.E. QTR. SECTION 9
 T-19 N; R-15 W
 HOLMES COUNTY, OHIO

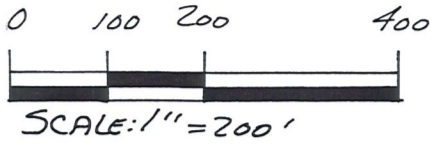


- IRON PIN FOUND
- 5/8" RE BAR WITH I.D. CAP SET I.D. CAP MARKED "BAKER 6938"

REFERENCES:


DEED VOL. 52 PAGE 79
 " " 229 " 81
 " " 211 " 405

BEARINGS ALONG NORTH LINE GRAVEYARD
 FROM DEED VOL. 52 PAGE 79.

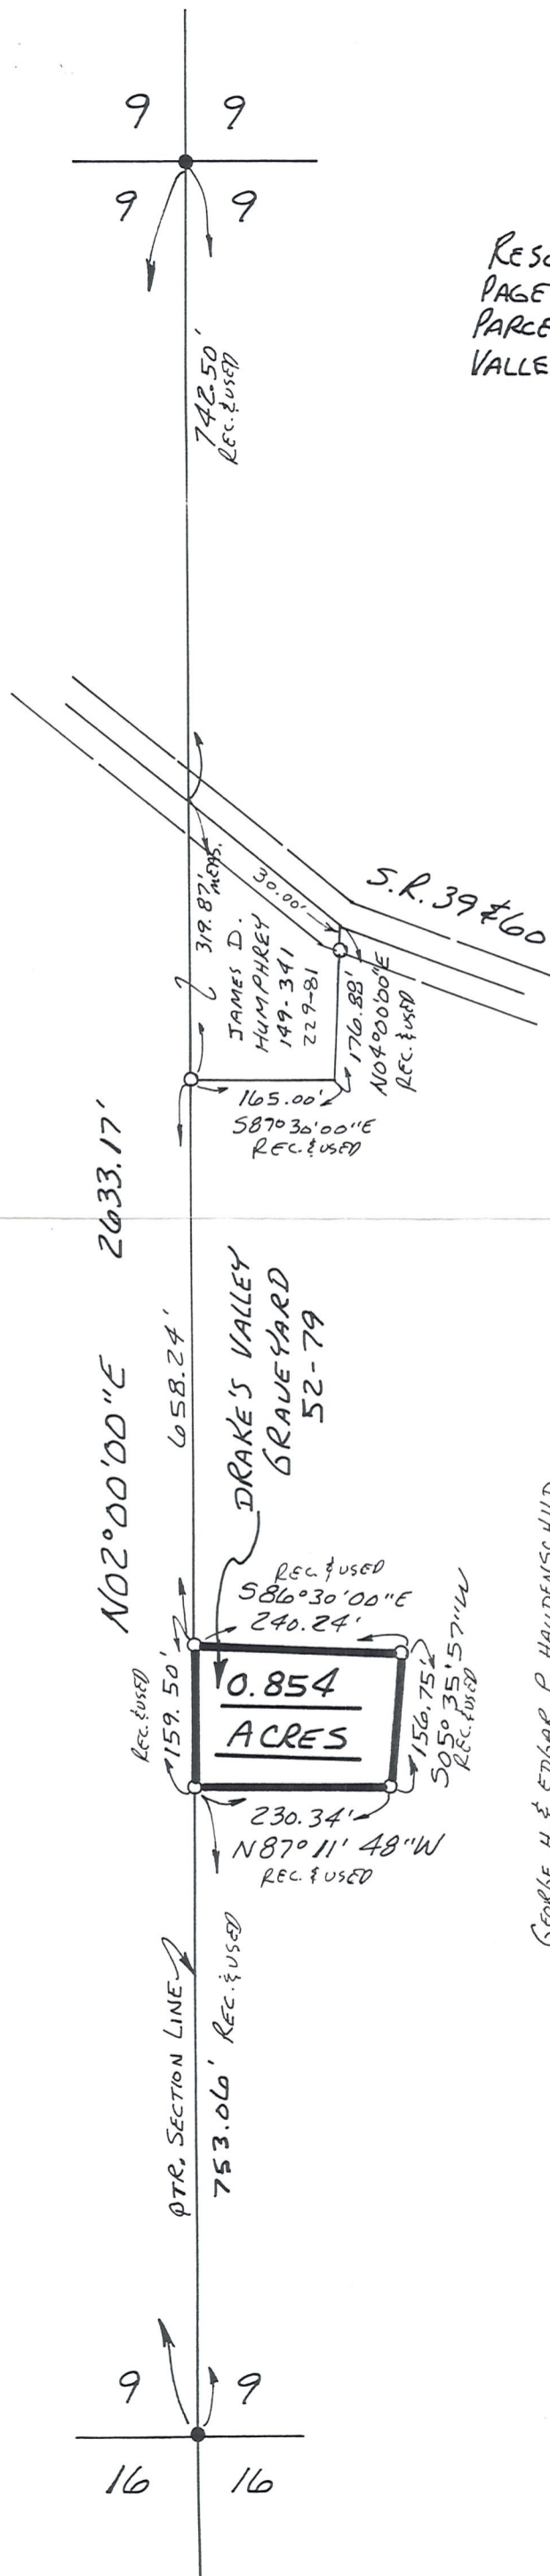

RESURVEY OF DEED VOL. 52
 PAGE 79. BEING A 1 AC. ±
 PARCEL KNOWN AS THE "DRAKE
 VALLEY GRAVEYARD".

GEORGE H. & EDGAR P. HALDENSCHILD
 177-305 230-379 232-295

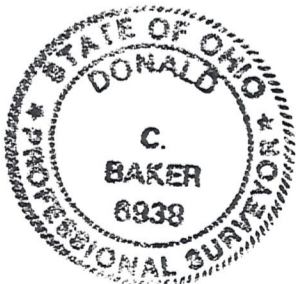

I CERTIFY THIS SURVEY TO BE CORRECT
 TO THE BEST OF MY KNOWLEDGE.

Donald C. Baker

DONALD C. BAKER P.S. 6938
 5958 T.R. 322
 MILLERSBURG, OHIO 44654
 PH. (216) 674-4788
 JANUARY 16, 1996

58095-MLS