


WASHINGTON TOWNSHIP  
 N.W. & S.W. QTRS. SECTION 9  
 T- 19 N R- 15 W  
 HOLMES COUNTY, OHIO

(SURVEYED FOR JAMIE HUMPHREY)

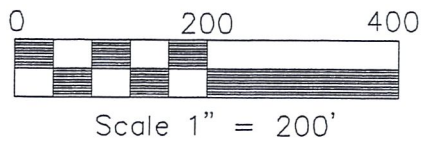

● P.K. NAIL FOUND

● IRON PIN FOUND

○ 5/8" REBAR WITH I.D. CAP SET  
 I.D. CAP MARKED "BAKER 6938"

RECEIVED  
 OCT 11 2002  
 Hol. Co. Tax Map Office



REFERENCES:

DEED VOL. 149 PAGE 341  
 DEED VOL. 229 PAGE 81

O.R. VOL. 27 PAGE 677

PLAT VOL. 17 PAGE 26

BEARINGS FROM PLAT VOL. 17 PAGE 26

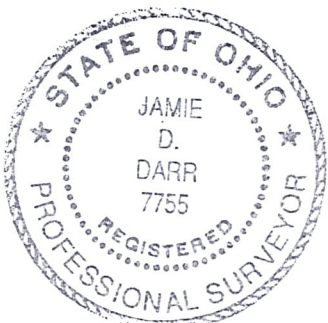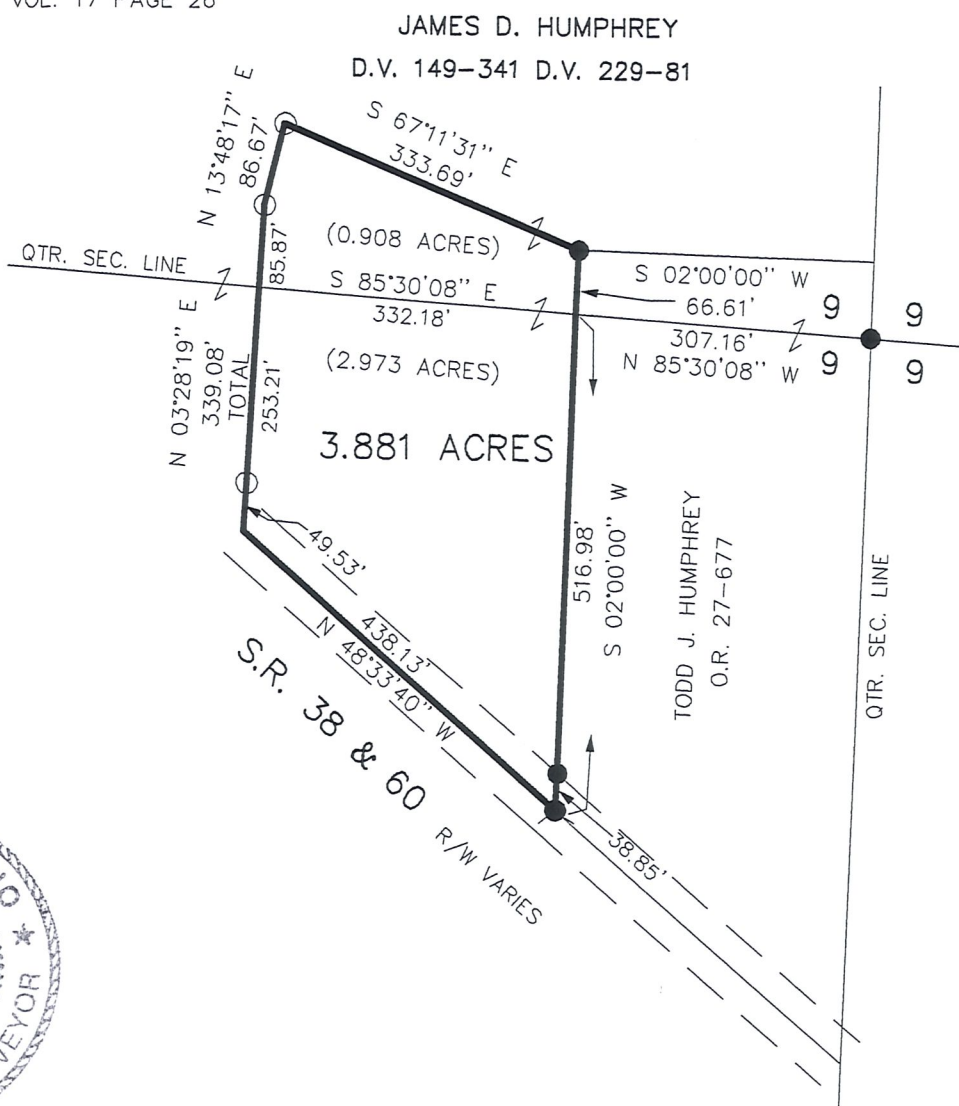

I CERTIFY THIS SURVEY TO BE CORRECT  
 TO THE BEST OF MY KNOWLEDGE.

JAMIE D. DARR P.S. 7755

JDD/ FCC DATE: OCTOBER 8, 2002

File name: C:\JOBS1\S-705-02/EZ-MD



DONALD C. BAKER SURVEYING  
 138 N. CLAY ST.  
 MILLERSBURG, OHIO 44654  
 PH. 330-674-4788  
 FAX 330-674-6027