


WASHINGTON TOWNSHIP  
 S.E. QTR. SECTION 11  
 T-19 N; R-15 W  
 HOLMES COUNTY, OHIO

SURVEYED FOR: DWAYNE COBLENTZ

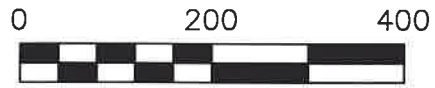

SCALE: 1"=200'

- ▲ R.R. SPIKE FOUND
- 5/8" REBAR FOUND UNLESS OTHERWISE NOTED
- 5/8" REBAR SET WITH I.D. CAP I.D. CAP MARKED "BAKER SURVEYING LLC"

REFERENCES

DEED VOL. 252 PAGE 64  
 O.R. VOL. 237 PAGE 657  
 PLAT VOL. 19 PAGE 1491  
 PLAT VOL. 13 PAGE 138  
 PLAT VOL. 19 PAGE 1811

BASIS OF BEARINGS FROM  
 OHIO STATE PLANE COORDINATE  
 SYSTEM, NORTH ZONE, N.A.D. 83



I CERTIFY THIS SURVEY TO BE CORRECT  
 TO THE BEST OF MY KNOWLEDGE.


*Donald C. Baker*  
 DONALD C. BAKER

P.S. 6938

DATE: JULY 10, 2020

KES\GRB

FILE NAME: WORK6\S-350-20\CNK

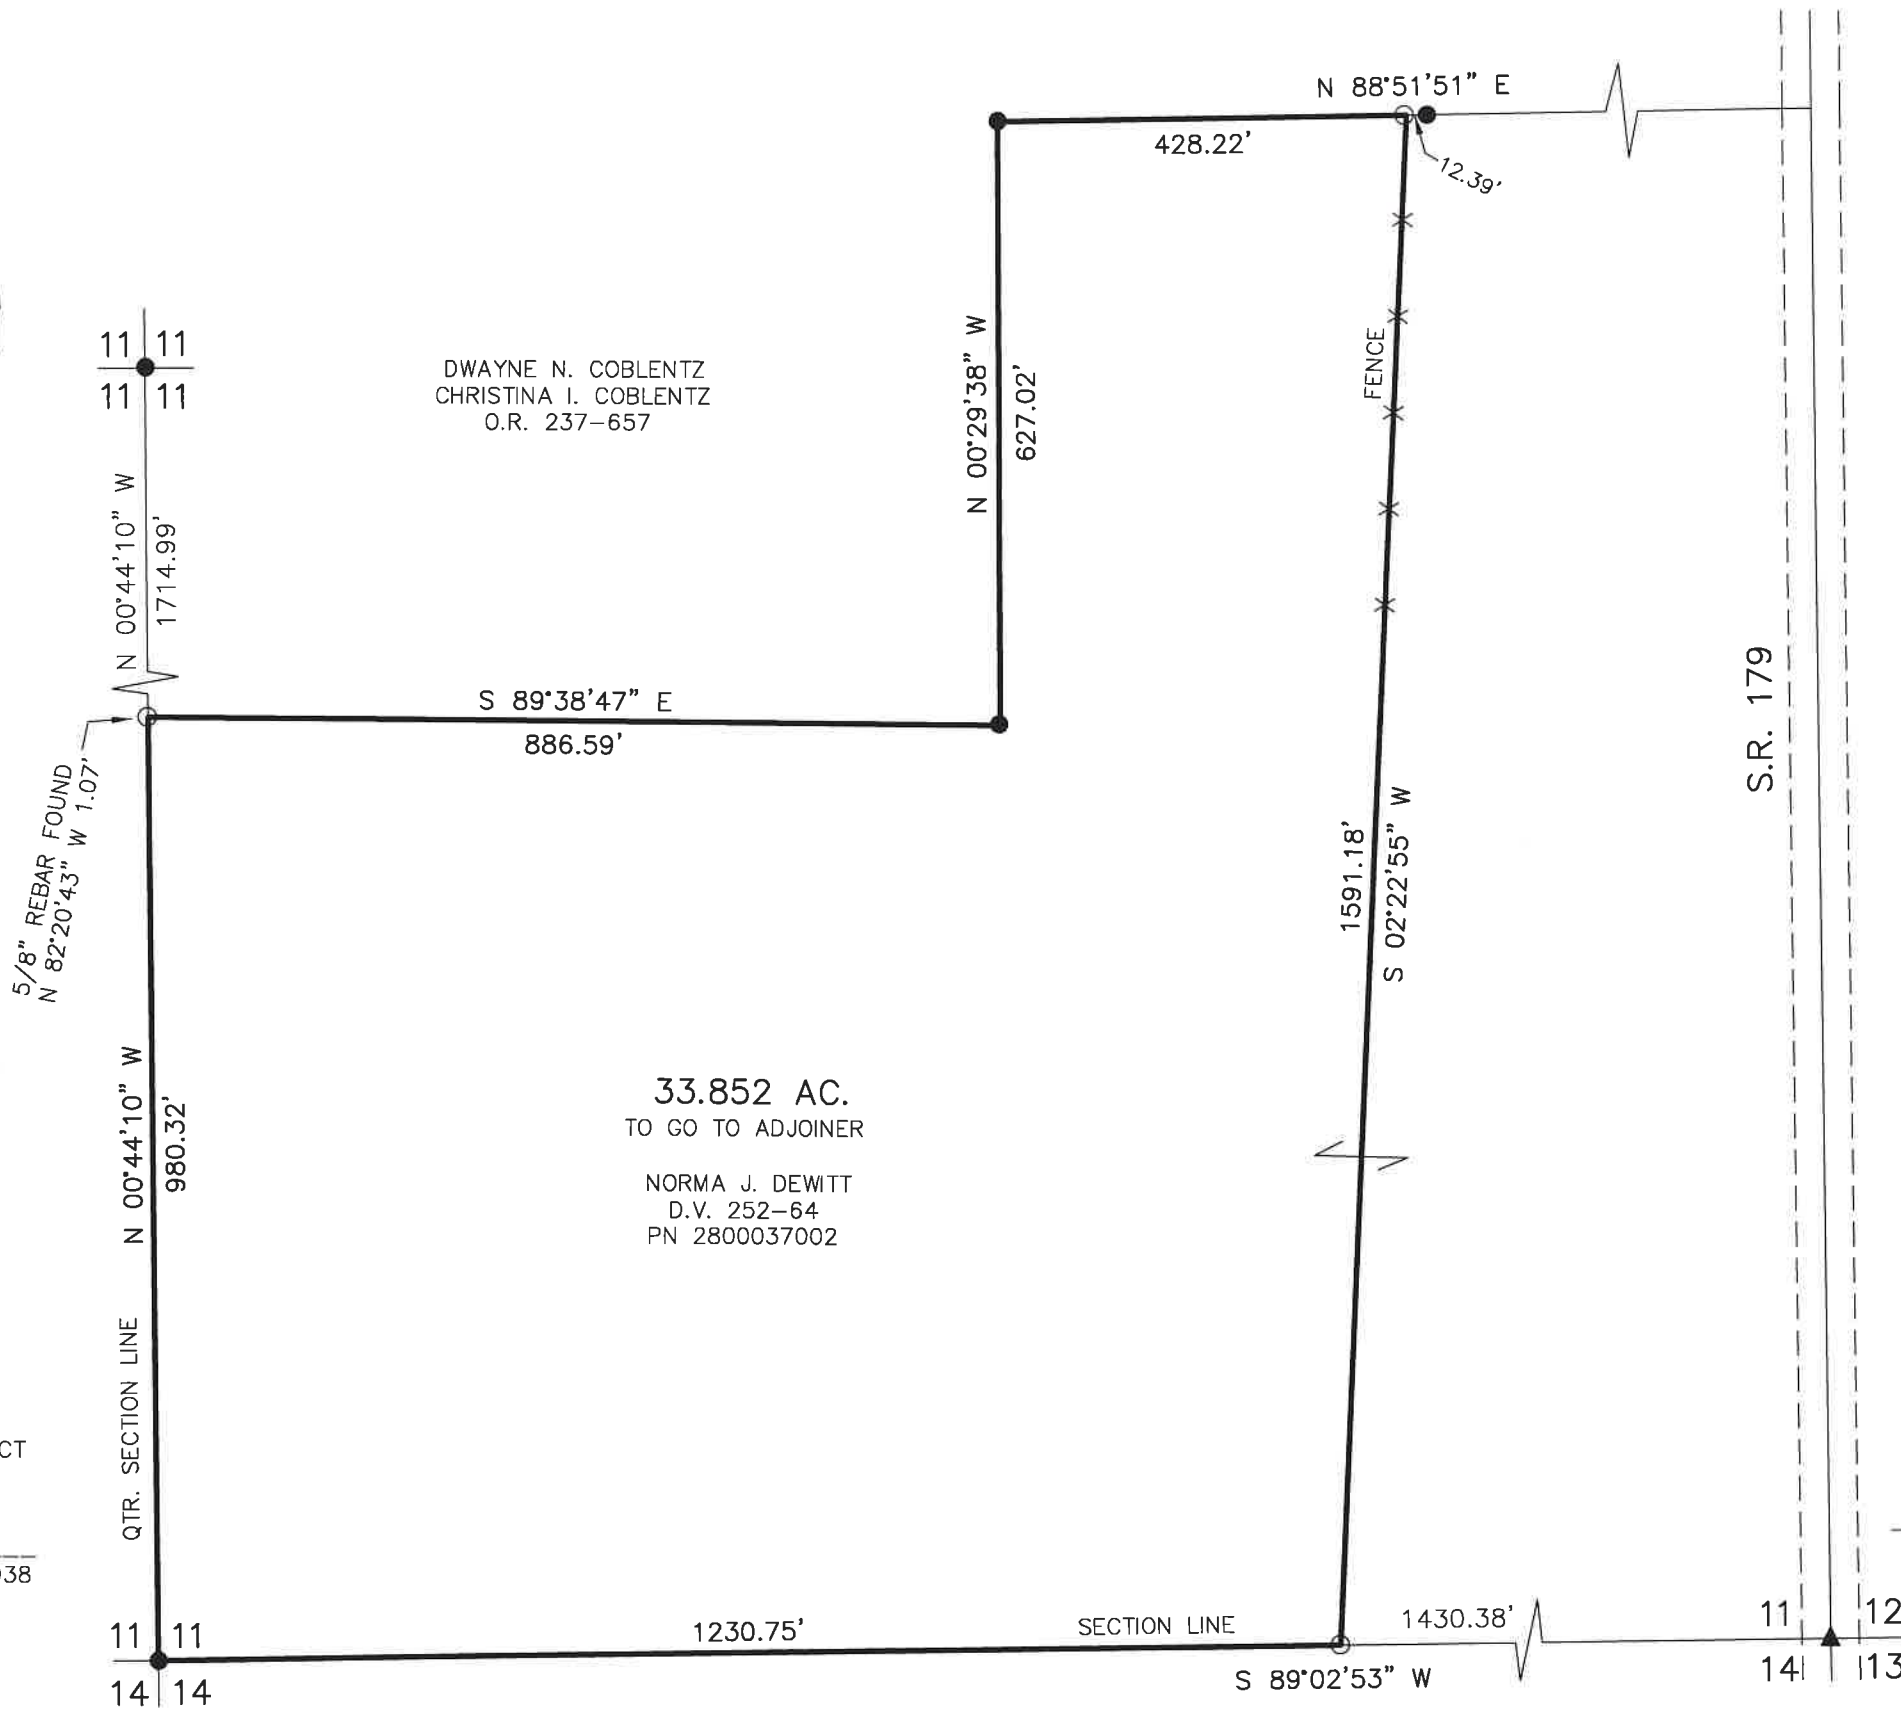

BAKER SURVEYING, LLC  
 138 N. CLAY STREET  
 MILLERSBURG, OHIO 44654  
 PH. 330-674-4788  
 EMAIL: bakersurveying@gmail.com