


Ref. W.O. 14° N 70° W 48 1/2' L
 " " 12° S 49 1/2' W 121' L
 3.21 ch.
 58 M.
 100 M.
 3.25 ch.
 N 3° 45' E
 3.87 ch.
 Fence joined
 on this post
 P. F. W. & C. R. R.

Lined across Lake.

LAKE ODELL

PLAT OF
 S. E. Q. of the North East Quarter of
 Section 25. T. 20. R. 15.
 Surveyed North and east lines and established
 northwest and Northeast corners
 July 11 and Nov. 11. 1924. by
 W L Reidenbach
 Deputy Co. Surveyor.

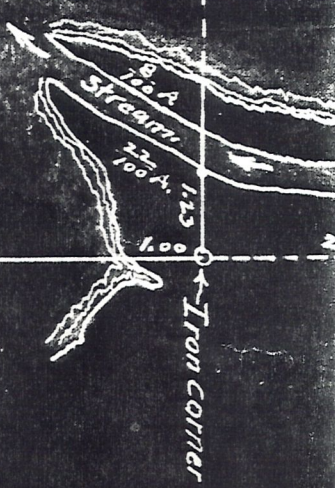

20.07 1/2 ch.

Iron corner