


WASHINGTON TOWNSHIP
 S.W. QTR. SECTION 25
 T-20N; R-15W
 HOLMES COUNTY, OHIO

LAKEVIEW PARK SUB. NO. 1
 LOTS 17 & 18




(PLAT VOL. 1 PAGE 383-384)

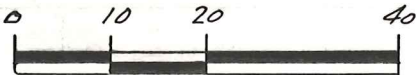

SCALE: 1" = 20'

- IRON PIN FOUND
- 5/8" RE BAR WITH I.D. CAP SET
- I.D. CAP MARKED "BAKER 6938"

BEARINGS FROM PLAT VOL. 13 PAGE 68

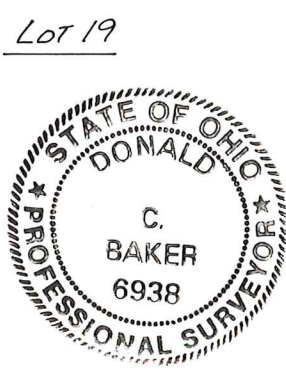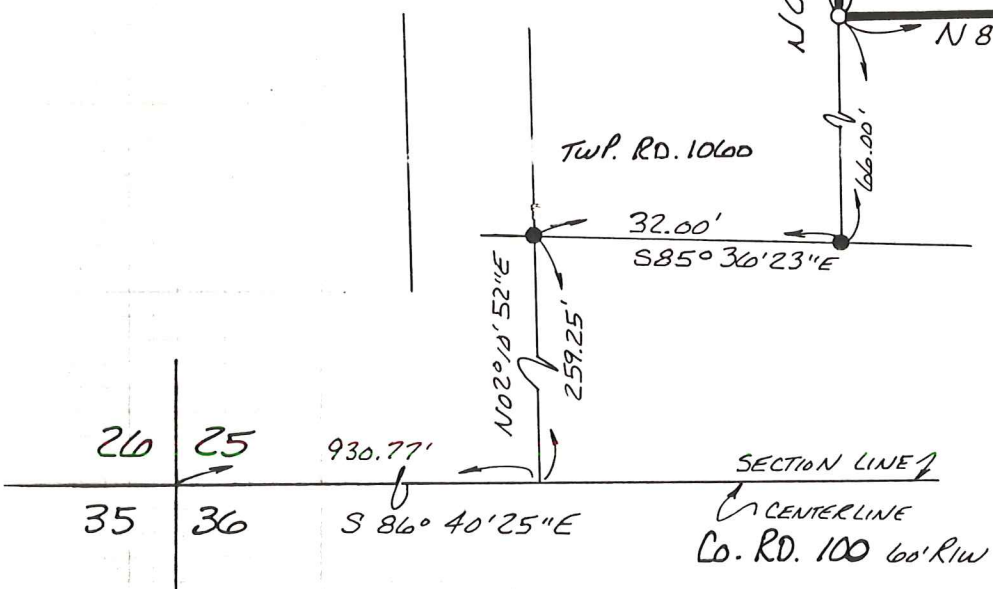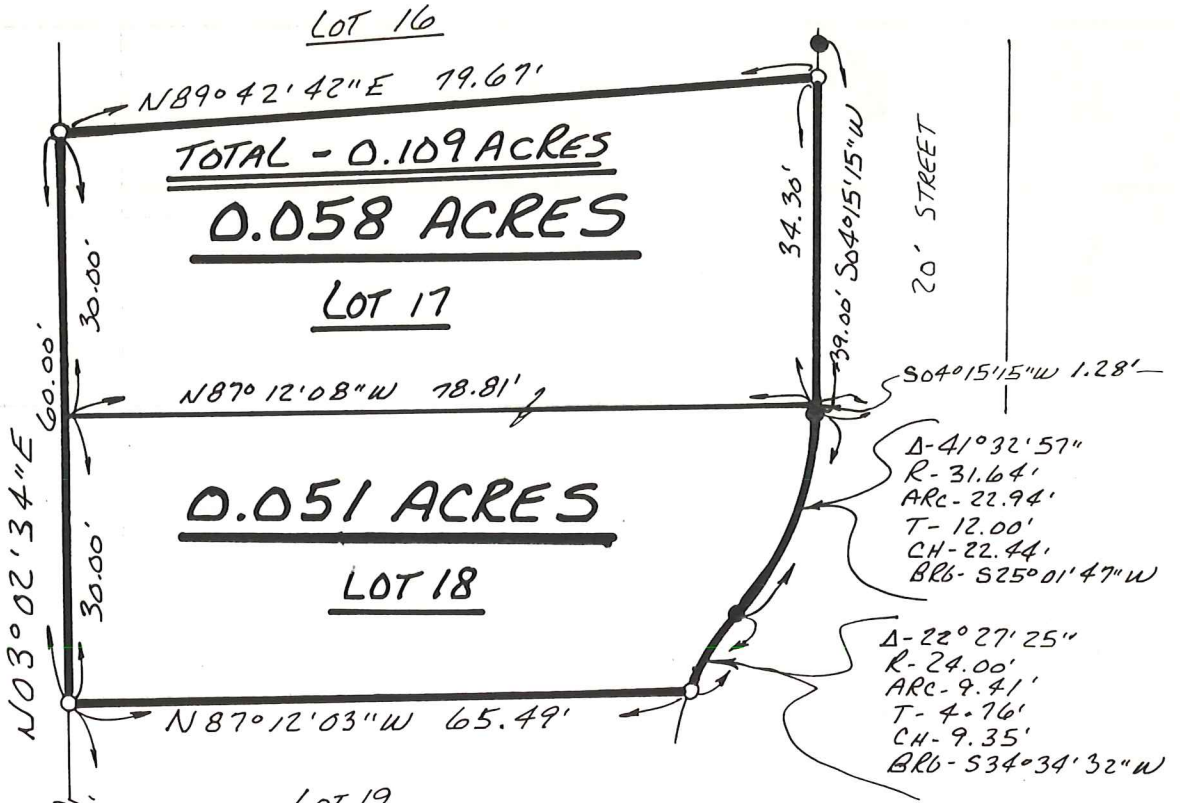

I CERTIFY THIS SURVEY TO BE
 CORRECT TO THE BEST OF MY
 KNOWLEDGE.

Donald C. Baker
 DONALD C. BAKER P.S. 6938
 5958 T.R. 322
 MILLERSBURG, OHIO 44654
 PH (216) 674-4788
 JULY 15, 1994

38894-115