

**REFERENCES:**

DEED Vol. 176 PAGE 574  
 " " 226 " 841  
 " " 279 " 925


BEARINGS FROM PLAT VOL. 5 PAGE 120

**WASHINGTON TOWNSHIP**  
**N.E. QTR. SECTION 25**  
**T-20N; R-15W**  
**HOLMES COUNTY, OHIO**  
 (SURVEYED FOR KEN & MARCELLA BAUER)

0 30 60 120  
**SCALE: 1" = 60'**


RECEIVED  
 MAR 26 1999  
 Hol. Co. Tax Map Office

● IRON PIN FOUND  
 ○ 5/8" REBAR WITH I.D. CAP SET  
 I.D. CAP MARKED "BAKER 6938"

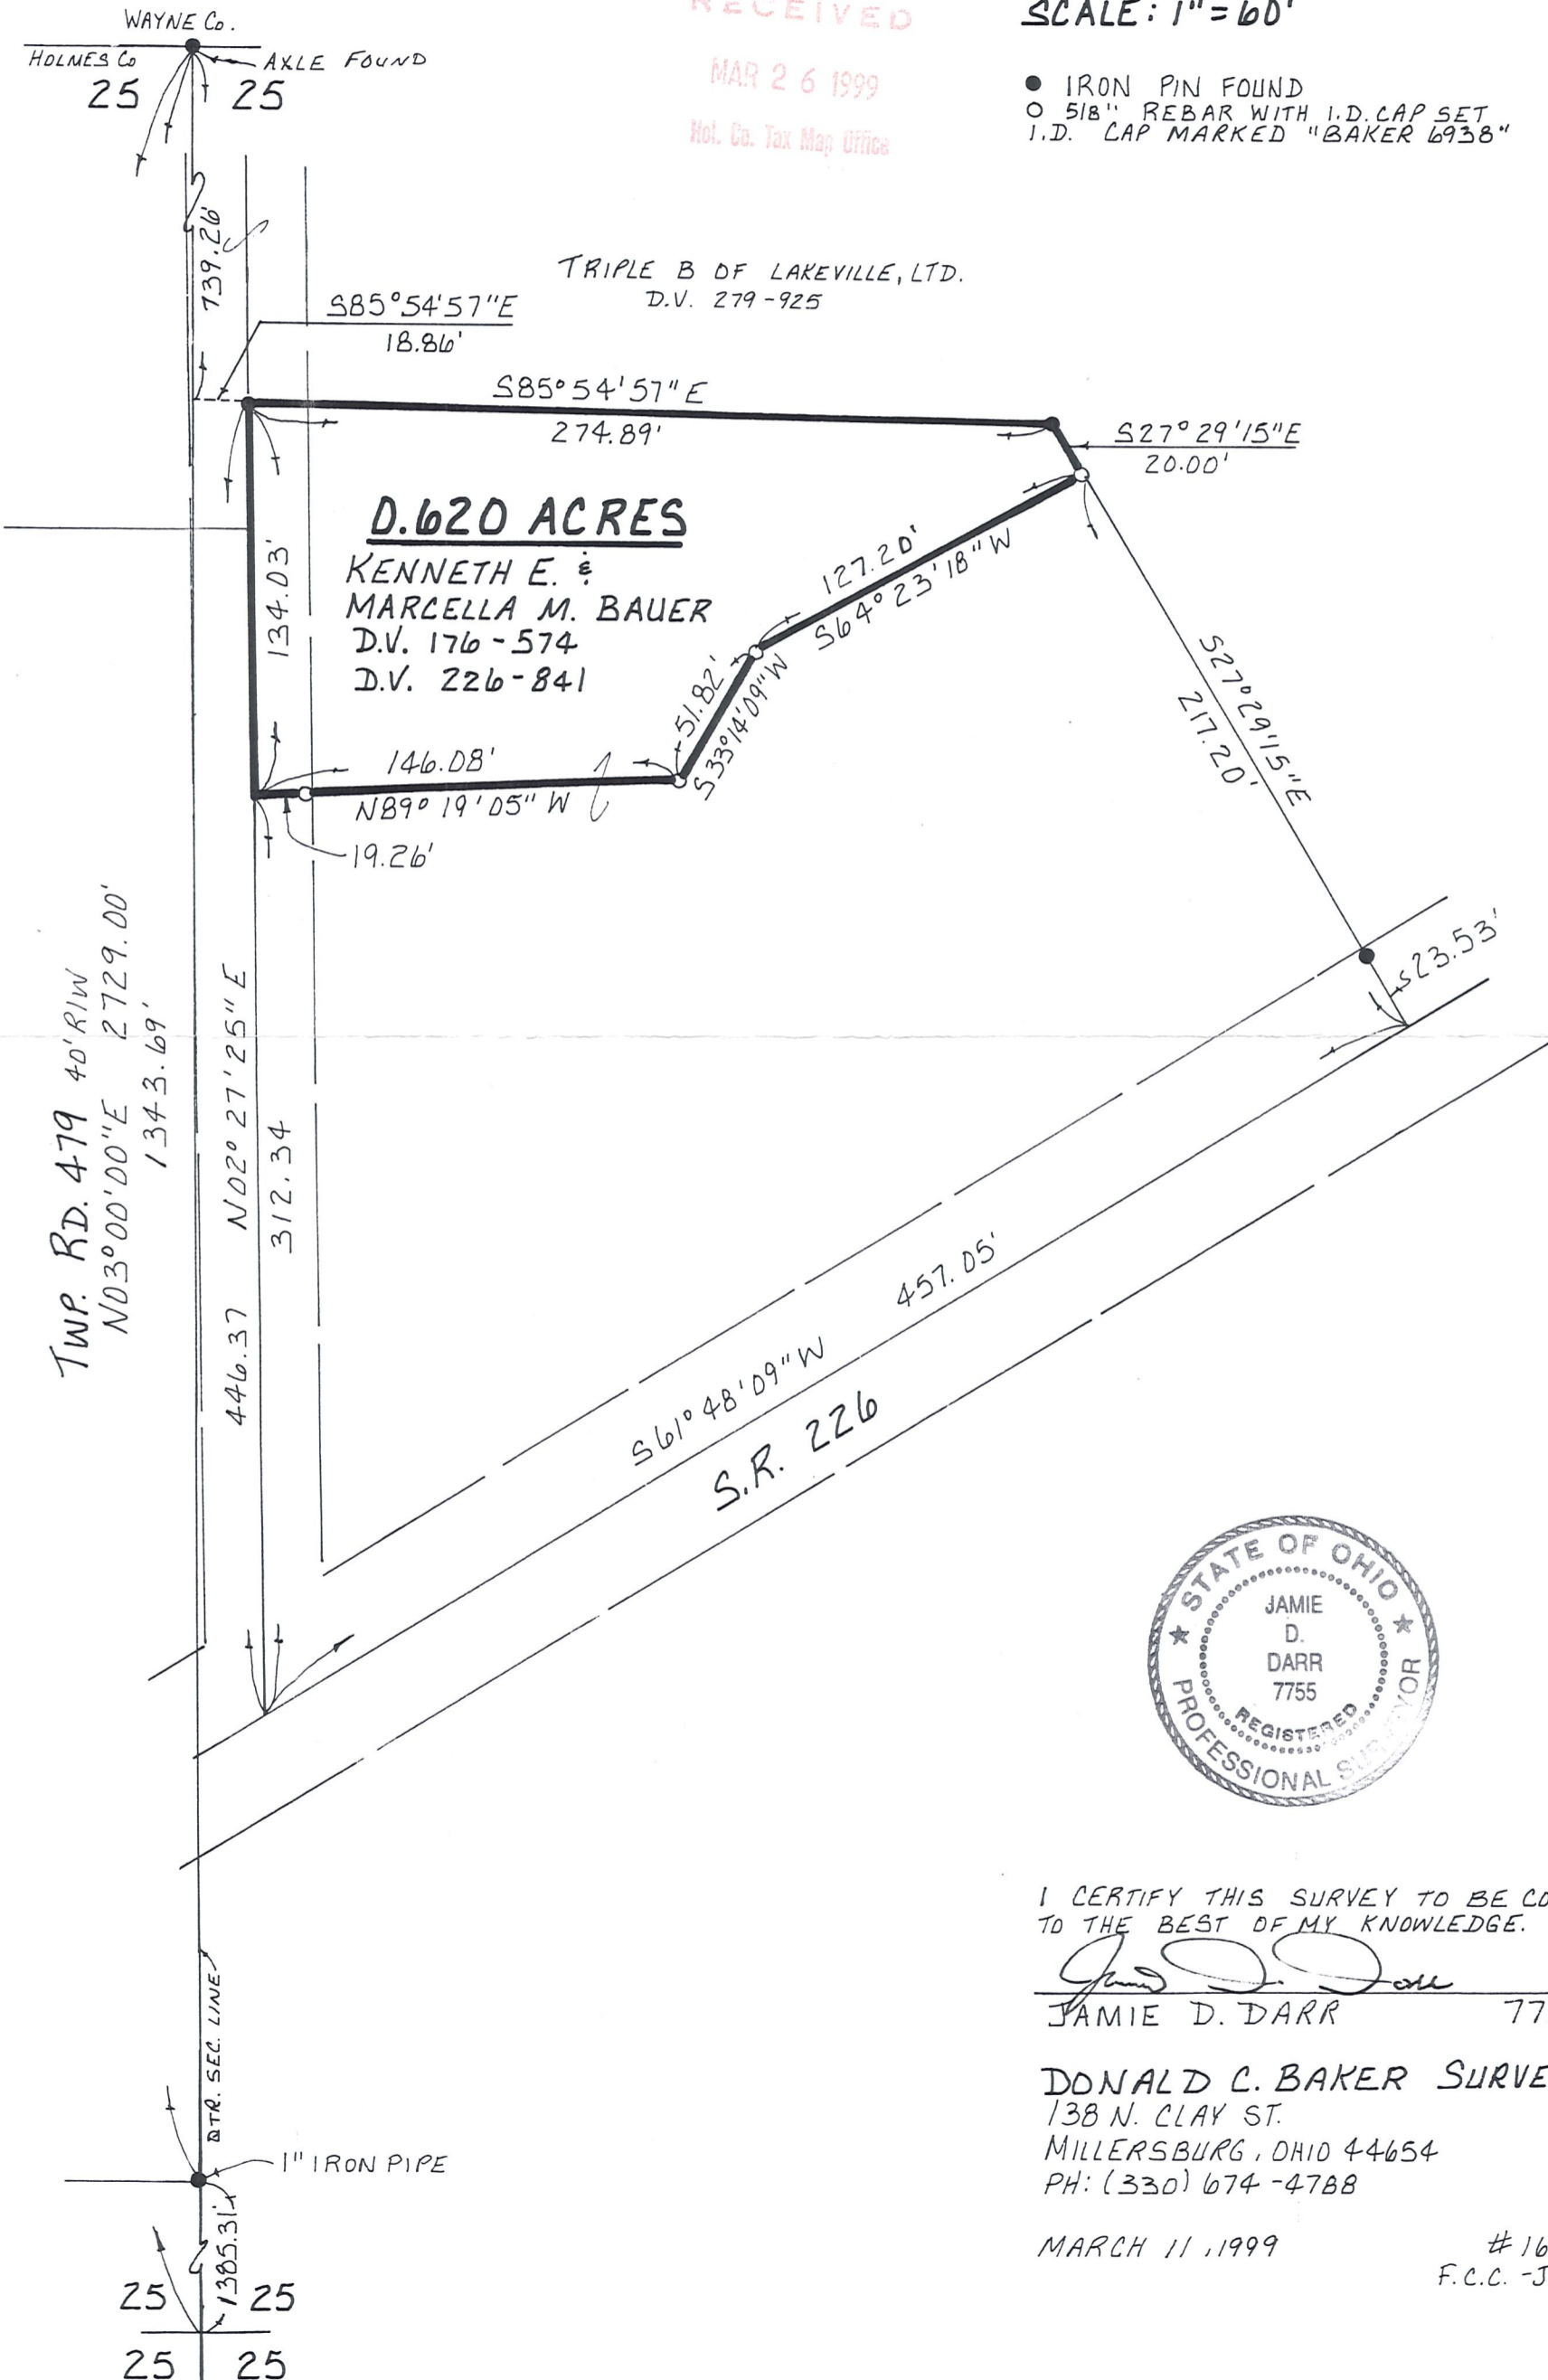

**0.620 ACRES**  
**KENNETH E. &**  
**MARCELLA M. BAUER**  
 D.V. 176-574  
 D.V. 226-841

TRIPLE B OF LAKEVILLE, LTD.  
 D.V. 279-925

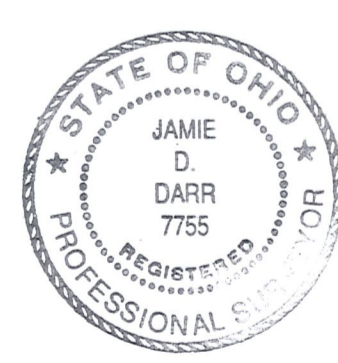

I CERTIFY THIS SURVEY TO BE CORRECT TO THE BEST OF MY KNOWLEDGE.

*Jamie D. Darr*  
 JAMIE D. DARR 7755

DONALD C. BAKER SURVEYING  
 138 N. CLAY ST.  
 MILLERSBURG, OHIO 44654  
 PH: (330) 674-4788

MARCH 11, 1999 #16899-FJM  
 F.C.C. - J.D. DARR