


1902.

40 feet wide.

Bonnets Lake

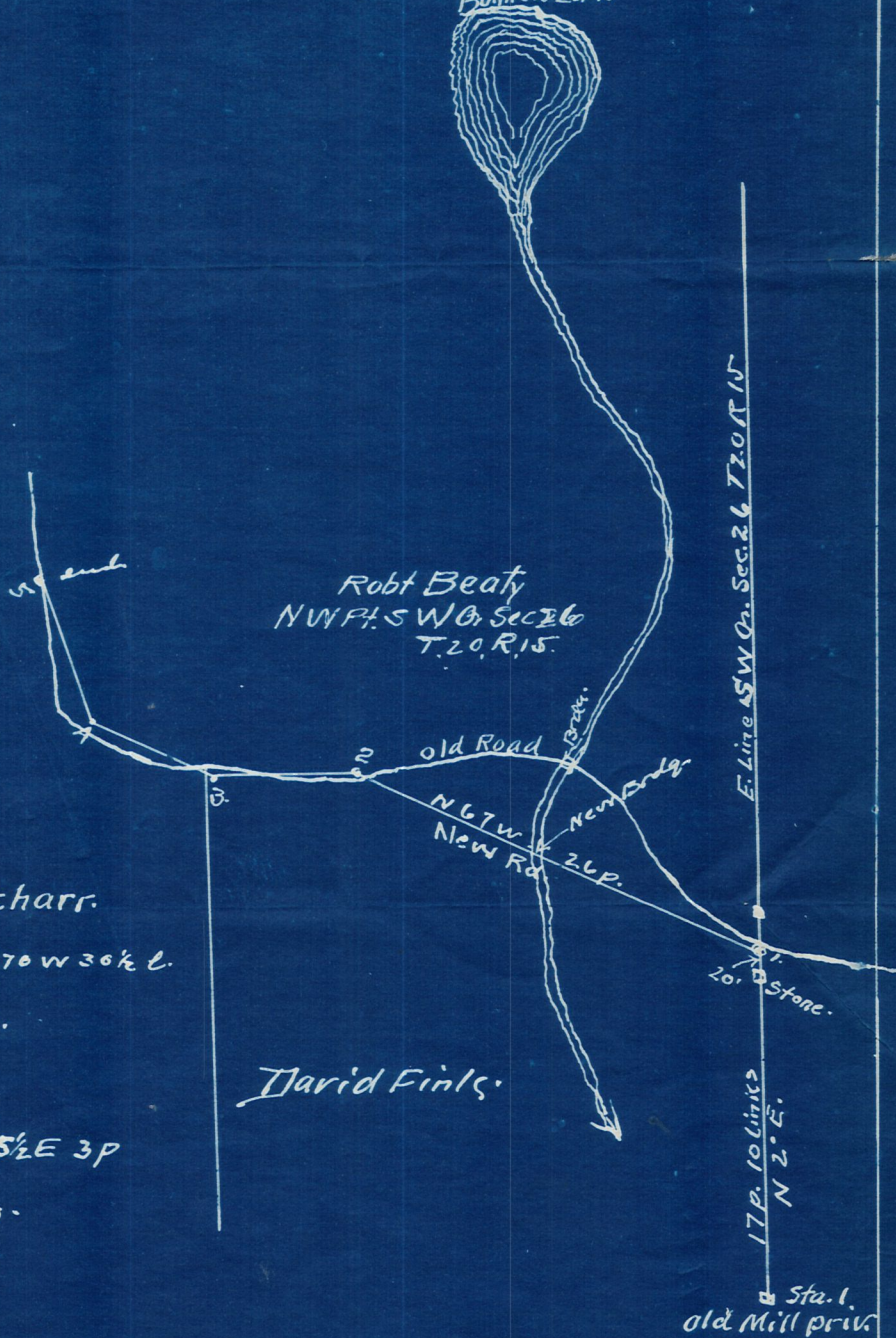

David Finley