



WASHINGTON TOWNSHIP
 S.W. QTR. SECTION 31-T-20N, R-15W
 N.W. QTR. SECTION 6-T-19N, R-15W

VILLAGE OF LOUDONVILLE
 HOLMES COUNTY, OHIO

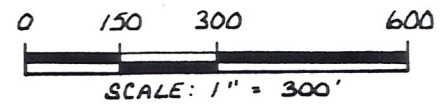

- IRON PIN FOUND
- 5/8" REBAR WITH I.D. CAP SET I.D. CAP MARKED "BAKER 6938"

BEARINGS FROM PLAT VOL. 8 PAGE 49.

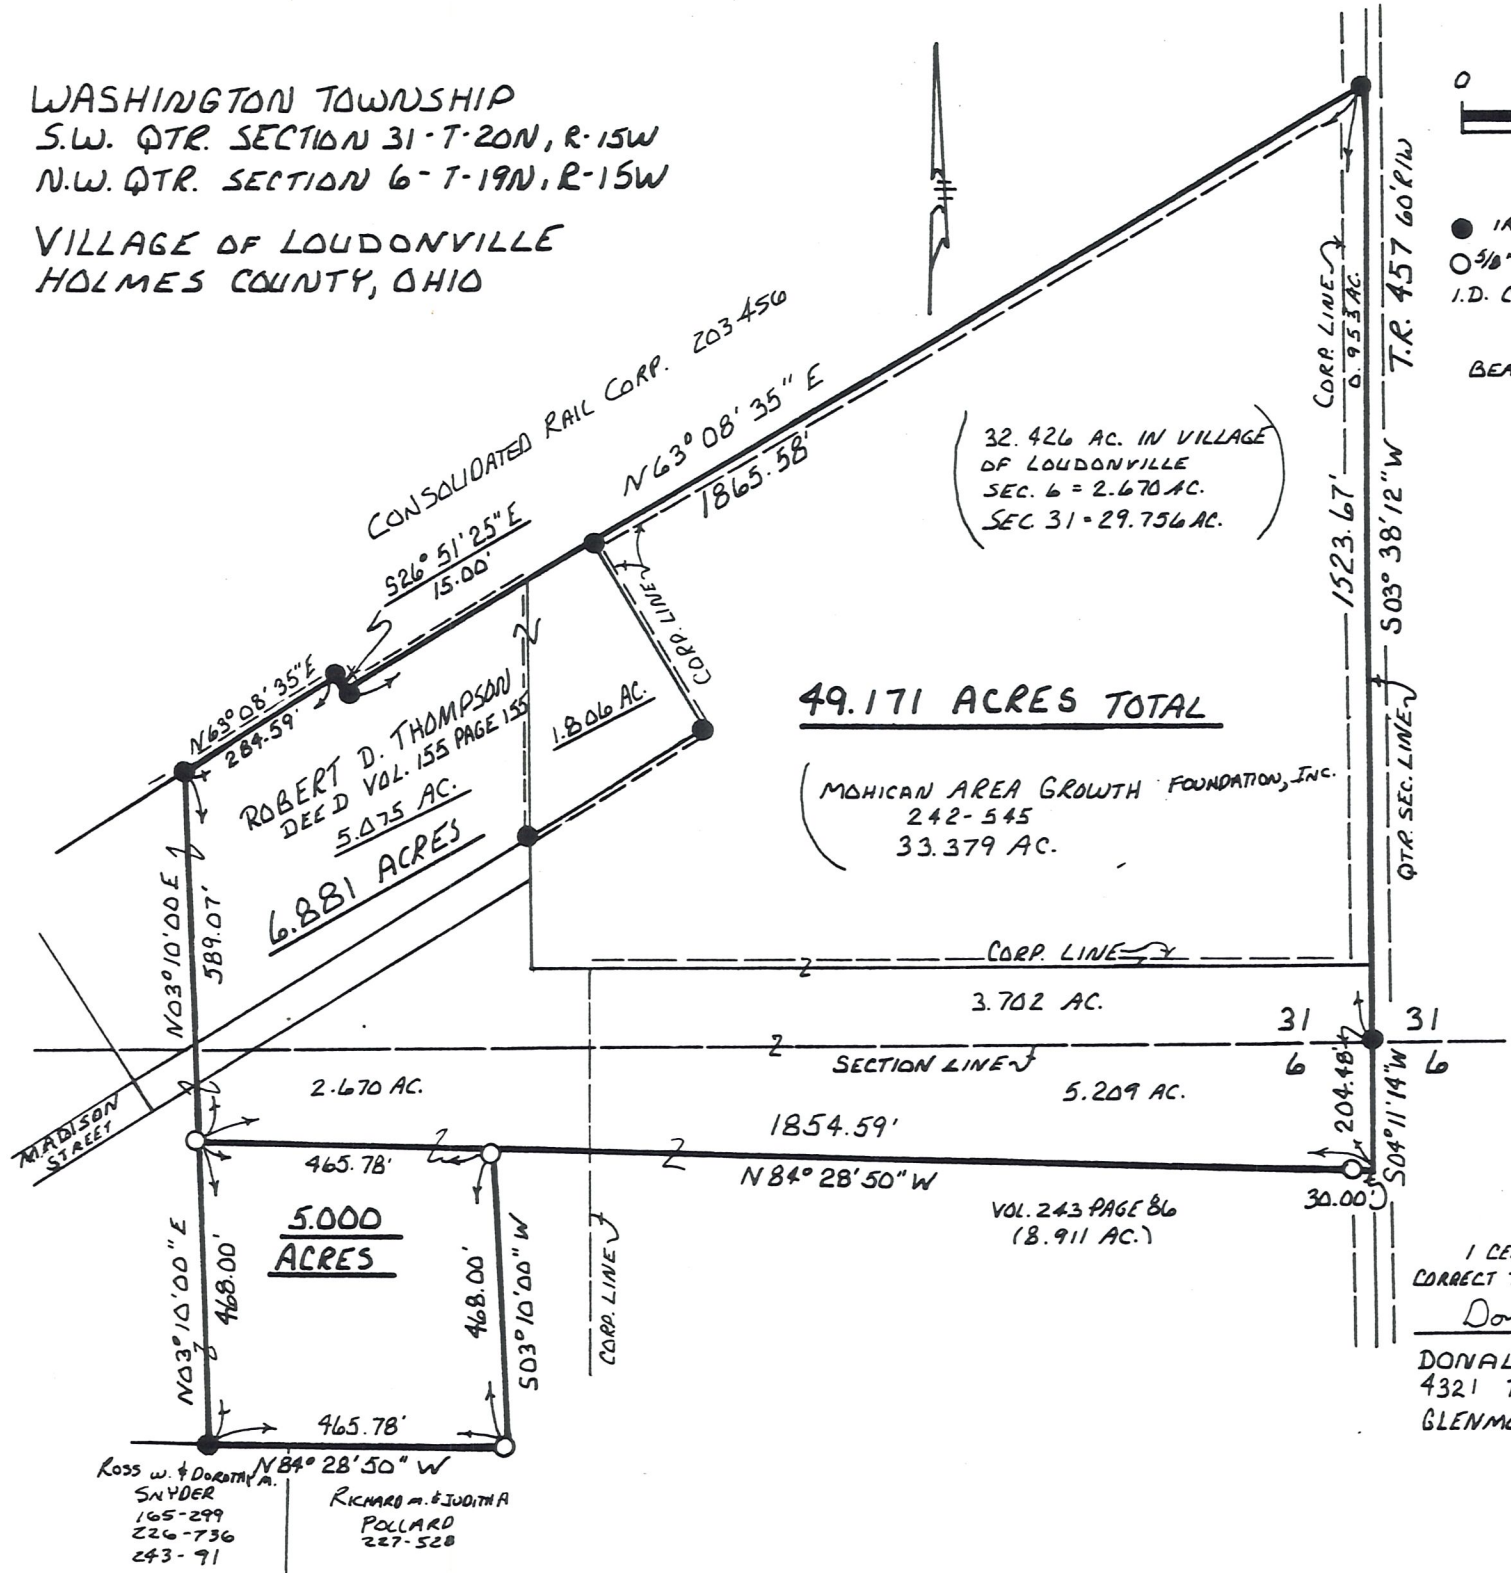

I CERTIFY THIS SURVEY TO BE
 CORRECT TO THE BEST OF MY KNOWLEDGE.
 Donald C. Baker
 DONALD C. BAKER P.S. 6938
 4321 T.R. 252
 GLENMONT, OHIO

JULY 28, 1989