

N^o 176


ANDY TROYER CEMETERY

HOLMES CO. CLARK TWP.

OFFICIAL PROJECT NOS. 465-42-3-467
665-42-3-232

LEGEND	HISTORY
① REVOLUTIONARY WAR. PART OF ORIGINAL	⑩ WAR OF 1812. U.S. MILITARY GRANT.
⑫ WAR WITH MEXICO. CEM. ESTABLISHED	⑬ CIVIL WAR. ABOUT 1868.
⑭ SPANISH-AM. WAR.	⑮ WORLD WAR.

SCALE 20' = 1" .023 ACRE

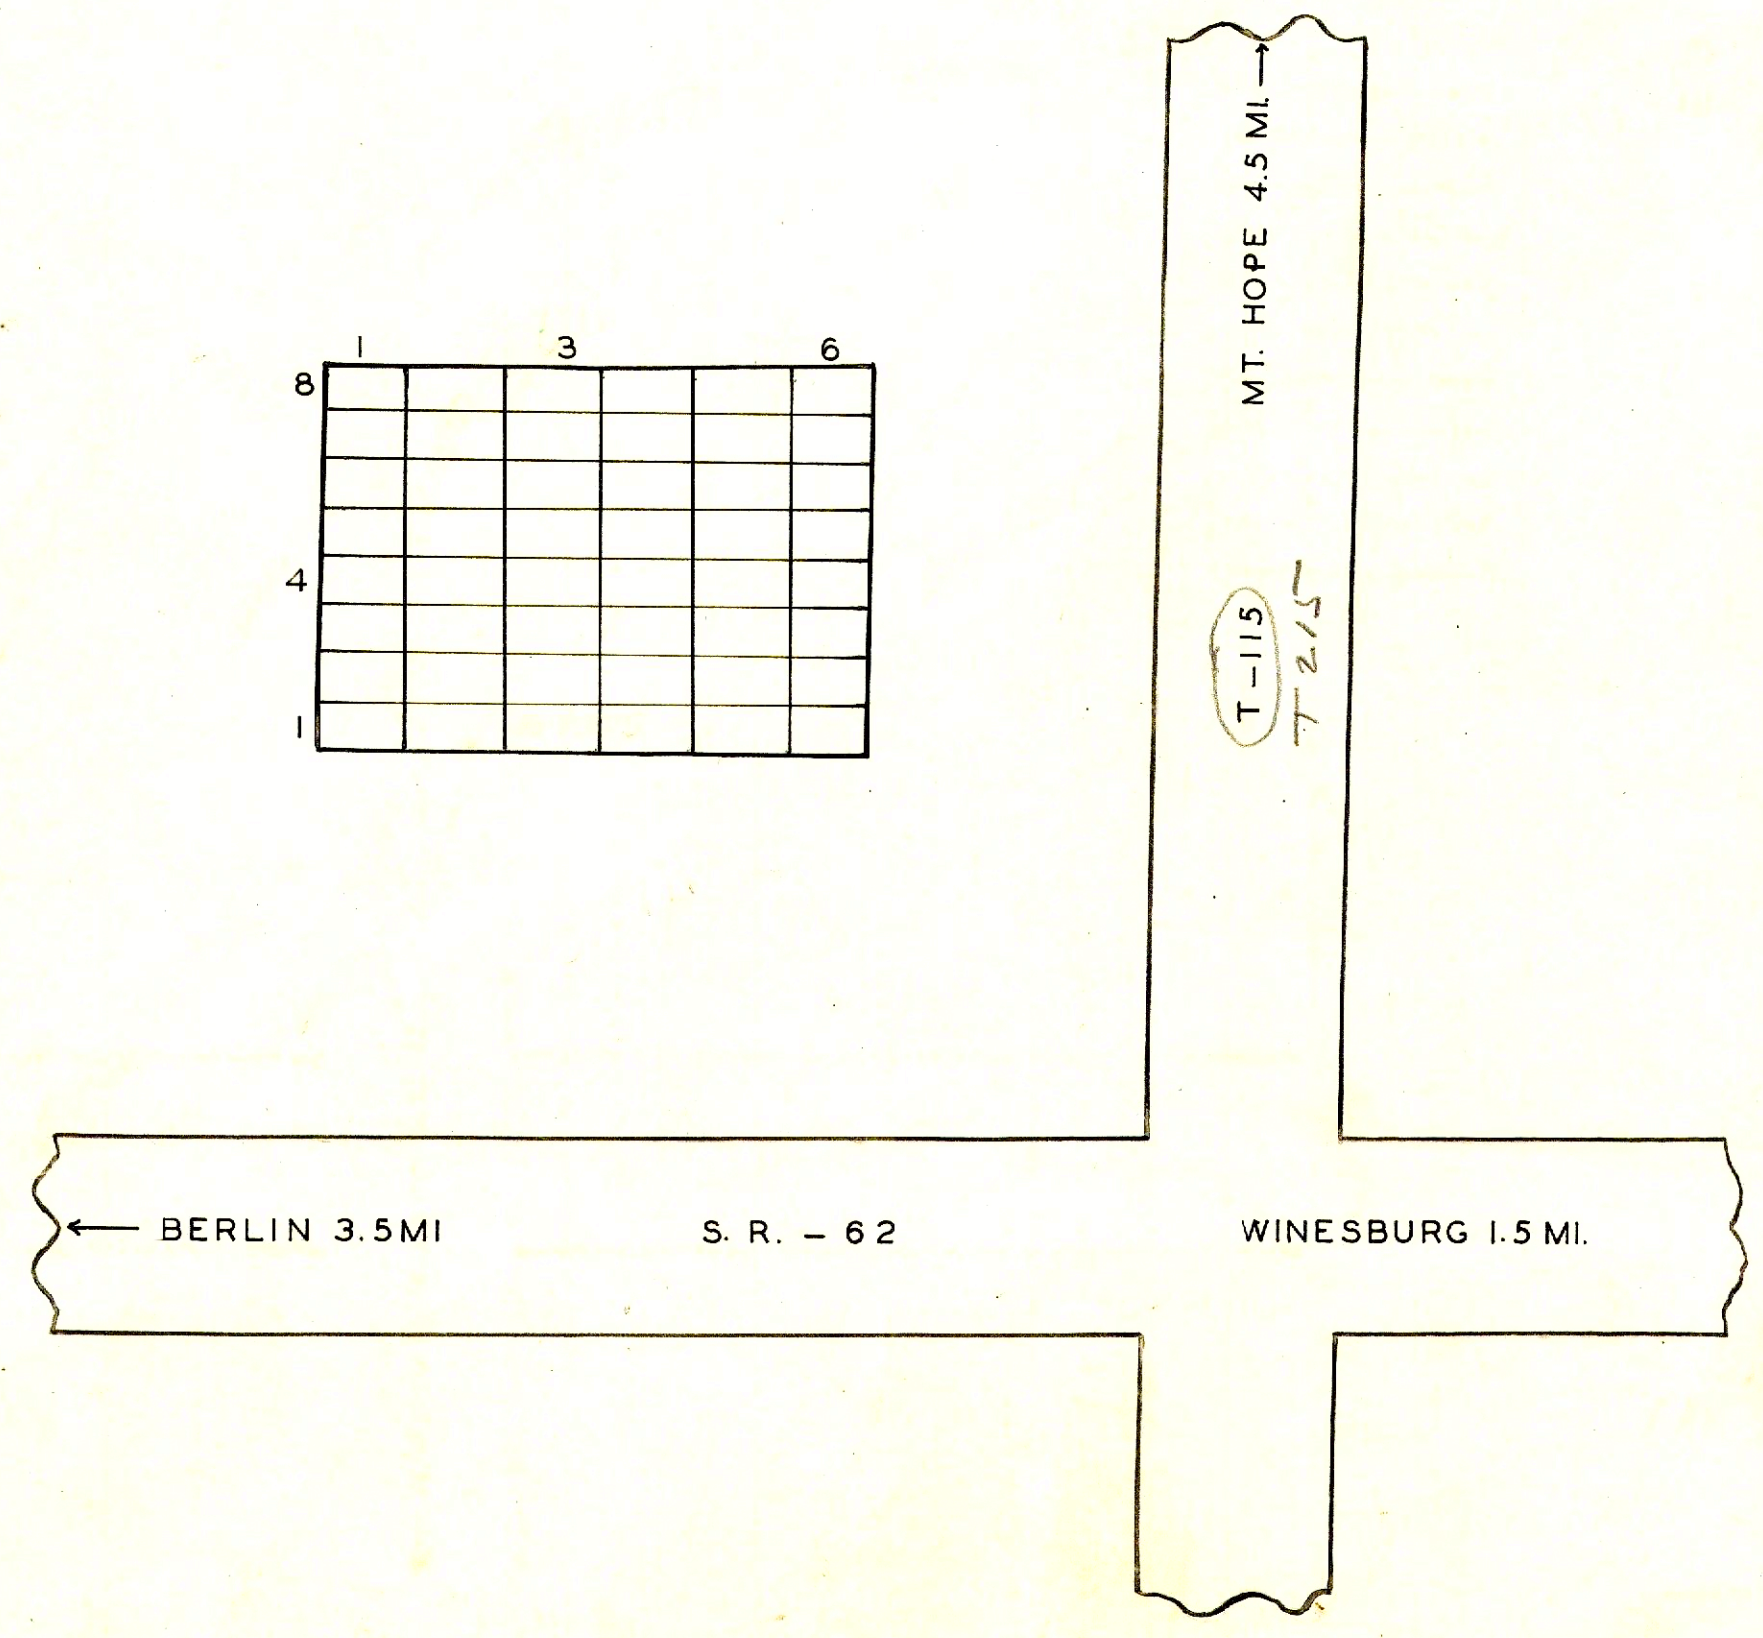

N^o 155



YUTZY CEMETERY

HOLMES CO. PAINT TWP.

OFFICIAL PROJECT NOS. 465-42-3-467
665-42-3-232

LEGEND	HISTORY
① REVOLUTIONARY WAR. PART OF ORIGINAL	⑩ WAR OF 1812. U.S. MILITARY GRANT.
⑫ WAR WITH MEXICO. CEM. ESTABLISHED	⑬ CIVIL WAR. ABOUT 1890.
⑭ SPANISH-AM. WAR.	⑮ WORLD WAR.

SCALE 20' = 1" .05 ACRE

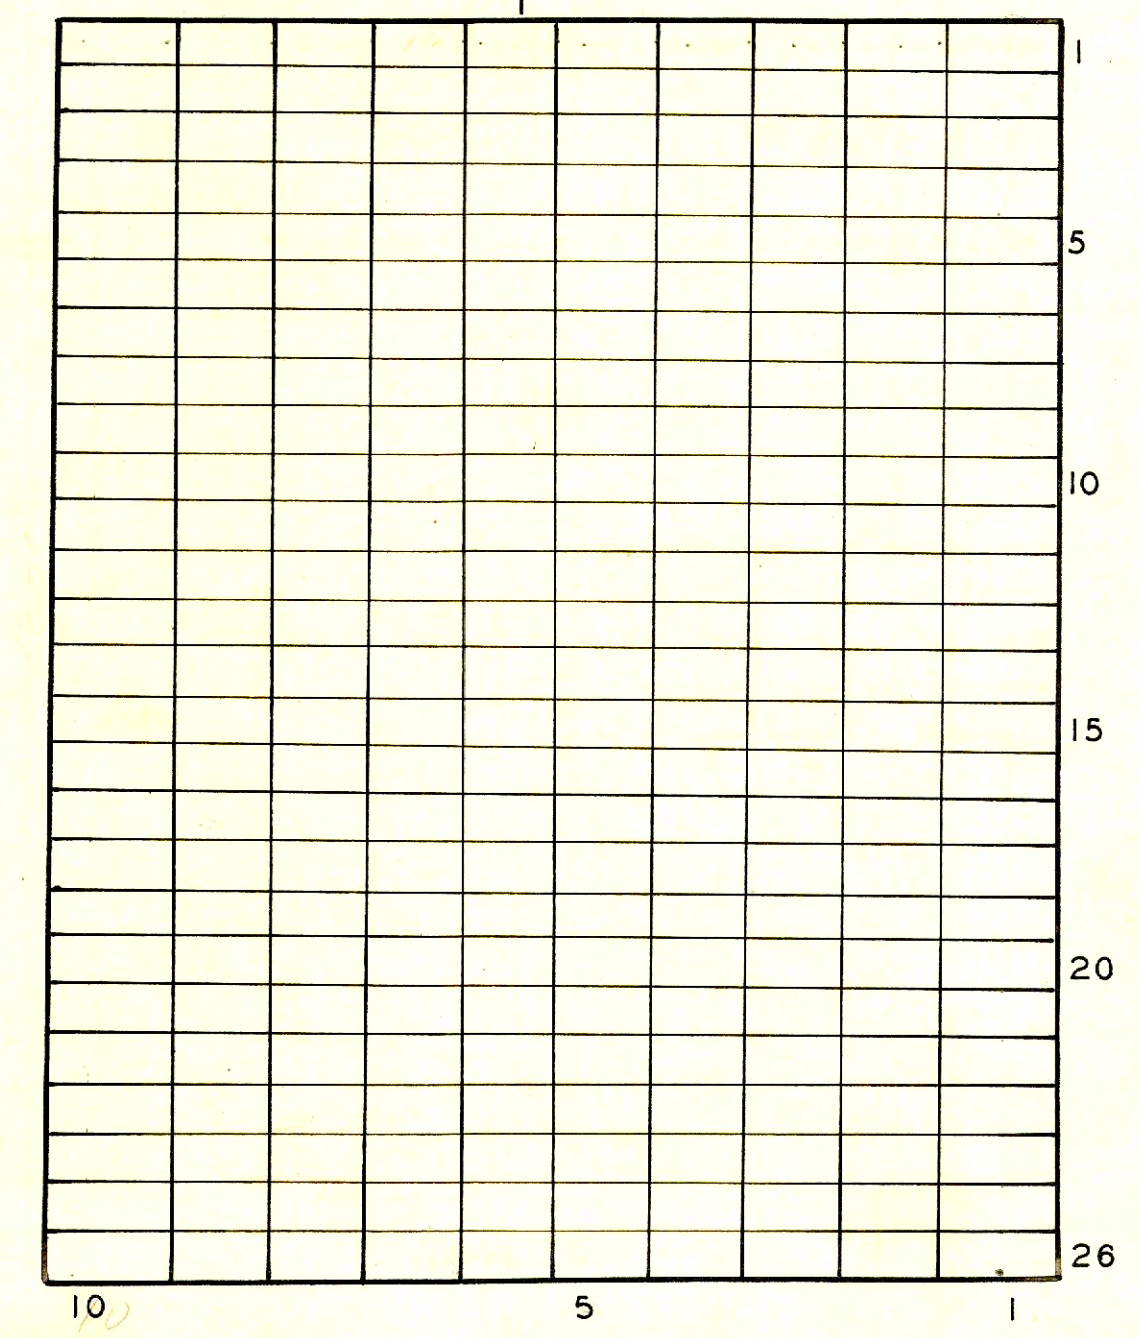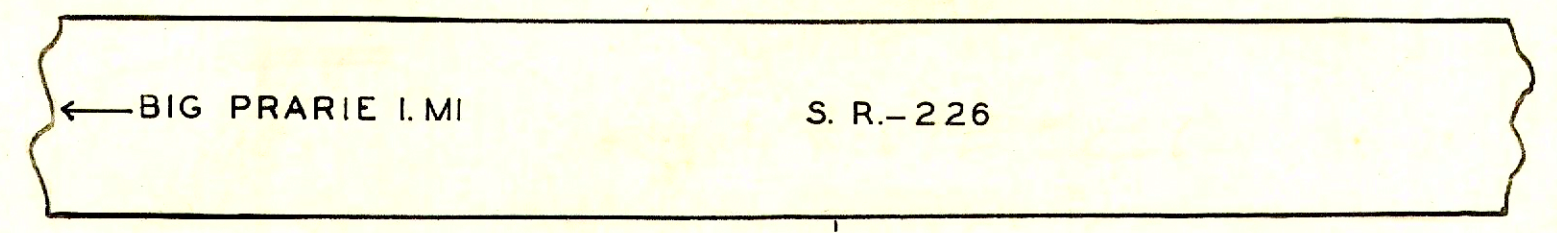

N^o 11


JOE BOLEY CEMETERY

HOLMES CO. RIPLEY TWP.

OFFICIAL PROJECT NOS. 465-42-3-467
665-42-3-232

LEGEND	HISTORY
① REVOLUTIONARY WAR. PART OF ORIGINAL	⑩ WAR OF 1812. CONGRESSIONAL LANDS.
⑫ WAR WITH MEXICO. CEM. ESTABLISHED	⑬ CIVIL WAR. ABOUT 1866.
⑭ SPANISH-AM. WAR.	⑮ WORLD WAR.

SCALE 20' = 1" .31 ACRE

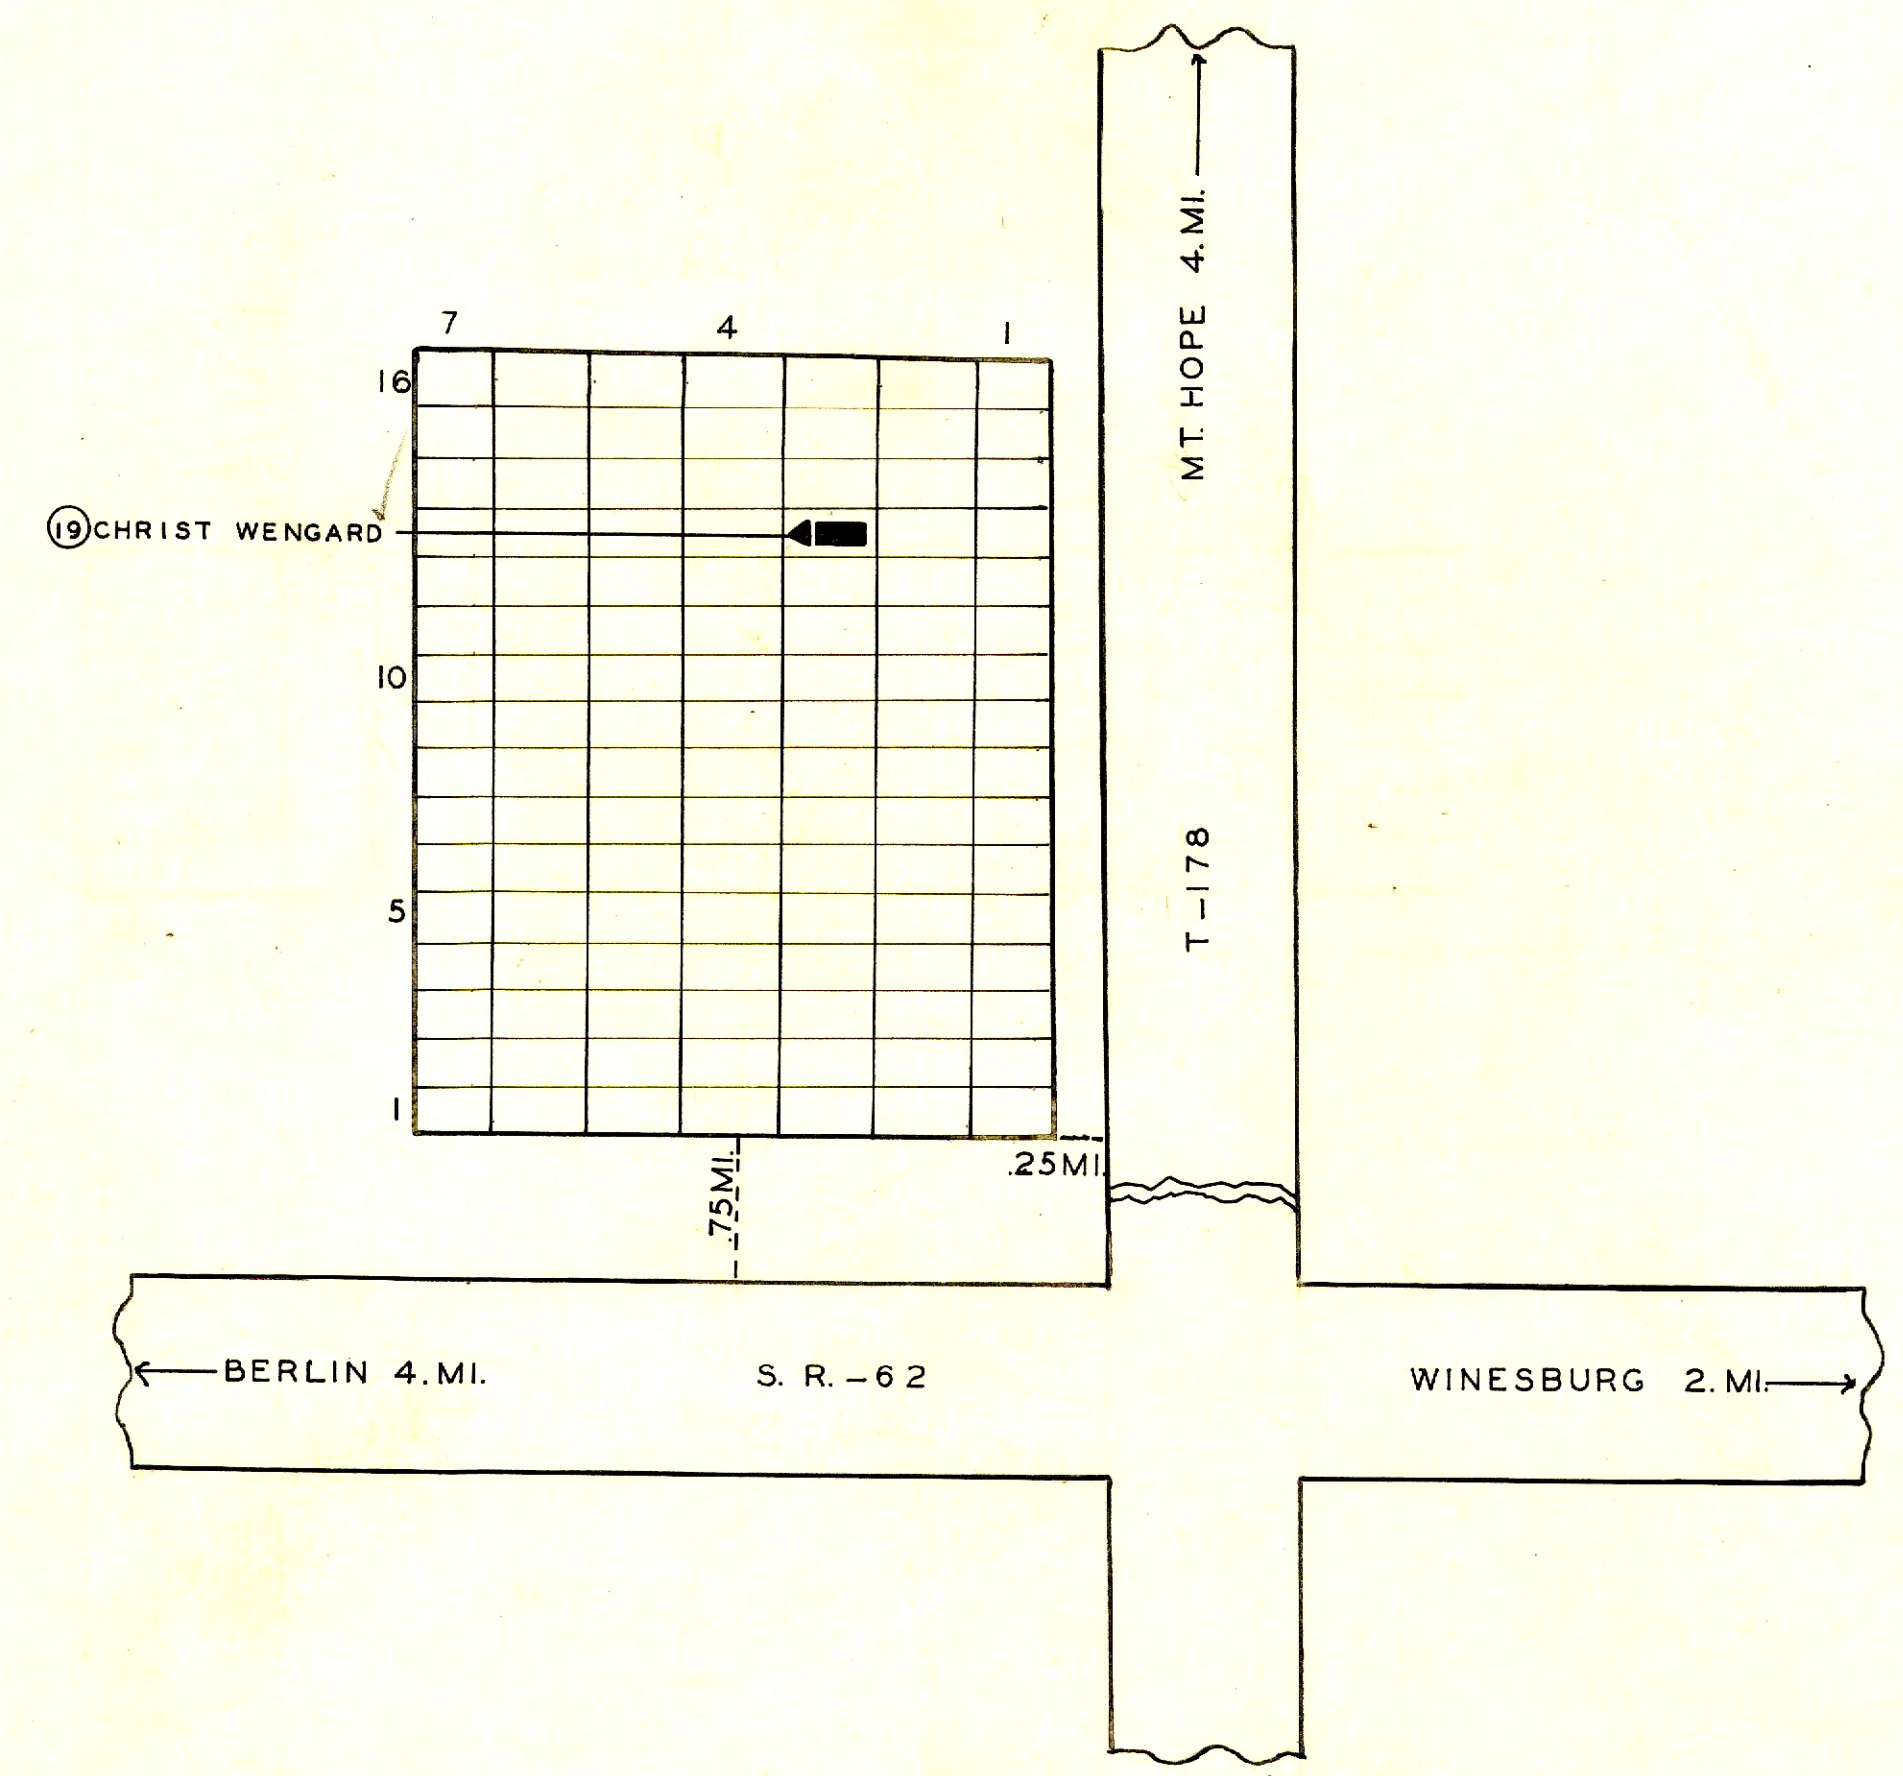

N^o 75

HARRY B. MILLER CEMETERY

HOLMES CO. PAINT TWP.

OFFICIAL PROJECT NOS. 465-42-3-467
665-42-3-232

LEGEND	HISTORY
① REVOLUTIONARY WAR. PART OF ORIGINAL	⑩ WAR OF 1812. CONGRESSIONAL LANDS.
⑫ WAR WITH MEXICO. CEM. ESTABLISHED	⑬ CIVIL WAR. ABOUT 1900.
⑭ SPANISH-AM. WAR.	⑮ WORLD WAR.

SCALE 20' = 1" .12 ACRE