
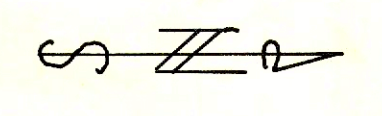


N^o 127

DANIEL TROYER. CEMETERY.
 HOLMES. CO. CLARK, TWP.
 OFFICIAL PROJECT NOS. 465-42-3-467
 665-42-3-232

LEGEND	HISTORY
① REVOLUTIONARY WAR. PART OF ORIGINAL	
⑩ WAR OF 1812. U.S. MILITARY GRANT.	
⑮ WAR WITH MEXICO. CEM. ESTABLISHED	
⑲ CIVIL WAR. ABOUT 1868.	
⑳ SPANISH-AM. WAR.	
㉑ WORLD WAR.	

SCALE 20' = 1" .034 ACRE

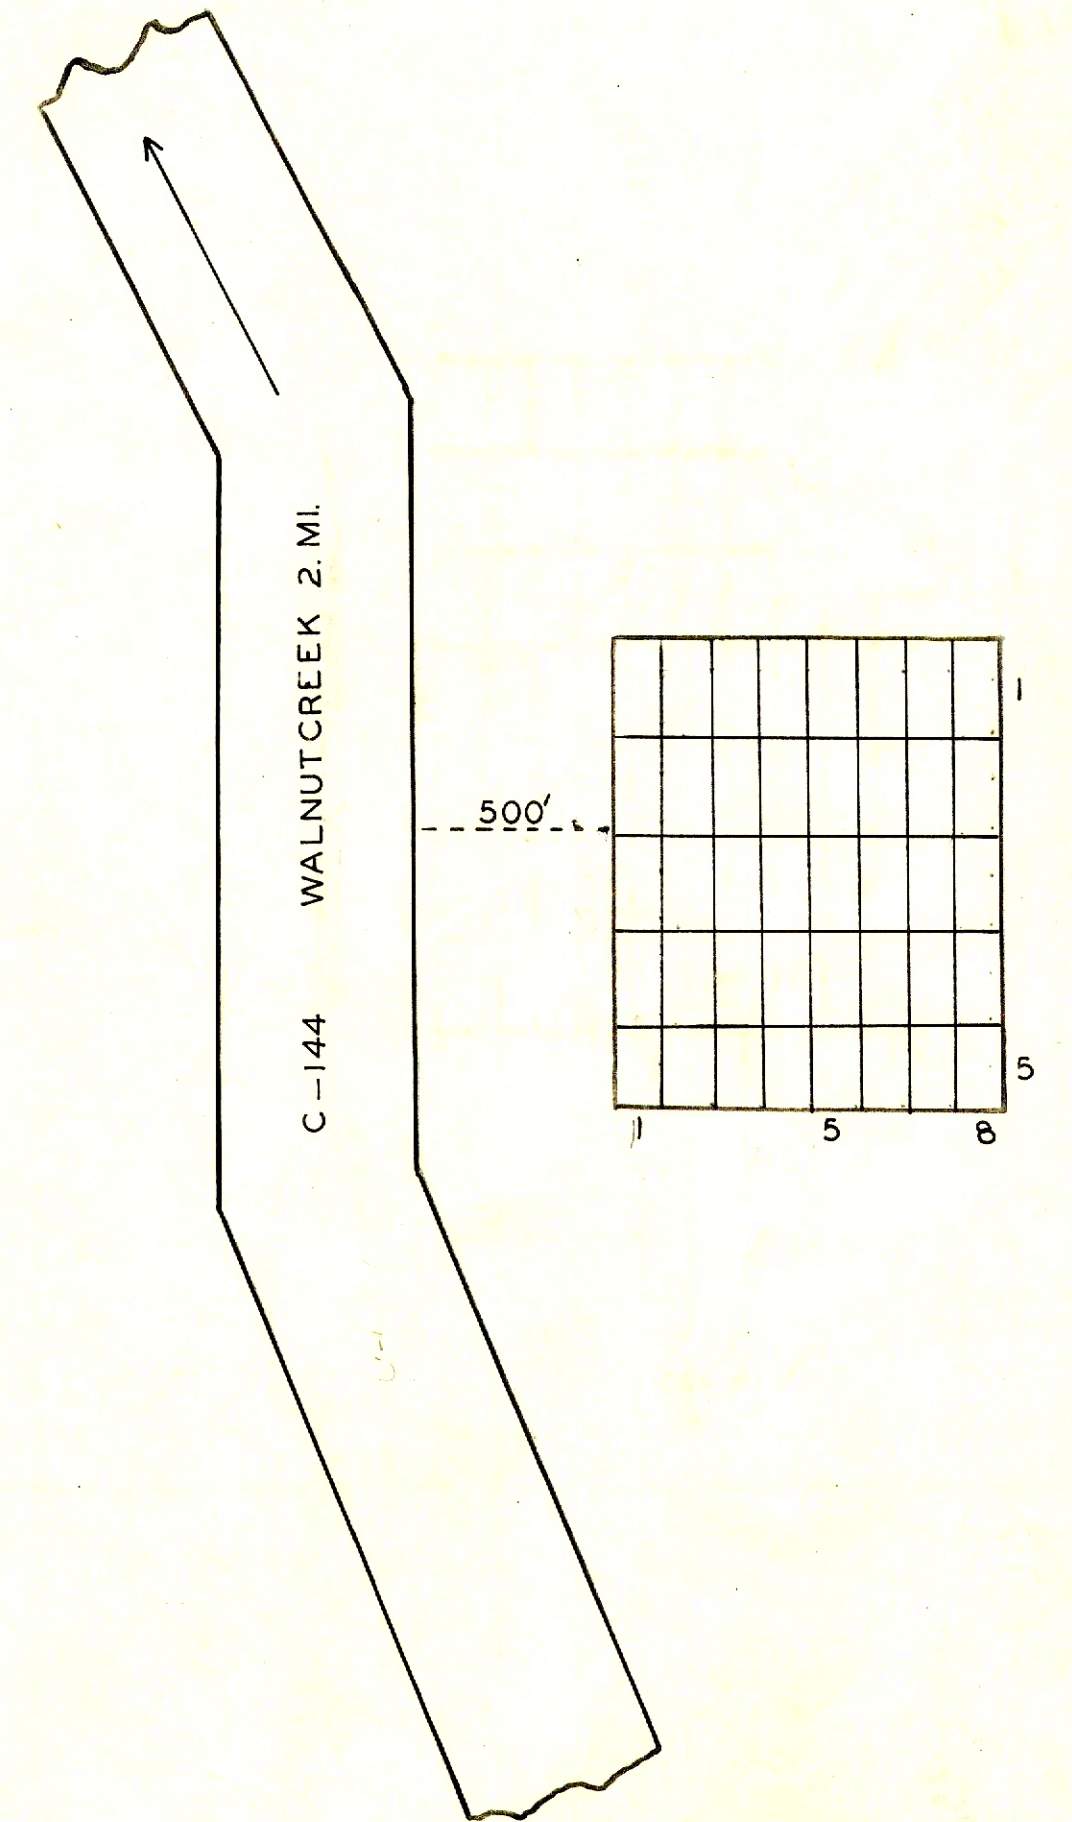


N^o 87

JONAS MILLER. CEMETERY.
 HOLMES. CO. WALNUTCREEK, TWP.
 OFFICIAL PROJECT NOS. 465-42-3-467
 665-42-3-232

LEGEND	HISTORY
① REVOLUTIONARY WAR. PART OF ORIGINAL	
⑩ WAR OF 1812. U.S. MILITARY GRANT.	
⑮ WAR WITH MEXICO. CEM. ESTABLISHED	
⑲ CIVIL WAR. ABOUT 1878.	
⑳ SPANISH-AM. WAR.	
㉑ WORLD WAR.	

SCALE 20' = 1" .045 ACRE


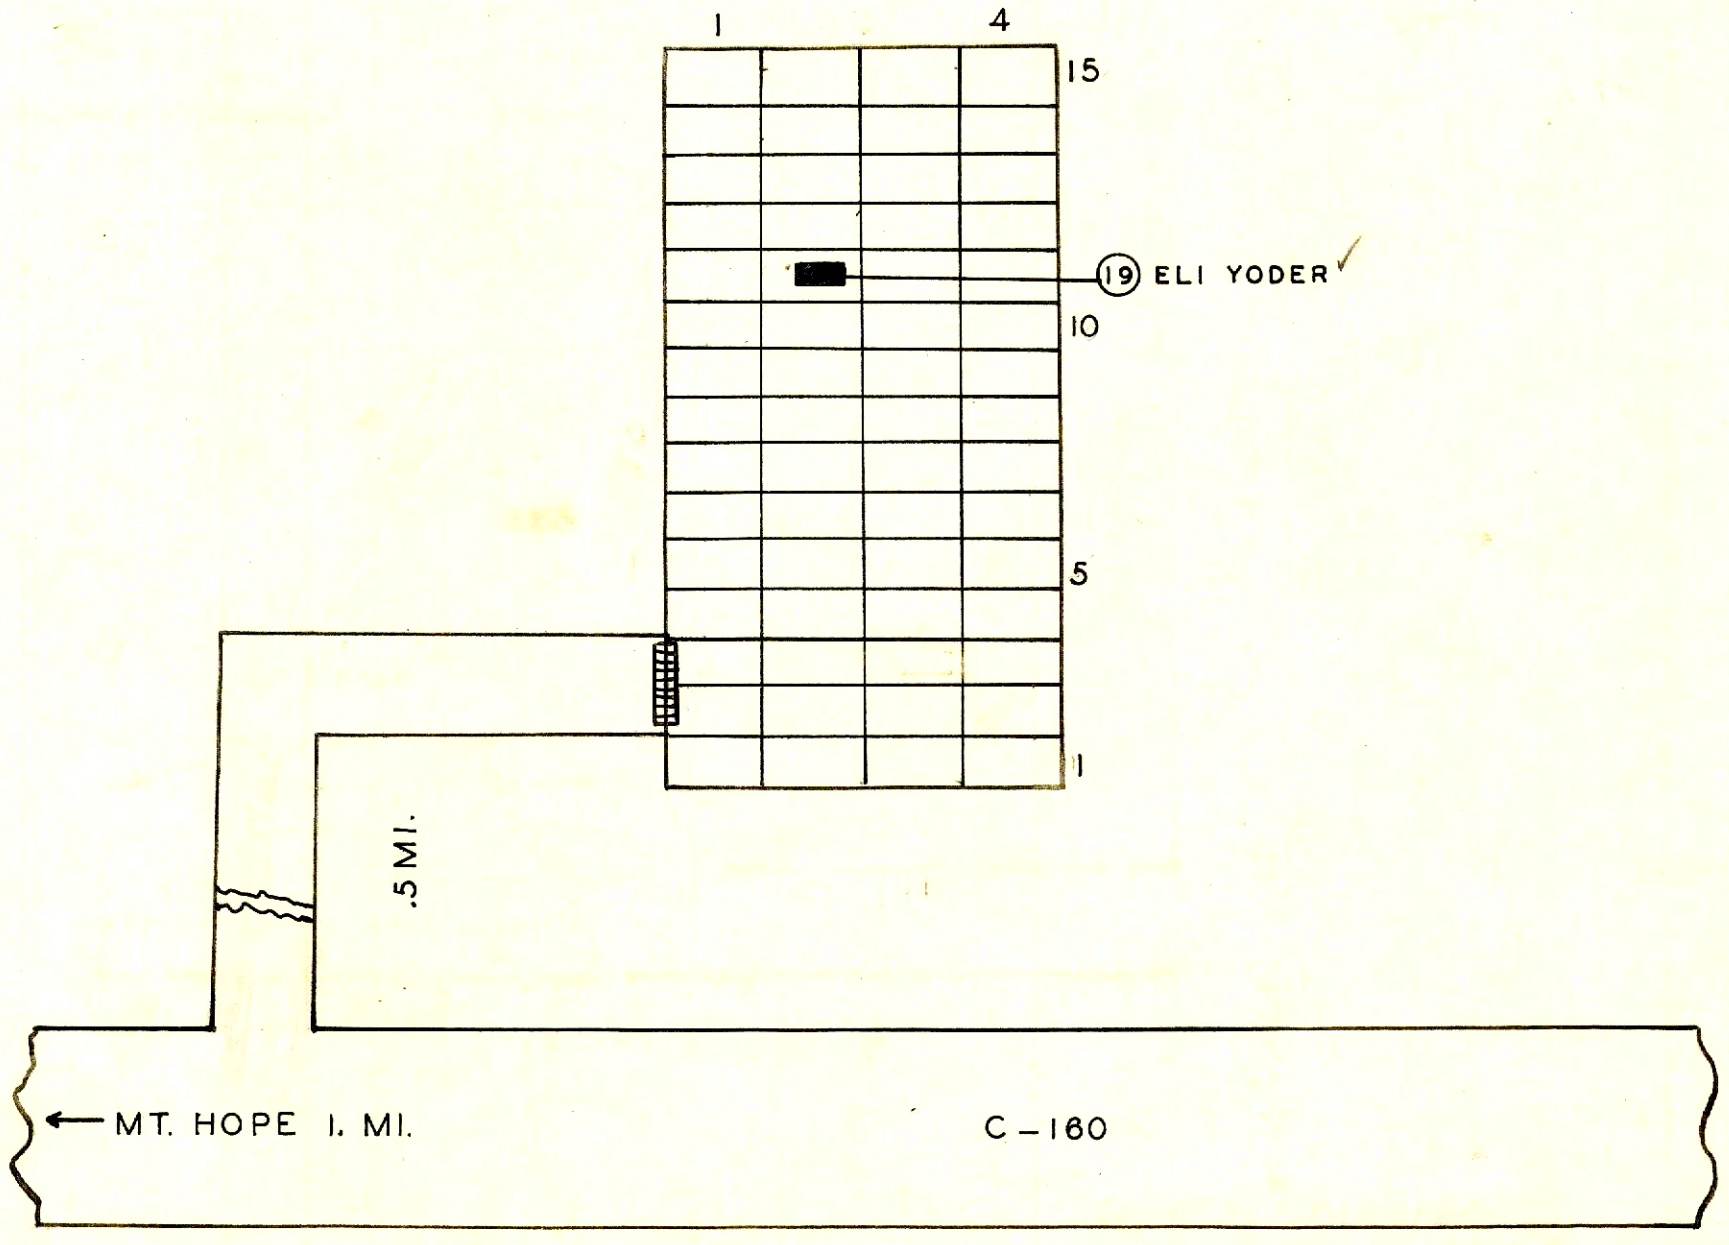


N^o 171

STUTSMAN. CEMETERY.
 HOLMES. CO. SALT CREEK, TWP.
 OFFICIAL PROJECT NOS. 465-42-3-467
 665-42-3-232

LEGEND	HISTORY
① REVOLUTIONARY WAR. PART OF ORIGINAL	
⑩ WAR OF 1812. CONGRESSIONAL LANDS	
⑮ WAR WITH MEXICO. CEM. ESTABLISHED	
⑲ CIVIL WAR. ABOUT 1865.	
⑳ SPANISH-AM. WAR.	
㉑ WORLD WAR.	

SCALE 20' = 1" .073 ACRE

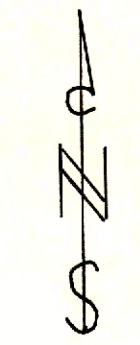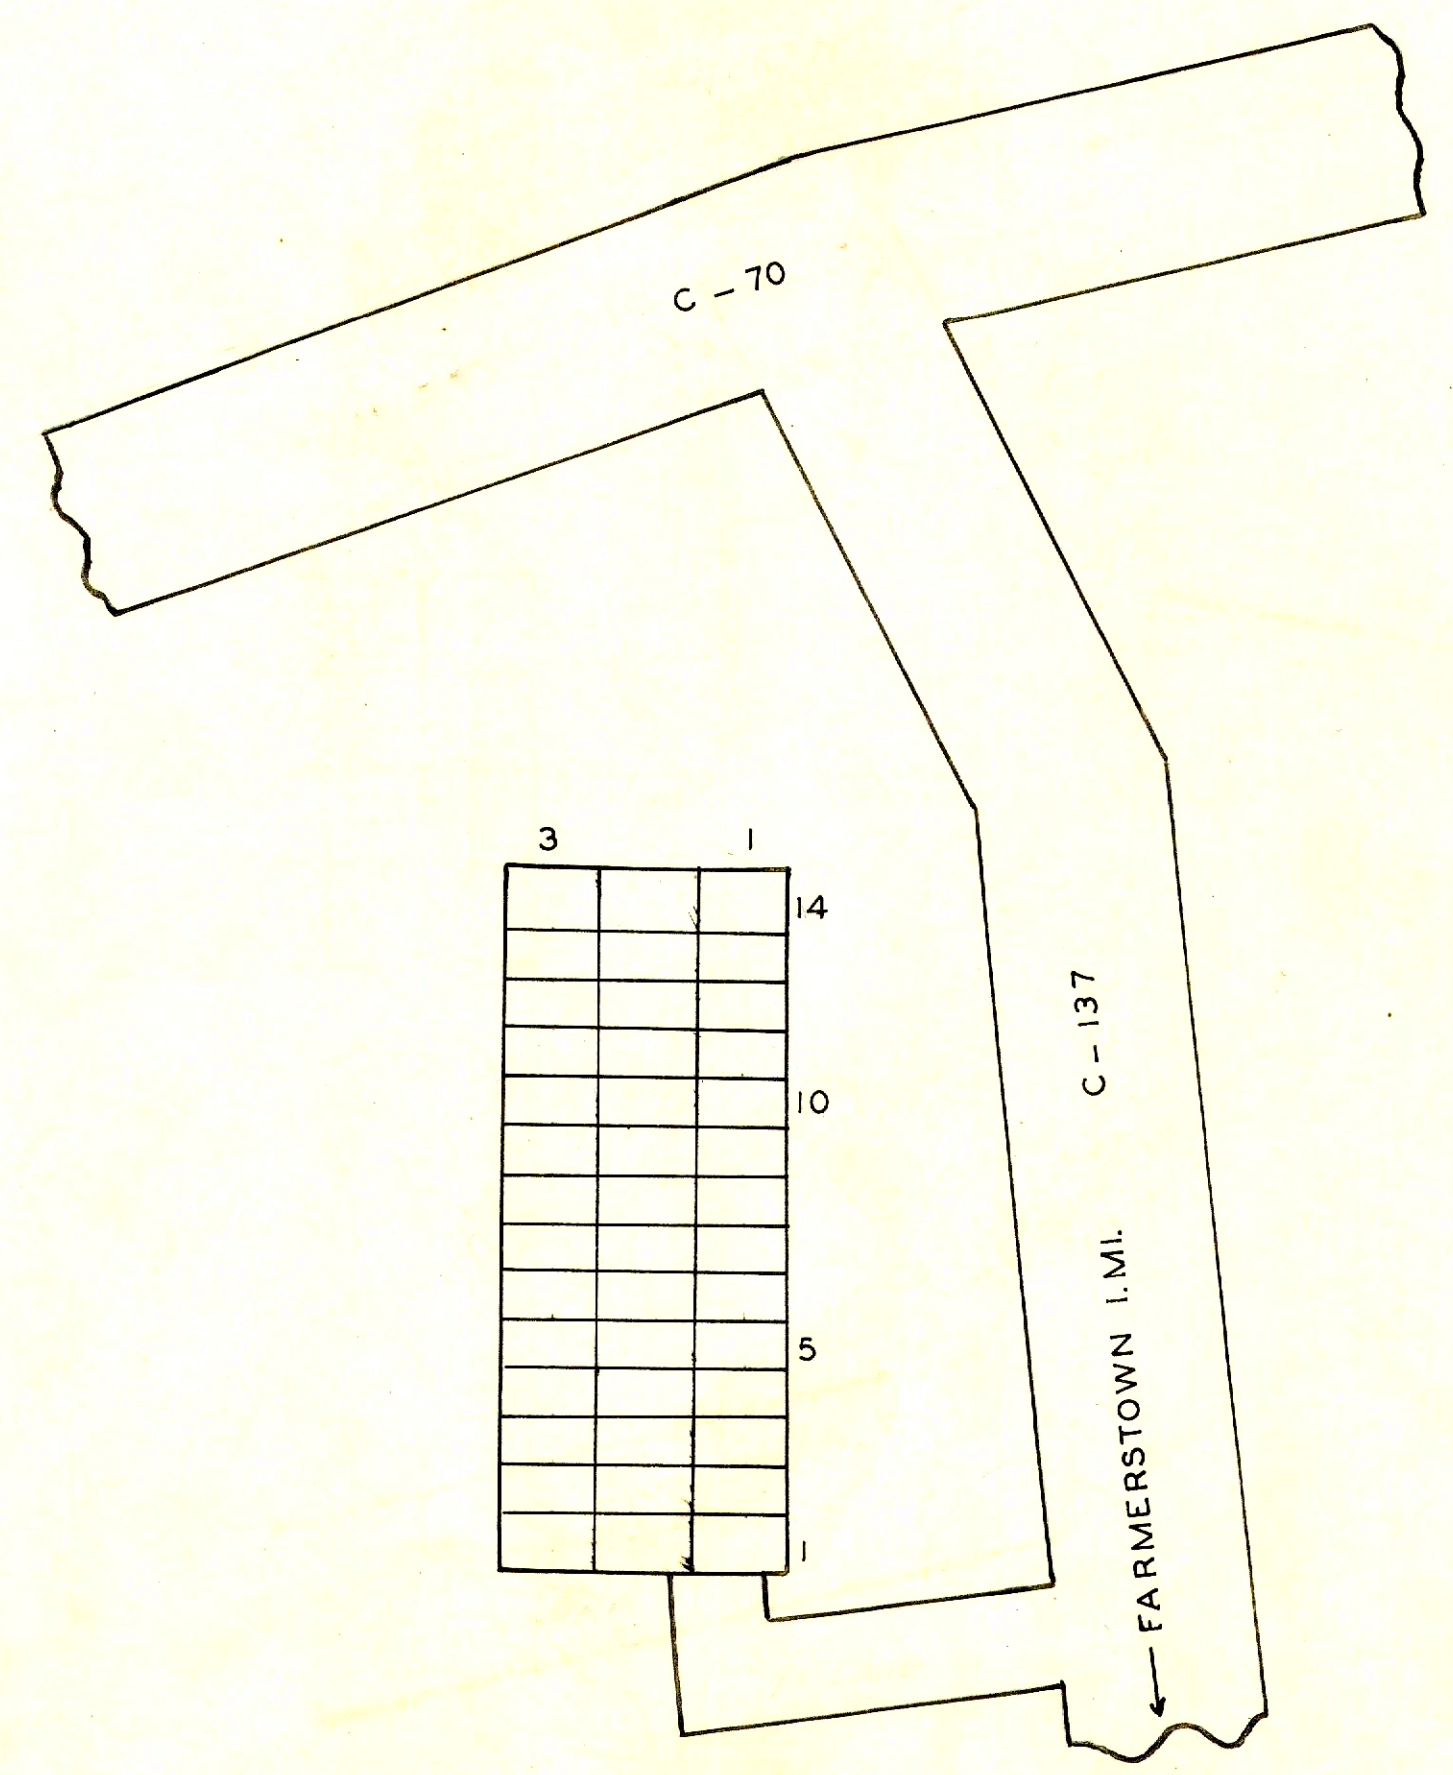

N^o 40

E. HERSHBERGER. CEMETERY.
 HOLMES. CO. CLARK, TWP.
 OFFICIAL PROJECT NOS. 465-42-3-467
 665-42-3-232

LEGEND	HISTORY
① REVOLUTIONARY WAR. PART OF ORIGINAL	
⑩ WAR OF 1812. U.S. MILITARY GRANT.	
⑮ WAR WITH MEXICO. CEM. ESTABLISHED	
⑲ CIVIL WAR. ABOUT 1870.	
⑳ SPANISH-AM. WAR.	
㉑ WORLD WAR.	

SCALE 20' = 1" .05 ACRE