


BLOCK-LOT- GRAVE-WAR- NAME.

E	2	1	(19)	BOESHART. JOSEPH ✓
A	13	1	(19)	GIRARD. J.T. ✓
F	12	1	(19)	GUENTHER. JACOB ✓
B	2	1	(19)	MOREND. PETER. ✓
E	3	1	(31)	NOMANY. JOSEPH. ✓
E	10	1	(19)	ORTLOFF. ADAM ✓
F	11	1	(19)	SHAUB. LAWRENCE ✓
C	3	1	(19)	STARNER. JOSEPH. ✓
E	14	1	(19)	WEIGAND. GEORGE ✓
A	16	2	(31)	YESTER. CHARLES. C. ✓

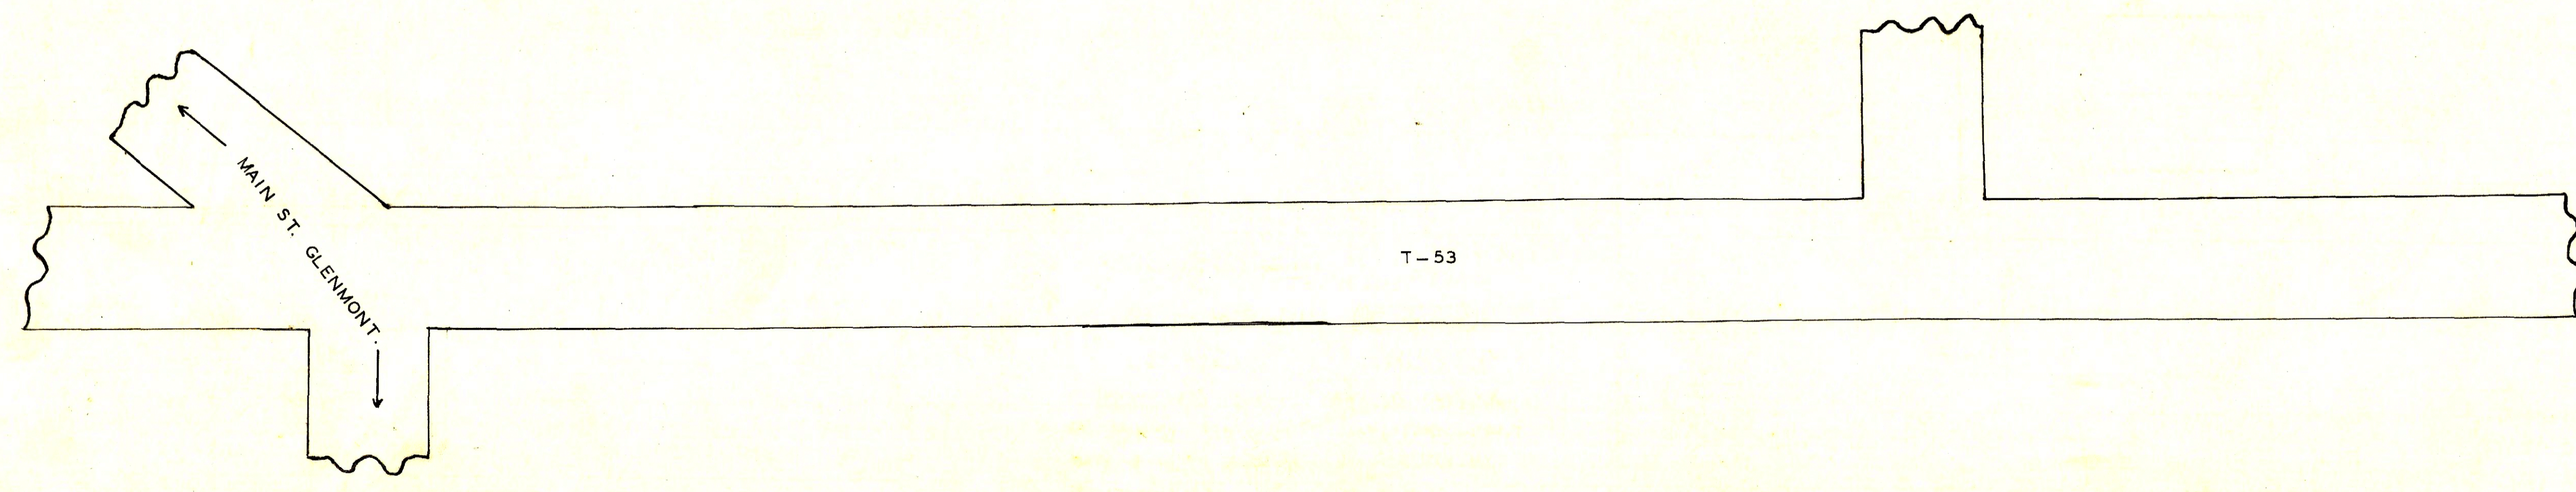

T-53

No 18

**CATHOLIC
(GLENMONT)
CEMETRY**

HOLMES CO. RICHLAND TWP.

OFFICIAL PROJECT NOS. 465-42-3-467
665-42-3-232

LEGEND	HISTORY
(1) REVOLUTIONARY WAR. PART OF ORIGINAL	(19) U.S. MILITARY GRANT.
(10) WAR OF 1812.	(19) CEM. ESTABLISHED
(16) WAR WITH MEXICO.	(19) CIVIL WAR. ABOUT 1887.
(29) SPANISH-AM. WAR.	(31) WORLD WAR.

SCALE 20"= 1" 1.8 ACRE