

N^o-5


BARNES CEMETERY

HOLMES CO. RICHLAND TWP.

OFFICIAL PROJECT NOS. 465-42-3-467
665-42-3-232

LEGEND	HISTORY
① REVOLUTIONARY WAR.	PART OF ORIGINAL
⑩ WAR OF 1812.	U.S. MILITARY GRANT.
⑪ WAR WITH MEXICO.	CEM. ESTABLISHED
⑫ CIVIL WAR.	ABOUT 1876.
⑬ SPANISH-AM. WAR.	
⑭ WORLD WAR.	

SCALE 20' = 1" .202 ACRE

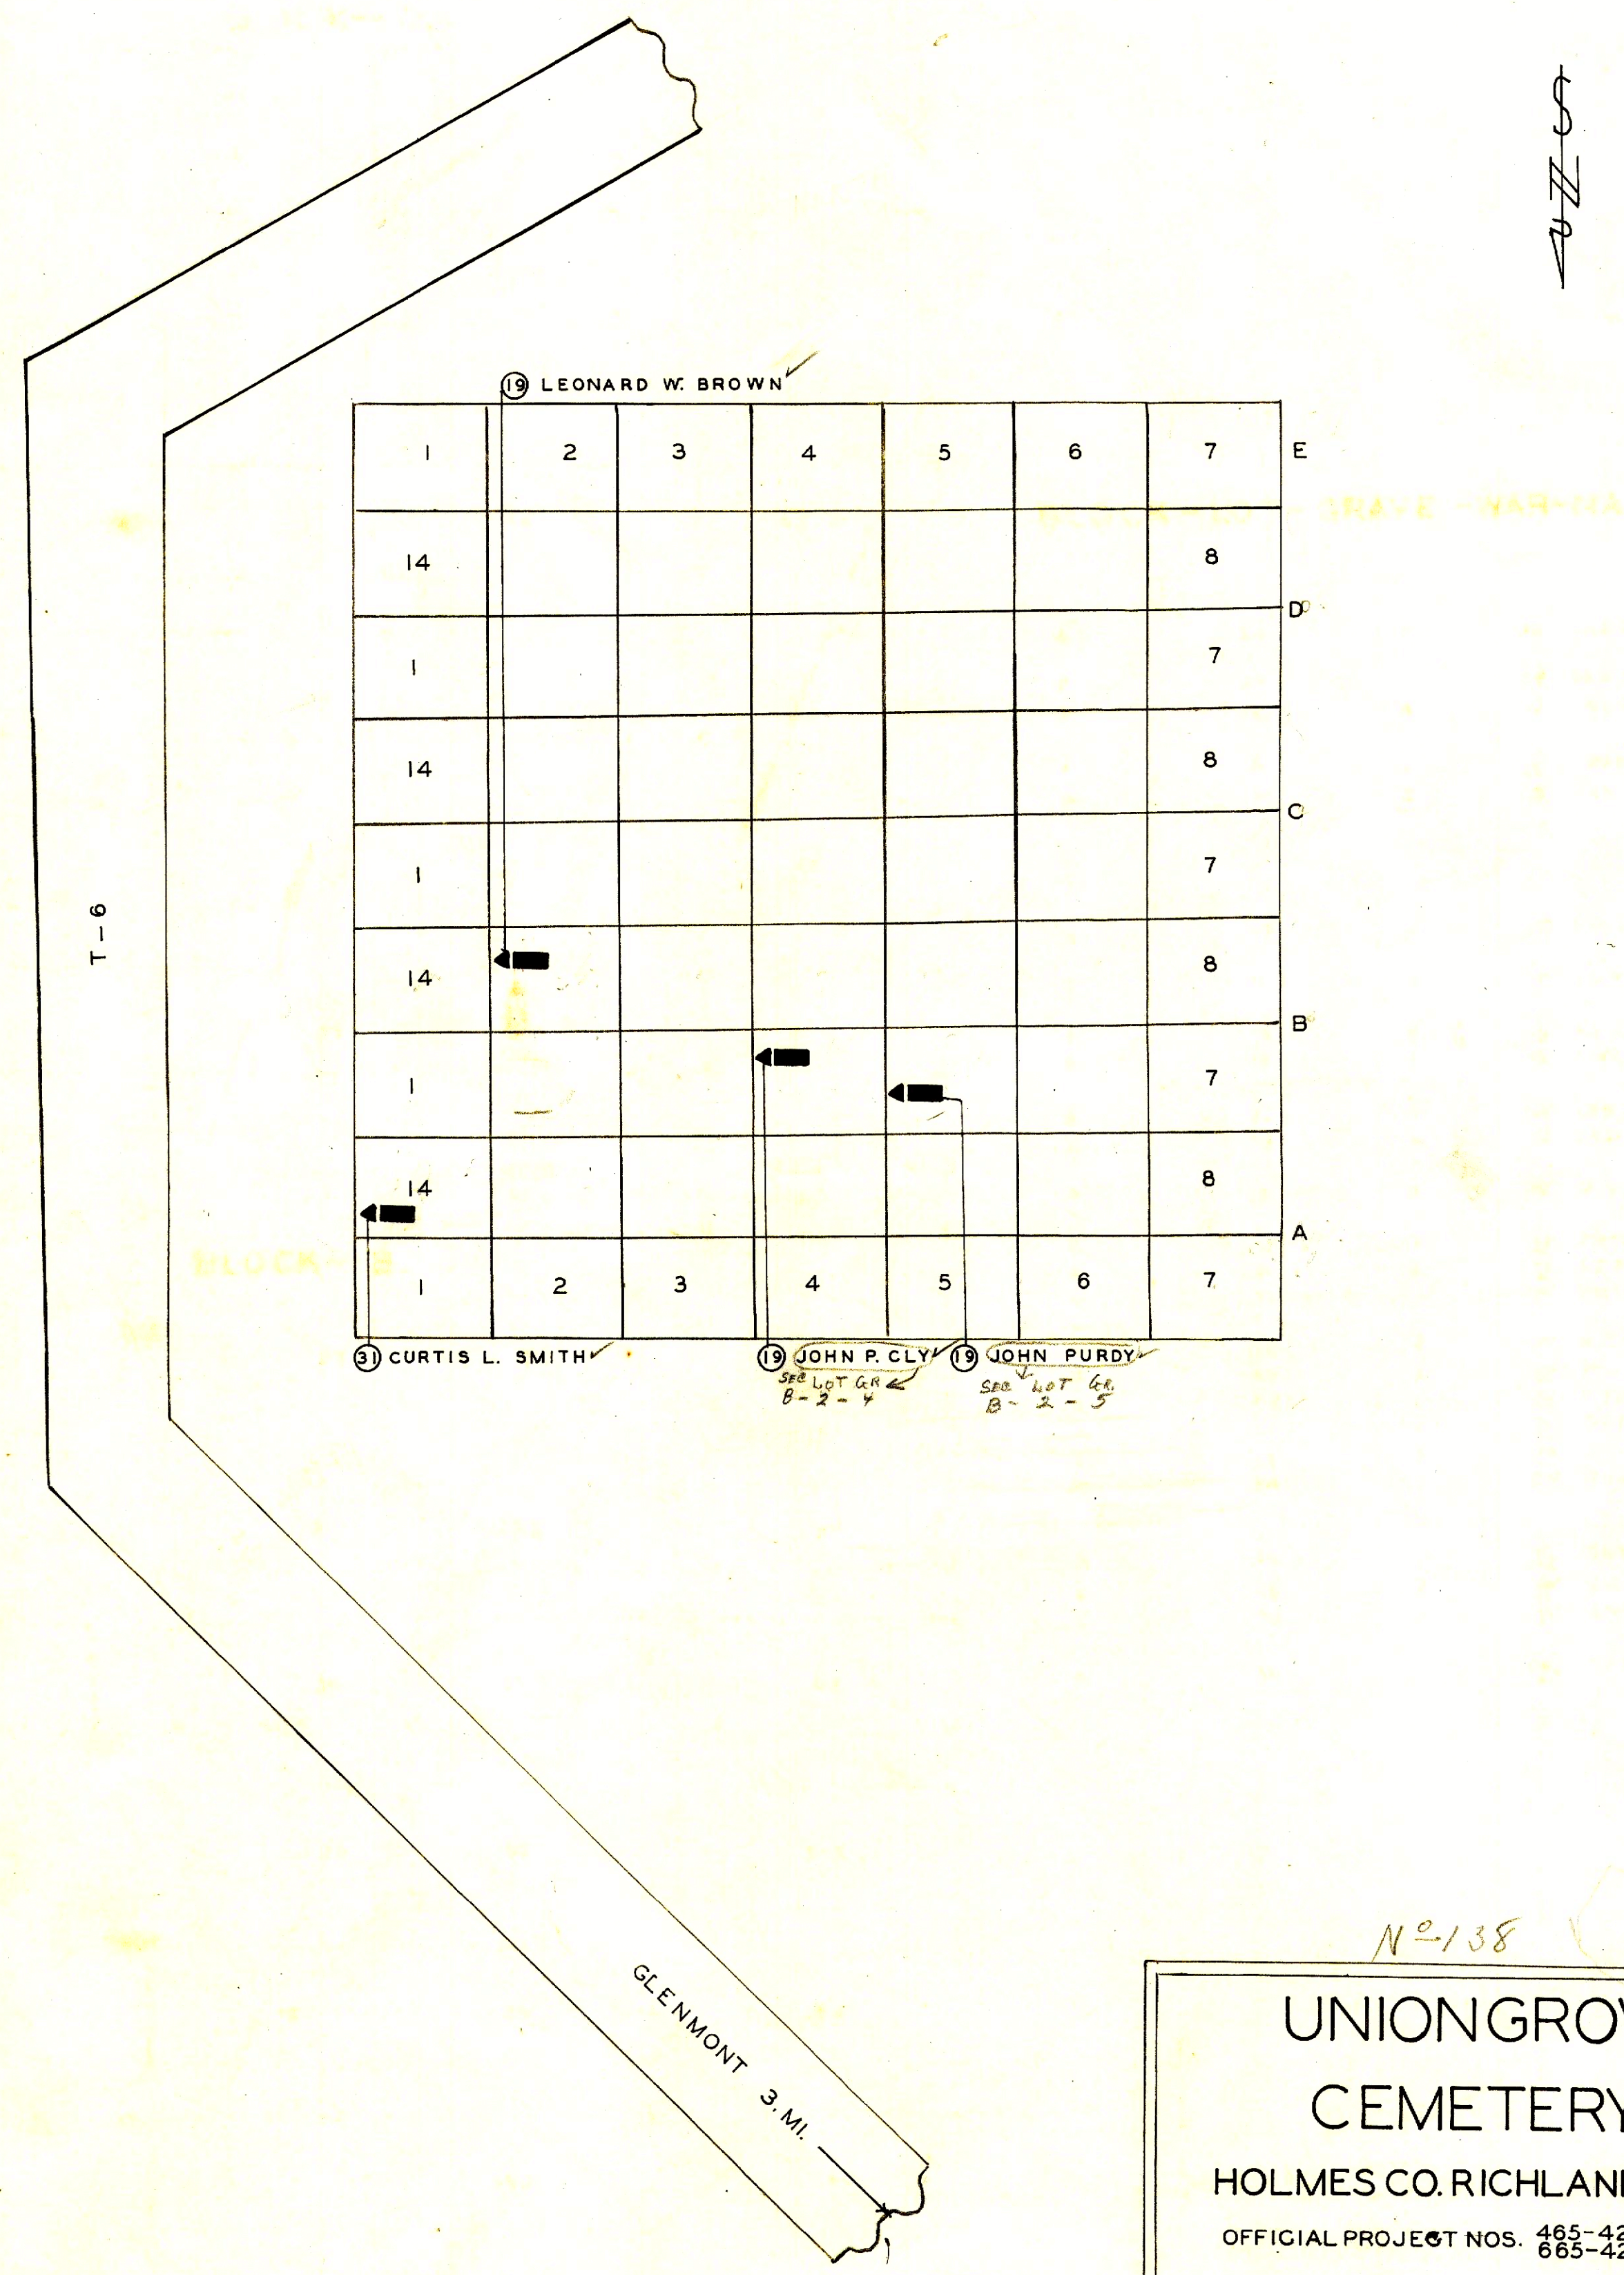

N^o-138

UNIONGROVE CEMETERY

HOLMES CO. RICHLAND TWP.

OFFICIAL PROJECT NOS. 465-42-3-467
665-42-3-232

LEGEND	HISTORY
① REVOLUTIONARY WAR	PART OF ORIGINAL
⑩ WAR OF 1812	U.S. MILITARY GRANT.
⑪ WAR WITH MEXICO	CEM. ESTABLISHED
⑫ CIVIL WAR	ABOUT 1895.
⑬ SPANISH-AM. WAR	
⑭ WORLD WAR	

SCALE 20' = 1" .45 ACRE