



1.	2.			6.	7.
8.	9.		BLOCK - A.	13.	14.
15.	16.			20.	21.


1.	2.			6.	7.
8.	9.		BLOCK - B.	13.	14.
15.	16.			20.	21.

1.	2.			6.	7.
8.	9.		BLOCK - C.	13.	14.
15.	16.			20.	21.

1.	2.			6.	7.
8.	9.		BLOCK - D.	13.	14.
15.	16.			20.	21.

BLOCK- LOT - GRAVE - WAR-NAME.

C.	10	1	18 ALLISON, DAVID.
D.	1	1	19 ANDERSON, JOHN.
A.	16	2	19 ANDERSON, WILLIAM, M.
B.	7	2	19 BELL, H.H.
D.	24	1	19 DAVENPORT, J.W.
D.	10	1	19 KERR, HOLMES.
D.	21	1	19 MARTIN, ROBERT.
A.	6	1	19 SCHWIER, JOHN.
C.	19	1	19 WILLIAMS, DAVID, S.
B.	11	0	19 UNKNOWN.

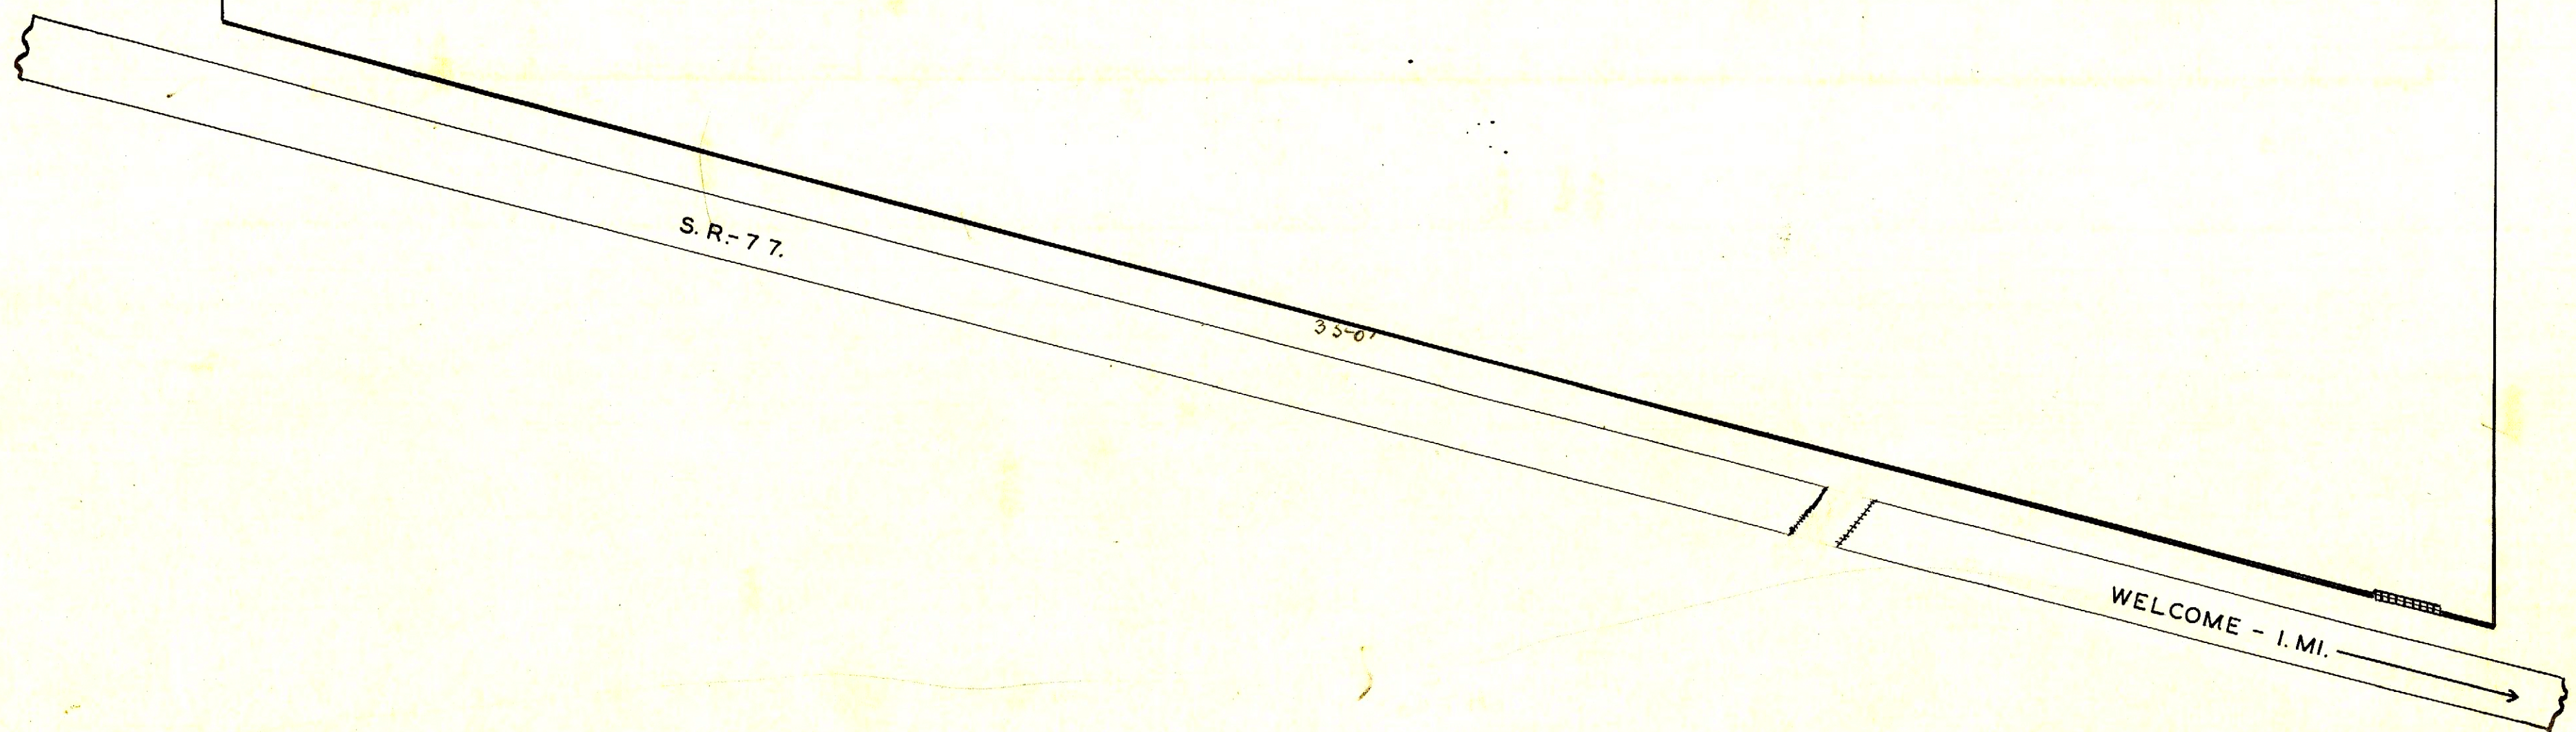

No 144

WELCOME CEMETERY
 HOLMES CO. MONROE TWP.
 OFFICIAL PROJECT NOS. 465-42-3-467
 665-42-3-232

LEGEND	HISTORY
① REVOLUTIONARY WAR	PART OF ORIGINAL
⑩ WAR OF 1812	U.S. MILITARY GRANT.
⑪ WAR WITH MEXICO	CEM. ESTABLISHED
⑫ CIVIL WAR	ABOUT 1866.
⑬ SPANISH-AM. WAR	
⑭ WORLD WAR	

SCALE 20=1 1.5 ACRES