

N^o 154




T. M. YODER CEMETERY

HOLMES CO. CLARK TWP.

OFFICIAL PROJECT NOS. 465-42-3-467
665-42-3-232

LEGEND	HISTORY
① REVOLUTIONARY WAR. PART OF ORIGINAL	⑩ WAR OF 1812. U.S. MILITARY GRANT.
⑫ WAR WITH MEXICO. CEM. ESTABLISHED	⑬ CIVIL WAR. ABOUT 1887
⑭ SPANISH-AM. WAR.	⑮ WORLD WAR.

SCALE 20"=1" .05 ACRE

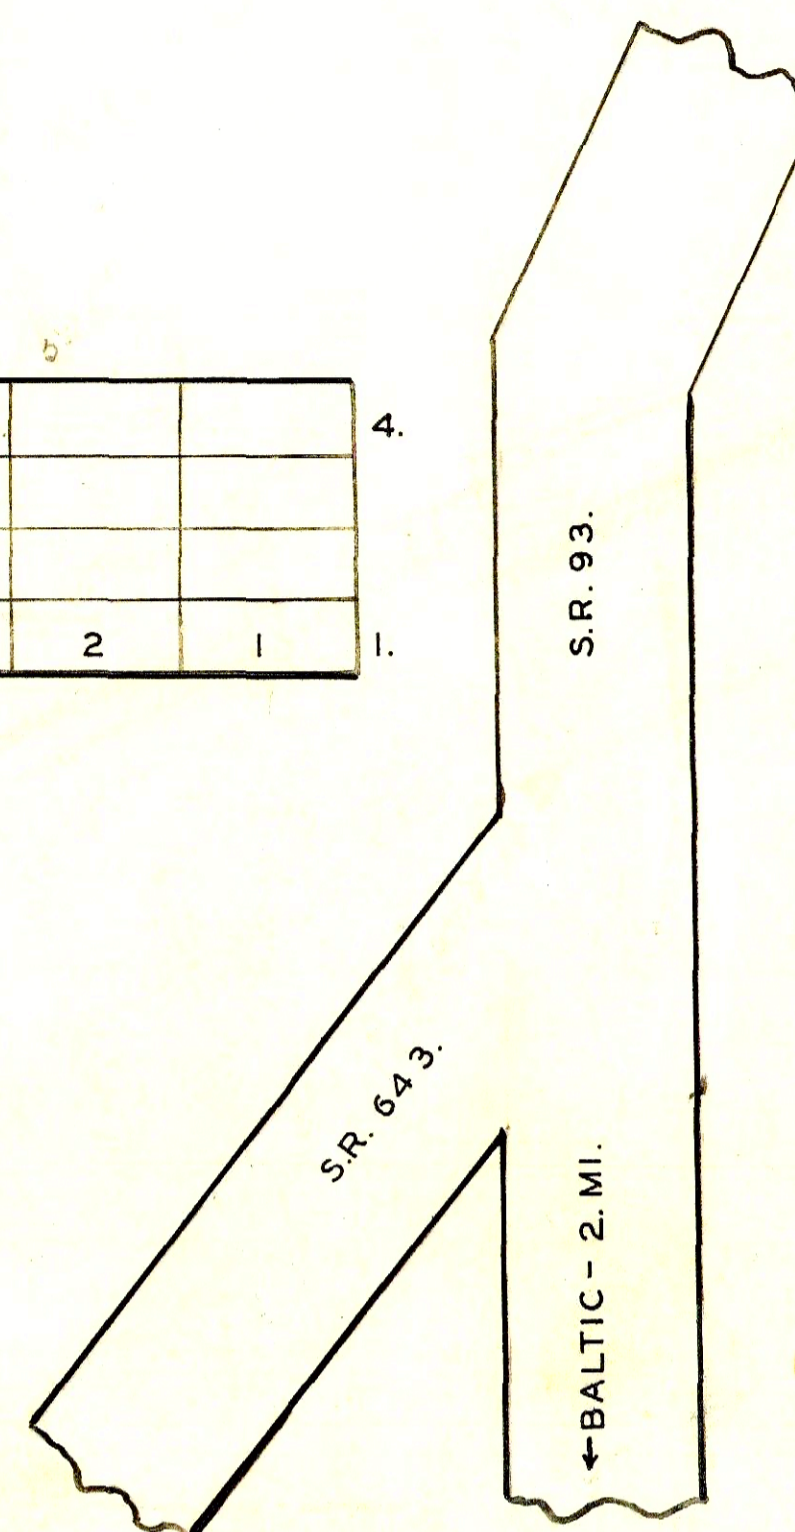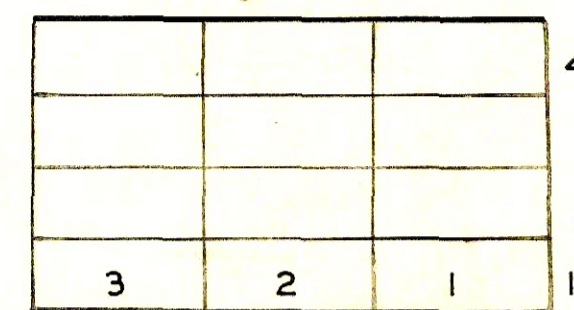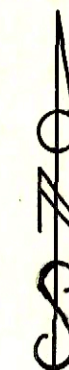

N^o 131



JONAS TROYER CEMETERY

HOLMES CO. CLARK TWP.

OFFICIAL PROJECT NOS. 465-42-3-467
665-42-3-232

LEGEND	HISTORY
① REVOLUTIONARY WAR. PART OF ORIGINAL	⑩ WAR OF 1812. U.S. MILITARY GRANT.
⑫ WAR WITH MEXICO. CEM. ESTABLISHED	⑬ CIVIL WAR. ABOUT 1886
⑭ SPANISH-AM. WAR.	⑮ WORLD WAR.

SCALE 20"=1" .03 ACRE

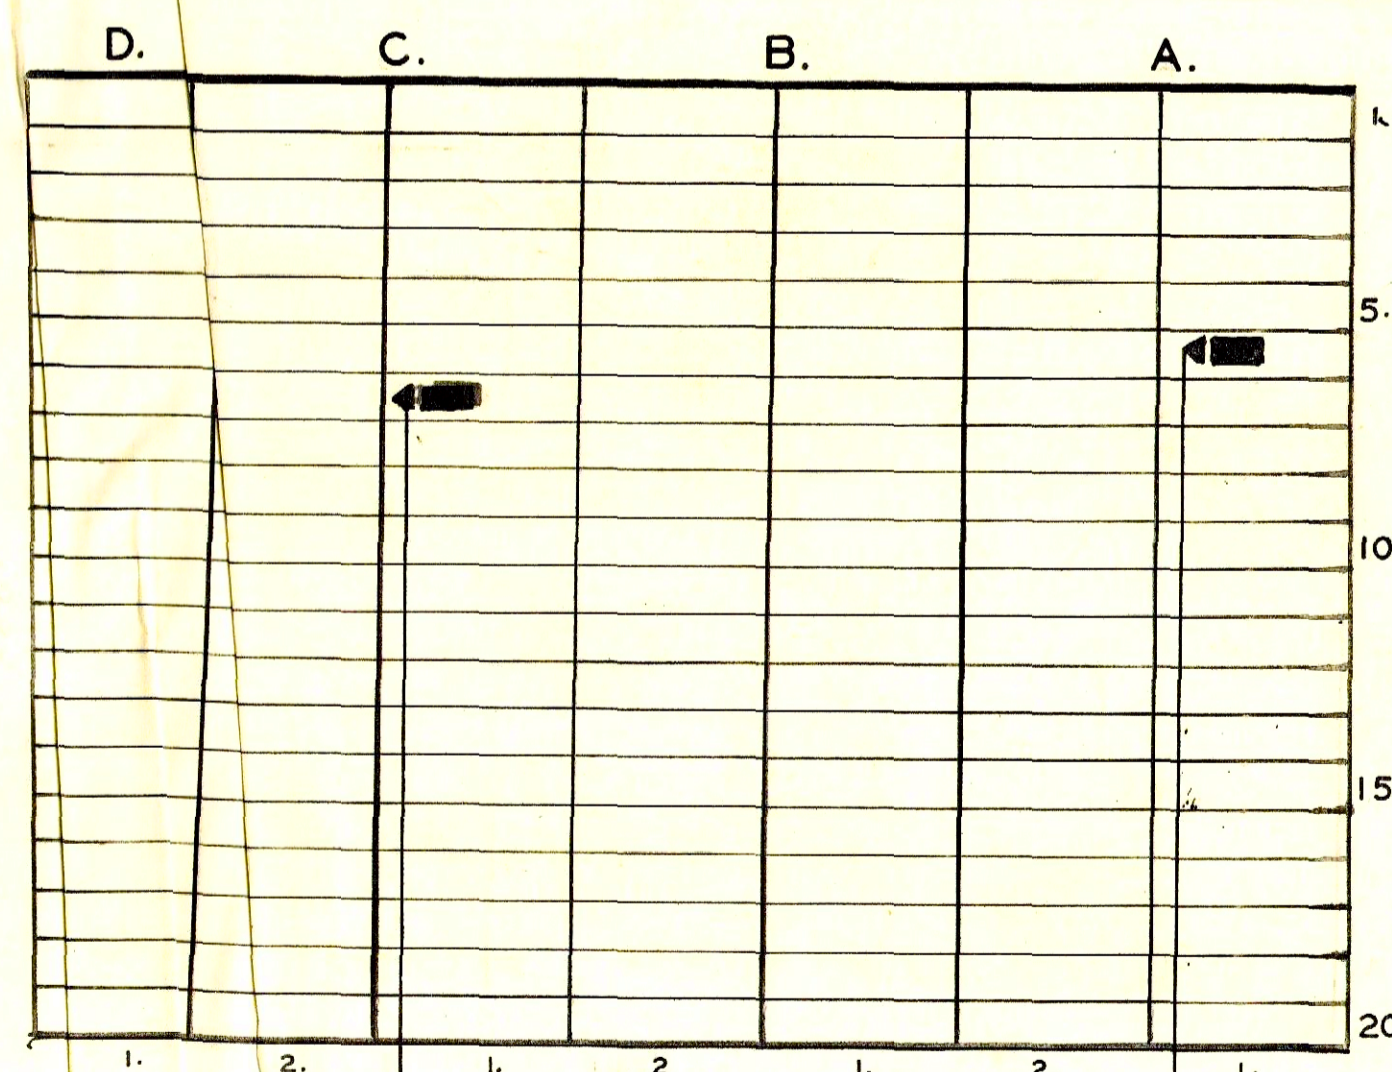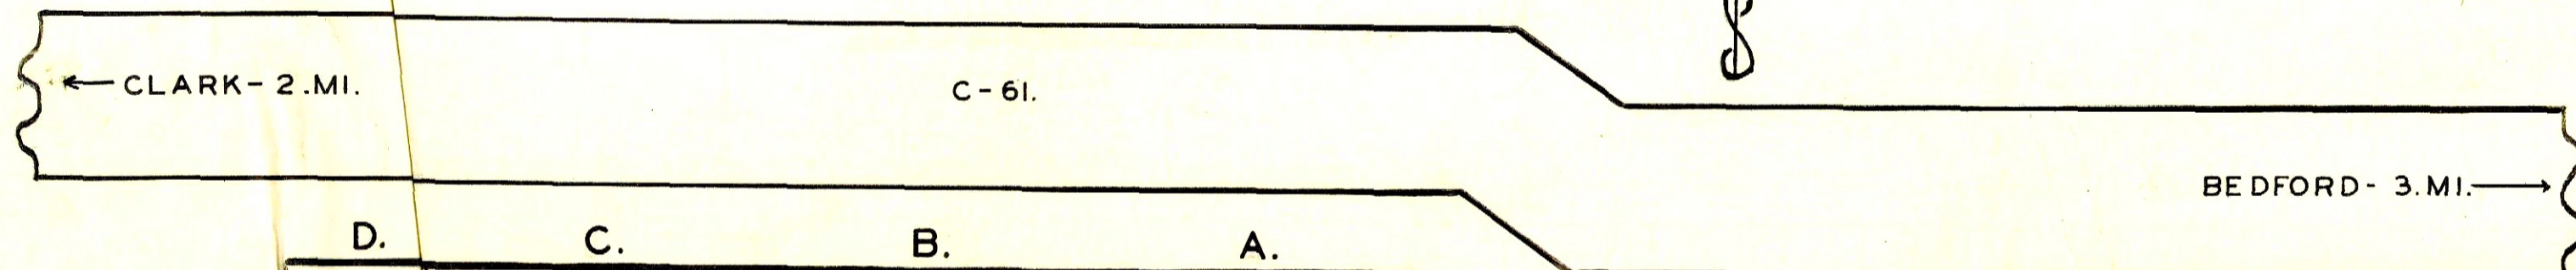

⑱ JOSEPH PETTIT. ⑱ JOHN HARBAUGH

N^o 87




OAK HILL CEMETERY

HOLMES CO. MECHANIC TWP.

OFFICIAL PROJECT NOS. 465-42-3-467
665-42-3-232

LEGEND	HISTORY
① REVOLUTIONARY WAR. PART OF ORIGINAL	⑩ WAR OF 1812. U.S. MILITARY GRANT.
⑫ WAR WITH MEXICO. CEM. ESTABLISHED	⑬ CIVIL WAR. ABOUT 1899.
⑭ SPANISH-AM. WAR.	⑮ WORLD WAR.

SCALE 20"=1" .33 ACRE

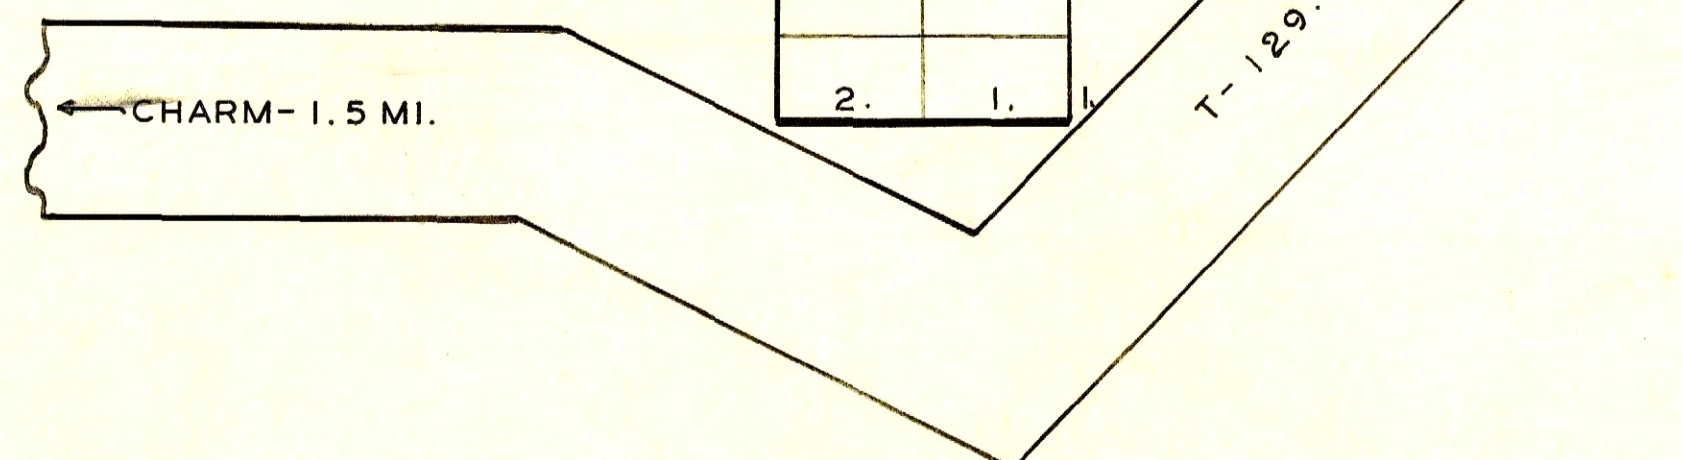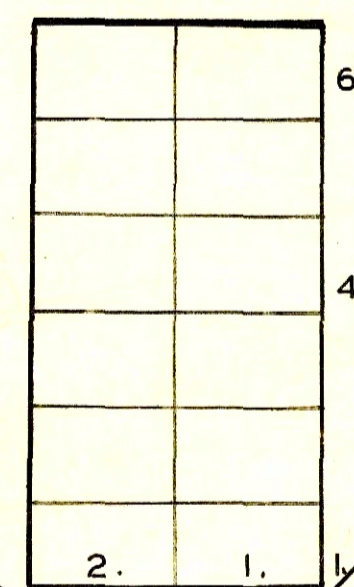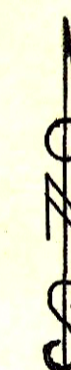

N^o 37

HERSHBERGER CEMETERY

HOLMES CO. CLARK TWP.

OFFICIAL PROJECT NOS. 465-42-3-467
665-42-3-232

LEGEND	HISTORY
① REVOLUTIONARY WAR. PART OF ORIGINAL	⑩ WAR OF 1812. U.S. MILITARY GRANT.
⑫ WAR WITH MEXICO. CEM. ESTABLISHED	⑬ CIVIL WAR. ABOUT 1888.
⑭ SPANISH-AM. WAR.	⑮ WORLD WAR.

SCALE 20"=1" .04 ACRE