



RANGES →

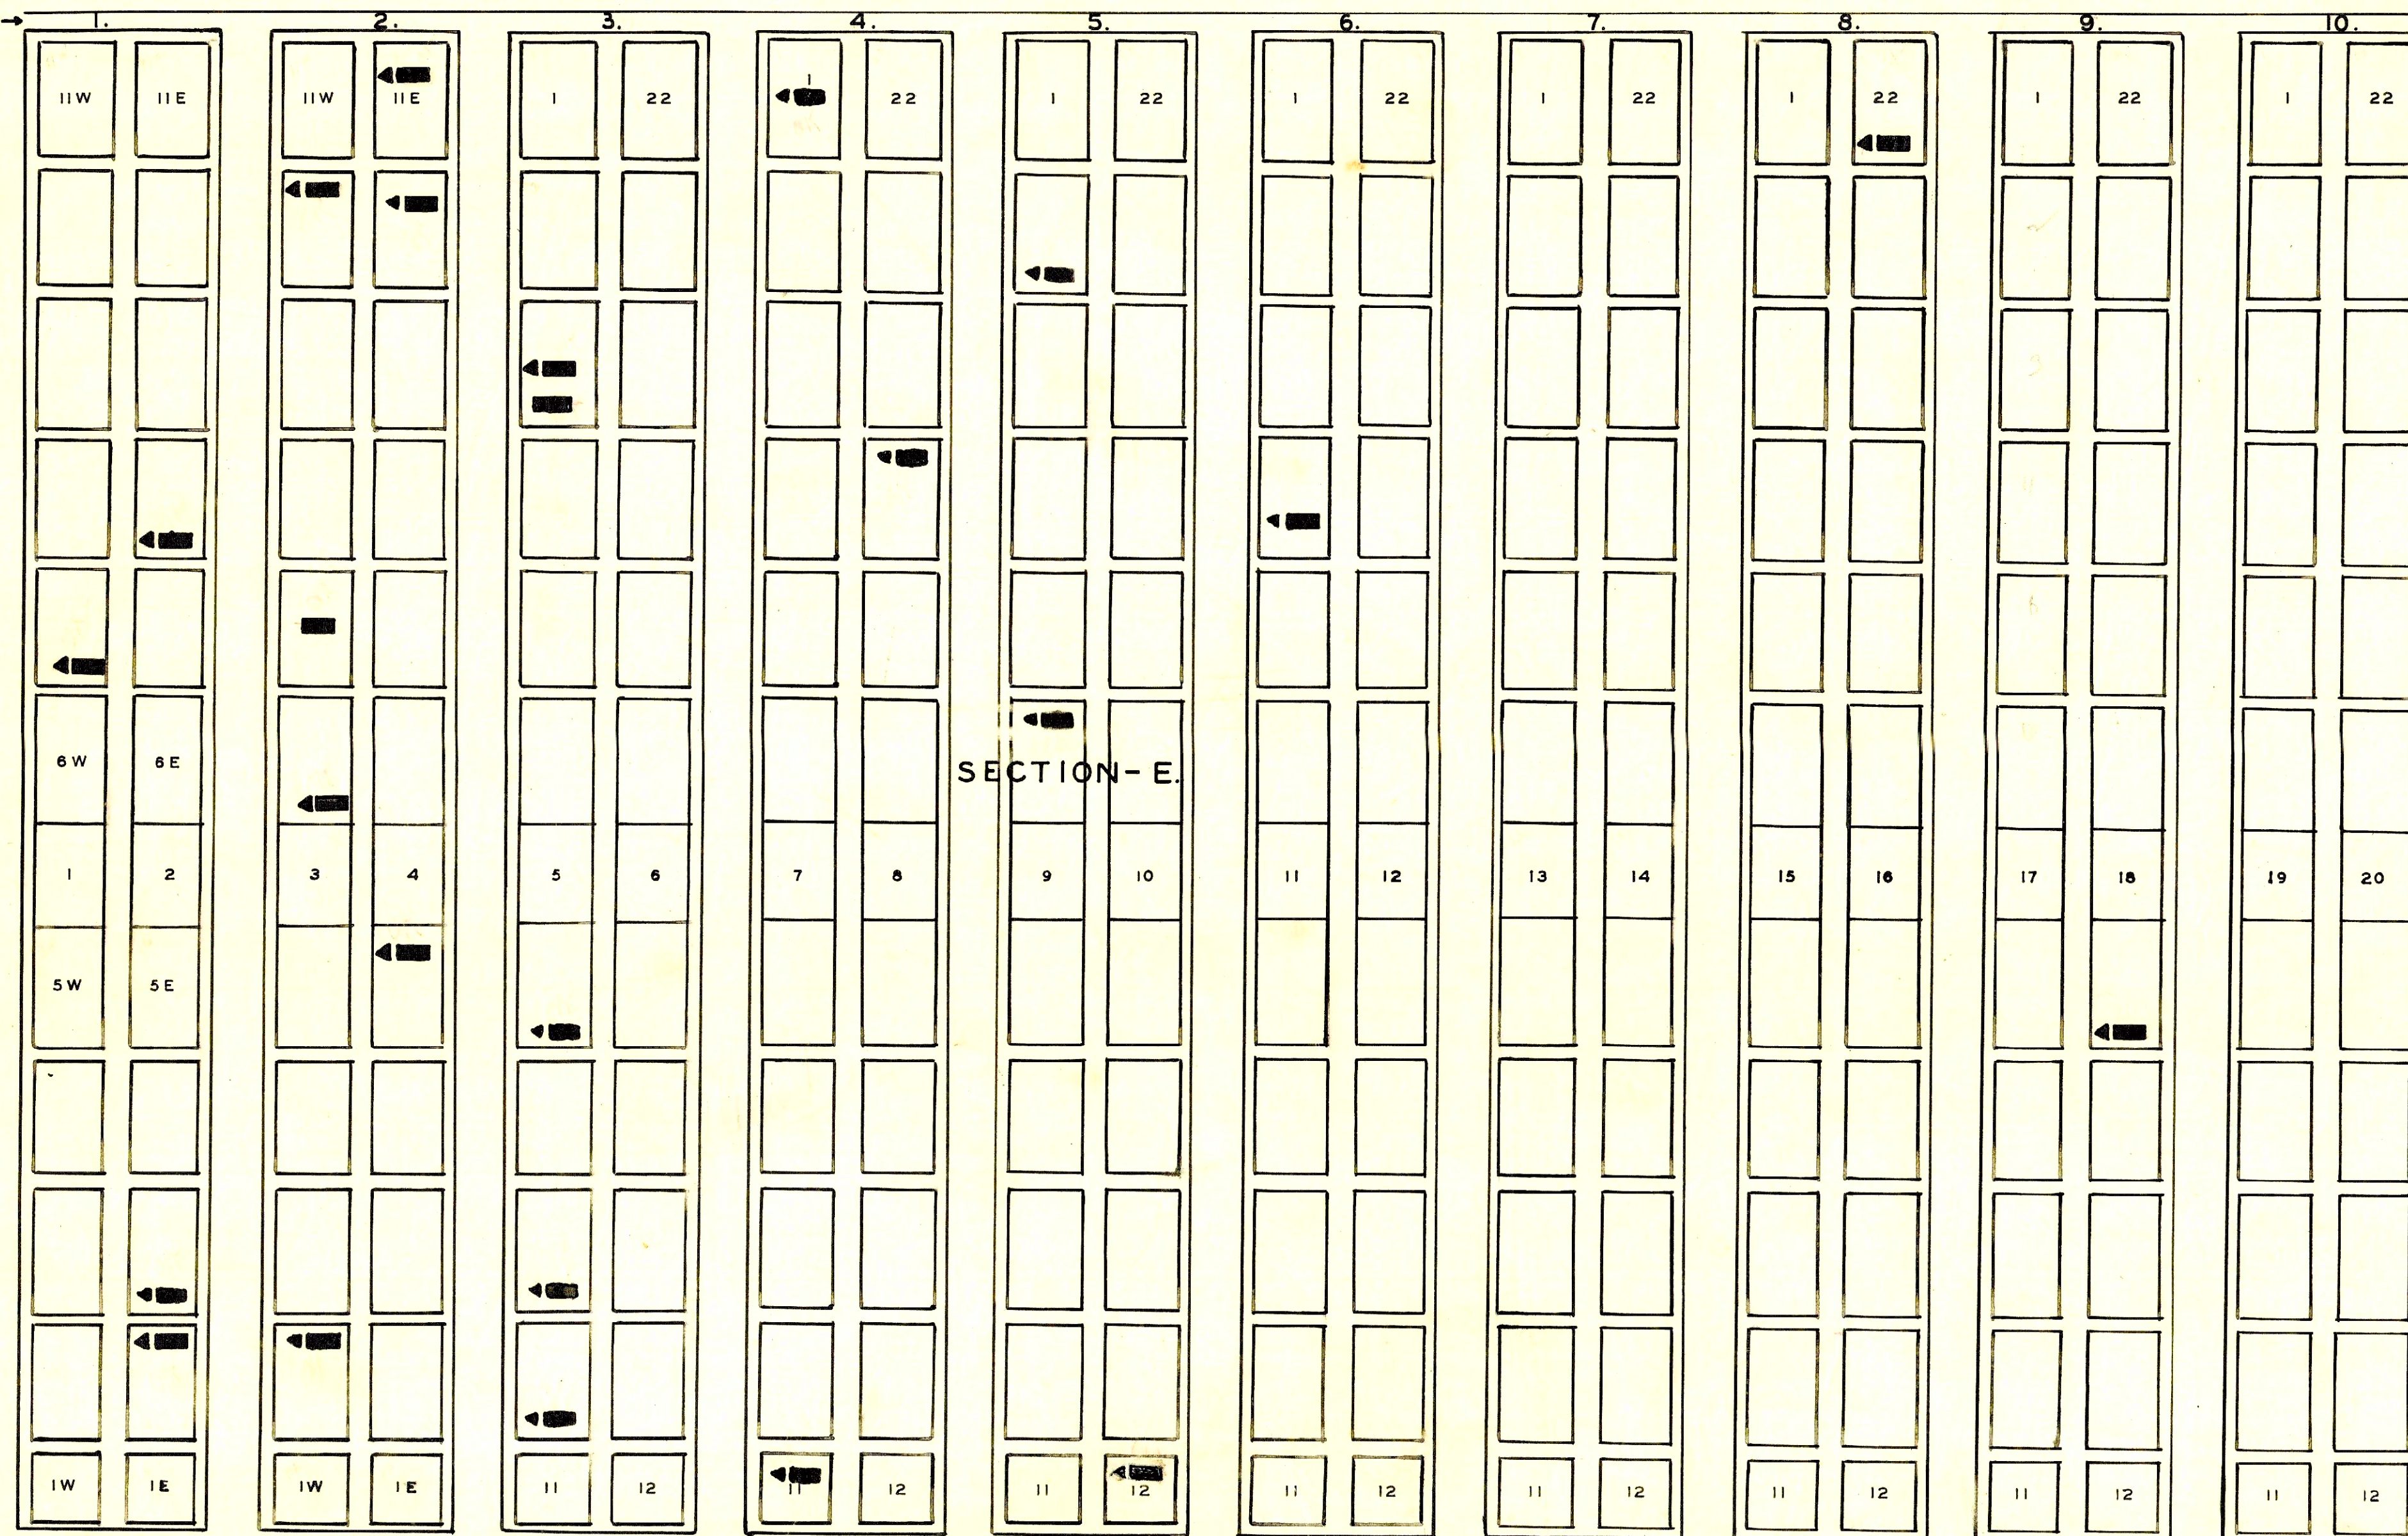


SECTION - E.

RANGES →

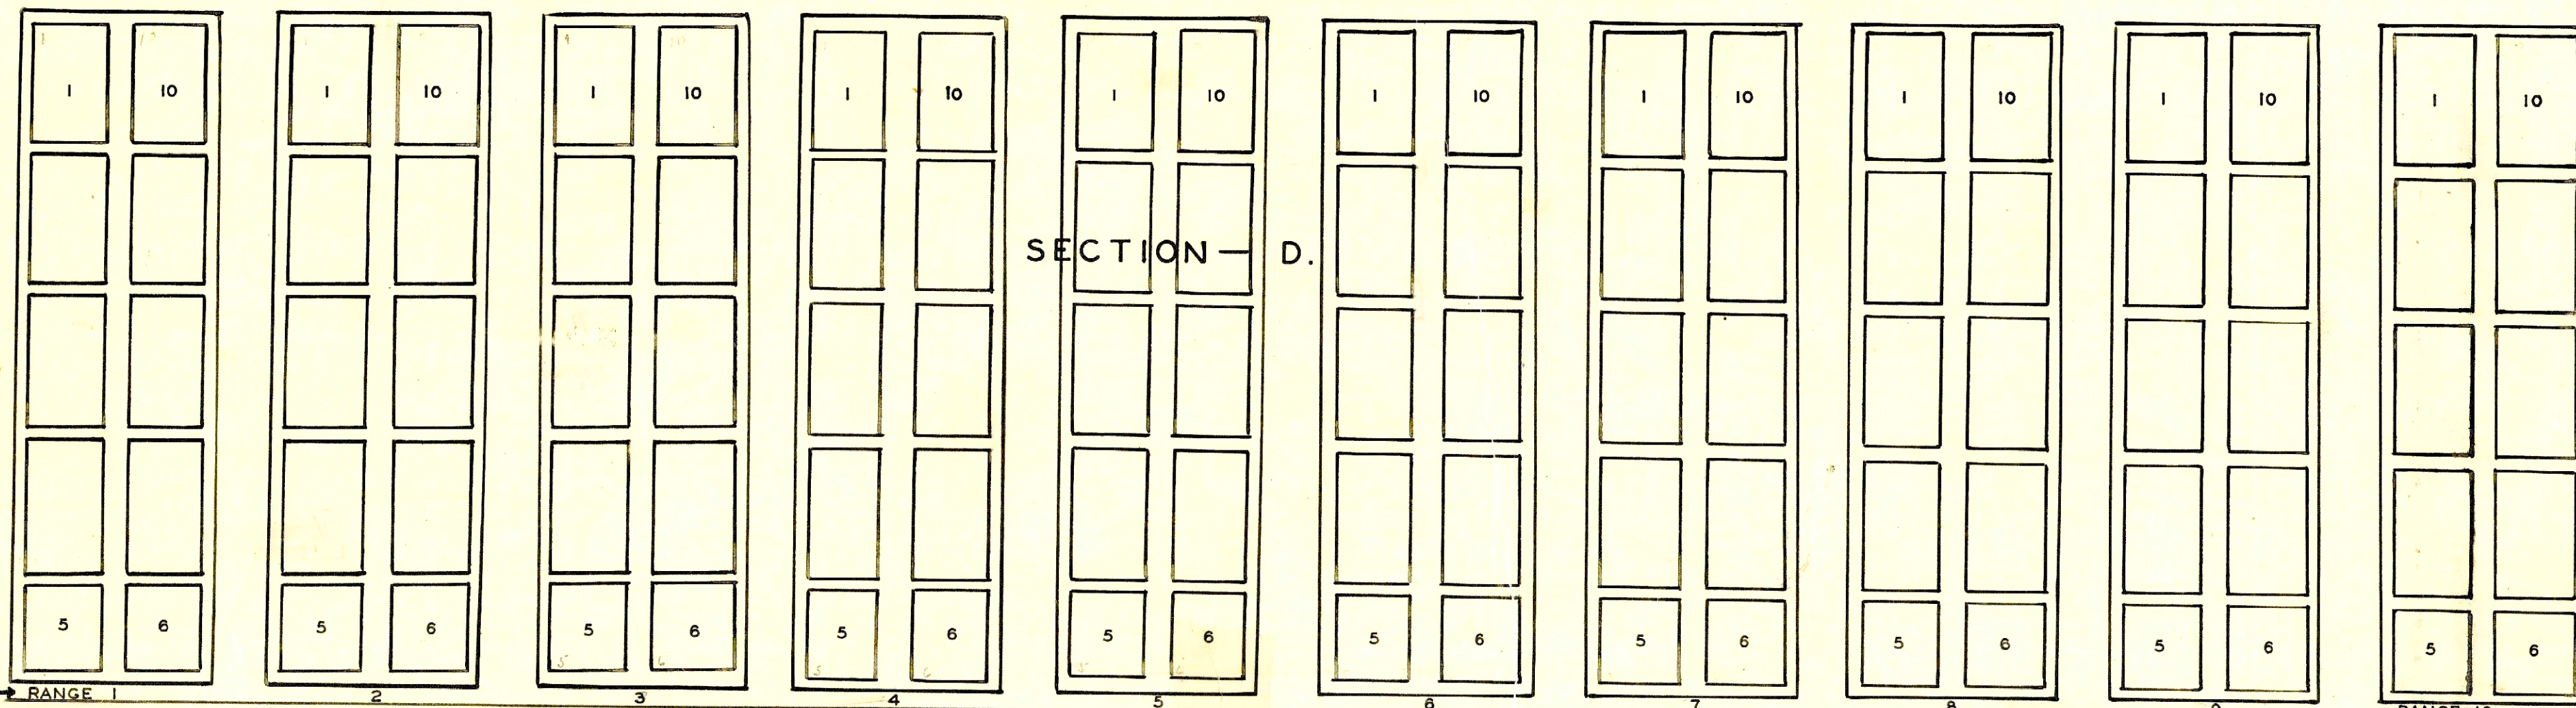

SECTION - D.

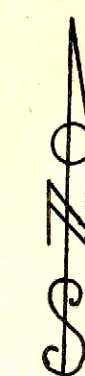

SECTION-RANGE-LOT-GRAVE-WAR- NAME

E.	2.	11.E.	2	19	ARNOLD. GEORGE
E.	5	12	3	19	BAIRD. WILLIAM
E.	2	2W.	2	22	BRINK. HAROLD. S.
E.	2	62-GW	1	19	CARPENTER. JAMES.
O	0	0	0	19	CHRISTOPHER. ALBERT.
E.	6	4	2.	19	CHRISTOPHER. JOSEPH.
E.	2	10.E	1	19	COMSTOCK. CYRUS. C.
E.	3	9	1	19	DAVENPORT. AARON.
E.	1E	7W	1	19	DUNCAN. JAS. E.
E.	1	3E.	1	19	DUNCAN. JOHN. C.
E.	4	11	3	19	HUMMEL. ISAAC. D.
E.	3	3	3	19	JOHNSON. WILLIAM. L.
E.	1	2.E.	3	19	LOWE. JOHN.
E.	2	10W.	2.	19	MC. KELVEY. JOHN.
E.	4	19	1	19	MULLETT. GEORGE. W.
E.	1	8.E.	1	19	PYERS. ISAAC.
E.	8	22	1	19	RINEHARD. JAS. M.
E.	3	10	1	19	SCHRIEBER. JOHN. C.
E.	2	5	2	19	SHETLER. WALTER. S.
E.	5	6	1	19	SONDLES. LAFAYETTE.
E.	3	7	3	19	THACKER. ISAAC.
E.	4	1	3	19	THOMPSON. C. C.
E.	5	2	1	19	WOOD. BENJAMIN.
E.	2	7.W.	1	19	UNKNOWN.
E.	3	4	1	19	UNKNOWN.
E.	9	16	3	19	CARPENTER JOHN

N^o 36

OAK HILL KILLBUCK
CEMETERY
 HOLMES CO. KILLBUCK TWP.
 OFFICIAL PROJECT NOS. 465-42-3-467
 665-42-3-232

LEGEND	HISTORY
① REVOLUTIONARY WAR.	PART OF ORIGINAL
⑩ WAR OF 1812.	U.S. MILITARY GRANT.
⑬ WAR WITH MEXICO.	CEM. ESTABLISHED
⑭ CIVIL WAR.	ABOUT 1882.
⑳ SPANISH-AM. WAR.	
㉑ WORLD WAR.	
SCALE 20" = 1"	3.7 ACRES